

APP 9/20/78

9/22/78
9:30 a.m.
9/23/78
a.m. if possible

PERMIT

P 28633

A REPAIR.

SEWAGE DISPOSAL SYSTEM

MARYLAND STATE DEPARTMENT OF HEALTH*

HOWARD COUNTY

ELLICOTT CITY

INDEXED

DISTRICT _____

DATE 8/4/78

Donald Parlette

IS PERMITTED TO INSTALL _____ ALTER X

ADDRESS _____ PHONE _____

SUBDIVISION _____ ROAD 13785 Brighton Dam Road LOT _____

PROPERTY OWNER Puglisi, Charles

ADDRESS 13785 Brighton Dam Road, Clarksville, Md.

SPECIFICATIONS 4 bedrooms DRY WELL OR DITCH TO START AT HOLE ① LOCATED 83 FT. BEHIND THE HOUSE

SEPTIC TANK CAPACITY 1250 GALLONS

DRAIN FIELD _____ DEPTH _____ FEET, BOTTOM AREA _____ SQ. FT.

DEEP TRENCH 1' DEPTH 13 FEET, BOTTOM AREA 480 SQ. FT. & 70 FT FROM THE TELEPHONE POLE NEAR THE SHED

SEEPAGE PITS 480 ABSORBENT SIDE-WALL AREA _____ SQ. FT.

INLET PIPE 3 FT. BELOW ORIGINAL GRADE. MAXIMUM DEPTH 13 1/2 FT. BELOW ORIGINAL GRADE

EFFECTIVE DEPTH AT _____ FT. BELOW ORIGINAL GRADE.

LOCATE DISPOSAL AREA _____ FT. FROM _____ LOT LINE AND _____ FT. FROM _____ LOT LINE AS SEEN WHEN

FACING LOT FROM DRY WELL & DITCH COMBINATION OR ALSO

REPAIR-CALL FOR INSPECTION WHEN GROUND IS OPENED UP SO SANITARIAN CAN

RECOMMEND REPAIR. 8/22/78 DRY WELL 480 SQ FT SIDEWALL

AREA BELOW INLET DRYWELL IN LET TO BE NO DEEPER THAN 3 FT & BOTTOM TO BE 13 1/2 FT OR DITCH

PLANS APPROVED BY Palmer F. Wine DATE 8/4/78

COVER NO WORK UNTIL INSPECTED AND APPROVED.

NEITHER THE HOWARD COUNTY COUNCIL NOR THE HEALTH DEPARTMENT IS RESPONSIBLE FOR THE SUCCESSFUL OPERATION OF ANY SYSTEM.

NOTE: IF TRENCH IS USED CALL FOR INSPECTION BEFORE PLACING GRAVEL IN TRENCH. permit for addition signed 11/6/78

NOTE: NO DRY WELL SHALL EXCEED 15 FOOT IN DIAMETER.

NOTE: ALL PIPE FROM HOUSE TO DISPOSAL AREA MUST BE CAST IRON. # 37715


PERMIT VOID AFTER THREE YEARS.

NOTE: INSTALL STAND PIPE ON SEPTIC TANK AND DRY WELL. STAND PIPES MUST BE 6 INCHES IN DIAMETER. CAST IRON, CONCRETE OR TERRA COTTA ACCEPTED.

*INSTALLER IS RESPONSIBLE FOR OBTAINING FINAL APPROVAL ON THIS PERMIT.

HD. 23 480 SQ FT SIDEWALL AREA, DITCH TO BE 13 FT DEEP 2 FT WIDE FILLED WITH 10 FT OF STONE, DITCH TO BE 50 FT LONG

P 28633

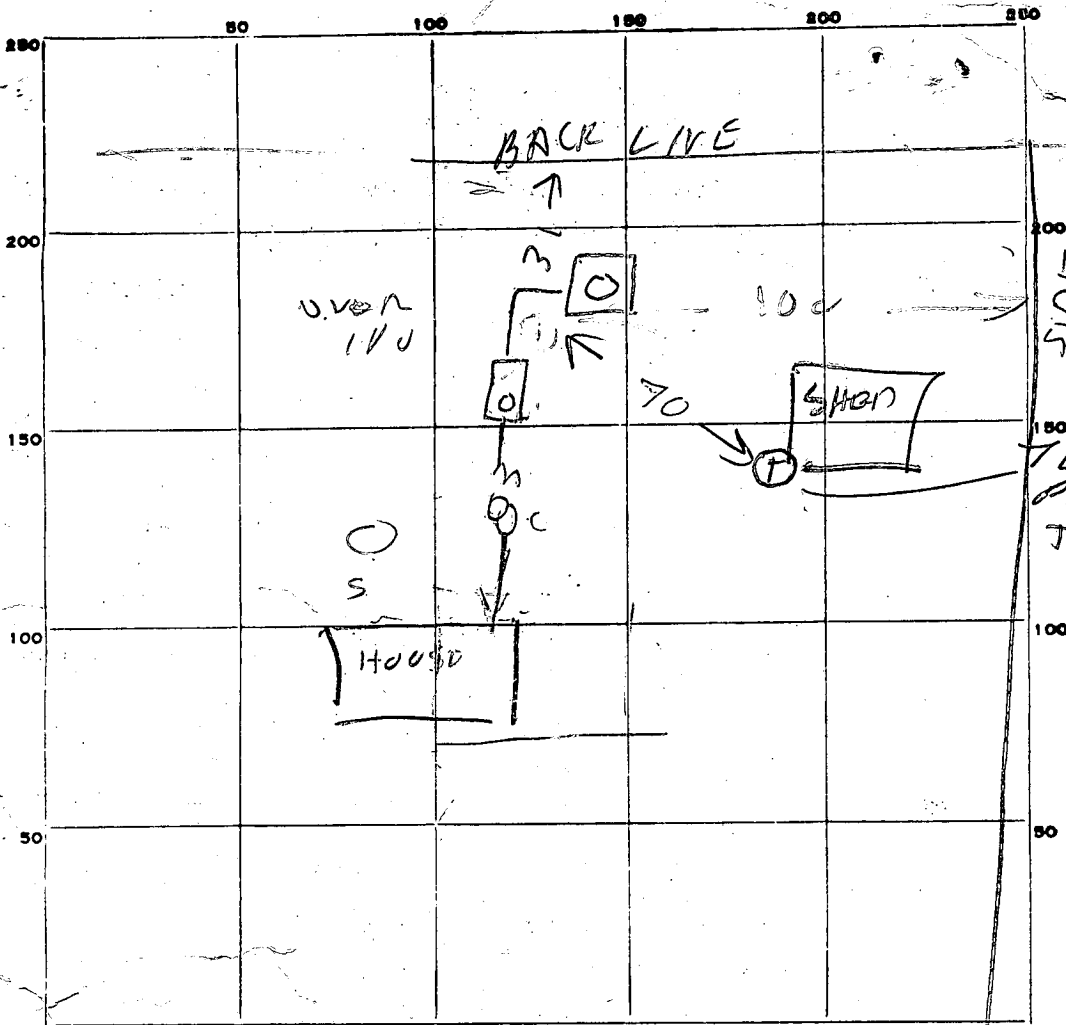

INDICATE NORTH. - NAME ADJOINING ROADWAY AS BASE LINE.

25
13
13 1/2
57

42
13
55
8
25

SIDE

TELEPHONE POLE NEXT TO SHED

PERMIT CARD

SEPTIC TANK, LEVEL CLEANOUTS

DISTRIBUTION BOX, LEVEL _____

TILE FIELD, DEPTH _____ FT. TRENCH WIDTH _____ FT.

GRAVEL DEPTH _____ IN. TOTAL LENGTH _____ FT.

NUMBER OF TRENCHES _____ TOTAL BOTTOM AREA _____

SEEPAGE PITS, ^{Perimeter} INSIDE DIAMETER 55 FT. DEPTH BELOW INLET 8 1/2 FT.

ABSORBENT AREA 480 SQ. FT.

REMARKS 8/22/78 Hole ① 13 1/2 FT deep Top 2 FT CLAY BOT 11 1/2 SAND
all cast iron pipe

DATE SYSTEM APPROVED 9/20/78 INSPECTOR J.S. & J.L.

BRINGTON DAM ROAD

N 86° 35' 00" E

100.50' 1st LINE
703/56

15.00'

I.P. FOUND

EXISTING DRIVEWAY

390.75'

860.75'

P 10 9th LINE 703/56

S 29° 39' 47" E - 426.47'

8/21/80
B-24485
Permit
OK'd
by R.R.

NEW LINE OF DIVISION
513.92'

I.P. SET

NEW LINE OF DIVISION

S 48° 55' 00" W

I.P. SET

SEPTIC TANK

DEY WELL

NEW ADDITION

EXISTING HOUSE

NEW ENTRANCE

EXISTING GARAGE

DISTURBED AREA
± 1,100 SQ. FT.

EXISTING PRIVATE WATER
EXISTING PRIVATE SEWER

SITE AREA 1.637 ACRES
PARCEL 128 BLOCK 13 LOT 1
LIBER L-297 FOLIO f228
ELECTION DISTRICT 5

SITE PLAN

1" = 50'-0" SCALE