

9/2/78

Final OK  
DPOA 9/6/78

# PERMIT

P 28791  
A Repair

SEWAGE DISPOSAL SYSTEM

MARYLAND STATE DEPARTMENT OF HEALTH\*

HOWARD COUNTY

ELLCOTT CITY

DISTRICT 5th

INDEXED

DATE 9/1/78

Mr. Gaffigan IS PERMITTED TO INSTALL ALTER

ADDRESS 13183 Route 108, Highland, Md. 20777 PHONE 286-3882

SUBDIVISION ROAD 13183 Route 108 LOT

PROPERTY OWNER Mr. Gaffigan

ADDRESS same as above

SPECIFICATIONS

SEPTIC TANK CAPACITY \_\_\_\_\_ GALLONS

DRAIN FIELD \_\_\_\_\_ DEPTH \_\_\_\_\_ FEET, BOTTOM AREA \_\_\_\_\_ SQ. FT.

DEEP TRENCH \_\_\_\_\_ DEPTH \_\_\_\_\_ FEET, BOTTOM AREA \_\_\_\_\_ SQ. FT.

SEEPAGE PITS \_\_\_\_\_ ABSORBENT SIDE-WALL AREA \_\_\_\_\_ SQ. FT.

INLET PIPE \_\_\_\_\_ FT. BELOW ORIGINAL GRADE. MAXIMUM DEPTH \_\_\_\_\_ FT. BELOW ORIGINAL GRADE

EFFECTIVE DEPTH AT \_\_\_\_\_ FT. BELOW ORIGINAL GRADE.

LOCATE DISPOSAL AREA \_\_\_\_\_ FT. FROM \_\_\_\_\_ LOT LINE AND \_\_\_\_\_ FT. FROM \_\_\_\_\_ LOT LINE AS SEEN WHEN FACING LOT FROM

REPAIR - Call for an appointment when ground is opened up and Sanitarian will

recommend repair system. Pit 6' wide, 20' long, 6' deep 4' stone.  
 Told Mrs Gaffigan to begin work in Am, keep working, inspector  
 will stop by about noon. Keep notes on all work.

PLANS APPROVED BY Palmer F. Wine DATE 9/1/78

COVER NO WORK UNTIL INSPECTED AND APPROVED.

NEITHER THE HOWARD COUNTY COUNCIL NOR THE HEALTH DEPARTMENT IS RESPONSIBLE FOR THE SUCCESSFUL OPERATION OF ANY SYSTEM.

NOTE: IF TRENCH IS USED CALL FOR INSPECTION BEFORE PLACING GRAVEL IN TRENCH.

NOTE: NO DRY WELL SHALL EXCEED 15 FOOT IN DIAMETER.



NOTE: ALL PIPE FROM HOUSE TO DISPOSAL AREA MUST BE CAST IRON.

PERMIT VOID AFTER THREE YEARS.

NOTE: INSTALL STAND PIPE ON SEPTIC TANK AND DRY WELL. STAND PIPES MUST BE 6 INCHES IN DIAMETER. CAST IRON, CONCRETE OR TERRA COTTA ACCEPTED.

\*INSTALLER IS RESPONSIBLE FOR OBTAINING FINAL APPROVAL ON THIS PERMIT.

28791

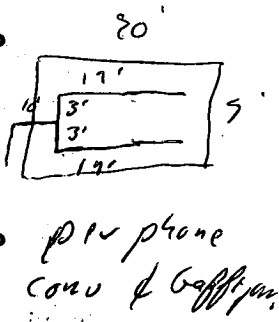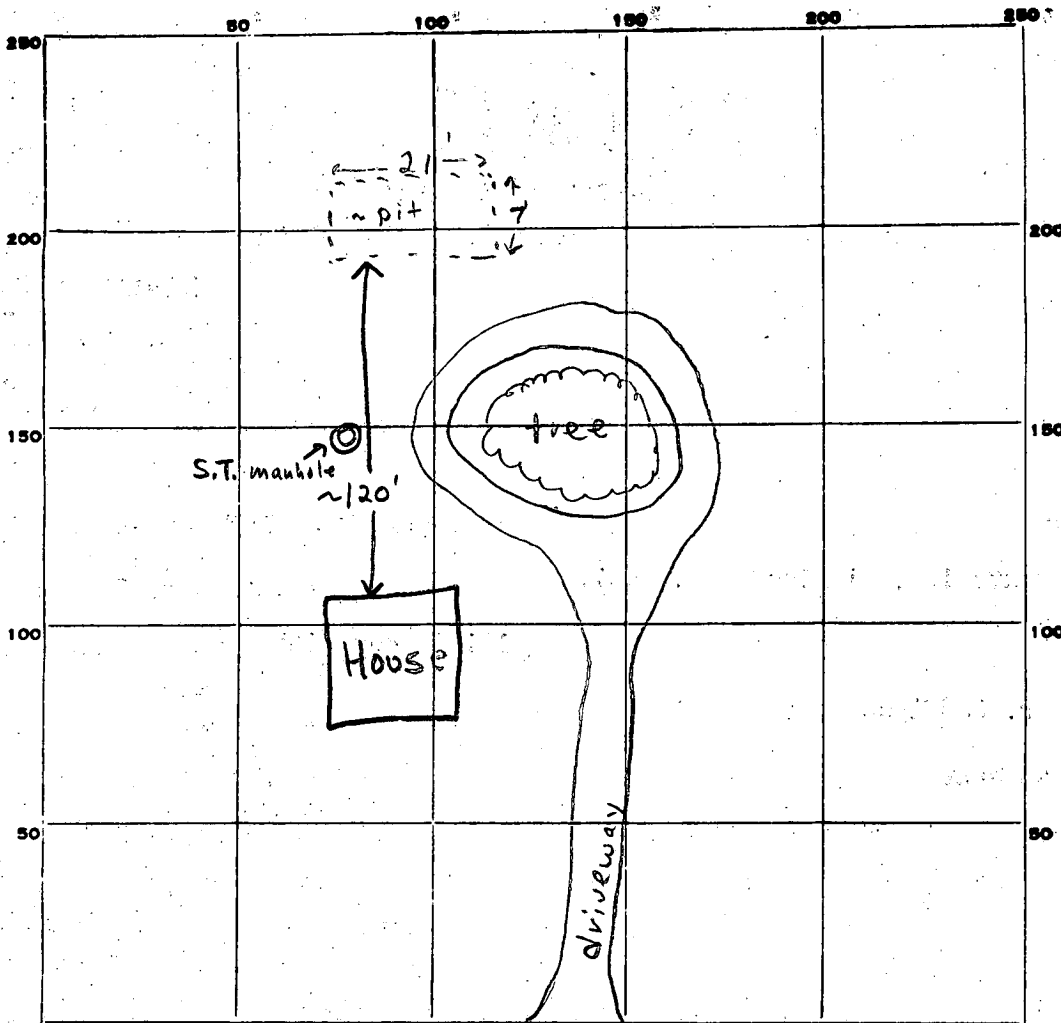

phone  
conv of Gaffigan

INDICATE NORTH. - NAME ADJOINING ROADWAY AS BASE LINE.

Rte 108

PERMIT CARD Signal ok & work complete

Gaffigan will send sketches etc.

SEPTIC TANK, LEVEL \_\_\_\_\_ CLEANOUTS \_\_\_\_\_

DISTRIBUTION BOX, LEVEL \_\_\_\_\_

TILE FIELD, DEPTH \_\_\_\_\_ FT. TRENCH WIDTH \_\_\_\_\_ FT.

GRAVEL DEPTH \_\_\_\_\_ IN. TOTAL LENGTH \_\_\_\_\_ FT.

NUMBER OF TRENCHES \_\_\_\_\_ TOTAL BOTTOM AREA \_\_\_\_\_

SEEPAGE PITS, INSIDE DIAMETER \_\_\_\_\_ FT. DEPTH BELOW INLET \_\_\_\_\_ FT.

ABSORBENT AREA \_\_\_\_\_ SQ. FT.

REMARKS ~2pm 9/2/78 Visited site; system has been covered over, spoke to Mr. & Mrs. Gaffigan who said that pit was 7'8" wide and ~21' long and 10ft. deep inlet 3-4' ± ~6' gravel under pipe G. Skinner I informed Ms Gaffigan 9/1/78 that work might begin in Aug 9/2/78 and continue. System repaired, but Not Inspector Reported design is within my specifications DPOA

DATE SYSTEM APPROVED DPOA - 9/6/78 INSPECTOR Paul Potter