

app 10-31-78  
19

~~10/11/78~~  
~~the afternoon~~  
~~hand~~

# PERMIT

P 28917

A Repair

SEWAGE DISPOSAL SYSTEM

MARYLAND STATE DEPARTMENT OF HEALTH\*

HOWARD COUNTY

02-8219514

ELLICOTT CITY

DISTRICT 2nd

10/30/78

INDEXED

DATE 9/25/78

Ohler Plumbing & Heating

IS PERMITTED TO INSTALL ALTER X

ADDRESS 2100 Sulphur Spring Rd., Balto., Md. 21227 PHONE 242-5325

SUBDIVISION \_\_\_\_\_ ROAD 4655 New Cut Road LOT \_\_\_\_\_  
LEFT

PROPERTY OWNER Joseph Igler

ADDRESS New Cut Road, Ellicott City, Md. 21043

SPECIFICATIONS 3 bedrooms

SEPTIC TANK CAPACITY 1000 GALLONS

16FA

DRAIN FIELD \_\_\_\_\_ DEPTH \_\_\_\_\_ FEET, BOTTOM AREA \_\_\_\_\_ SQ. FT.

DEEP TRENCH \_\_\_\_\_ DEPTH \_\_\_\_\_ FEET, BOTTOM AREA \_\_\_\_\_ SQ. FT.

SEEPAGE PITS \_\_\_\_\_ ABSORBENT SIDE-WALL AREA \_\_\_\_\_ SQ. FT.

INLET PIPE \_\_\_\_\_ FT. BELOW ORIGINAL GRADE. MAXIMUM DEPTH \_\_\_\_\_ FT. BELOW ORIGINAL GRADE

EFFECTIVE DEPTH AT \_\_\_\_\_ FT. BELOW ORIGINAL GRADE.

LOCATE DISPOSAL AREA \_\_\_\_\_ FT. FROM \_\_\_\_\_ LOT LINE AND \_\_\_\_\_ FT. FROM \_\_\_\_\_ LOT LINE AS SEEN WHEN  
FACING LOT FROM

Construct a trench with an inlet at 4 ft. and a maximum depth of 12 ft. below original grade. Begin trench in vicinity of perchole nearest house and follow contour, keeping bottom of trench level. Trench shall be 75 ft. in length and have 8 ft. of stone.

CALL FOR INSPECTION OF TRENCH BEFORE ADDING STONE.

PLANS APPROVED BY Thomas S. Ogle DATE 4/14/78

COVER NO WORK UNTIL INSPECTED AND APPROVED.

NEITHER THE HOWARD COUNTY COUNCIL NOR THE HEALTH DEPARTMENT IS RESPONSIBLE FOR THE SUCCESSFUL OPERATION OF ANY SYSTEM.

NOTE: IF TRENCH IS USED CALL FOR INSPECTION BEFORE PLACING GRAVEL IN TRENCH.

NOTE: NO DRY WELL SHALL EXCEED 15 FOOT IN DIAMETER.

NOTE: ALL PIPE FROM HOUSE TO DISPOSAL AREA MUST BE CAST IRON.


PERMIT VOID AFTER THREE YEARS.

NOTE: INSTALL STAND PIPE ON SEPTIC TANK AND DRY WELL. STAND PIPES MUST BE 6 INCHES IN DIAMETER. CAST IRON, CONCRETE OR TERRAZZO ACCEPTED.

BLDG. PERMIT SIGNED  
AND RETURNED 4/5/79  
Serial No. 38847  
Adding bathroom

\*INSTALLER IS RESPONSIBLE FOR OBTAINING FINAL APPROVAL ON THIS PERMIT.

P 28917

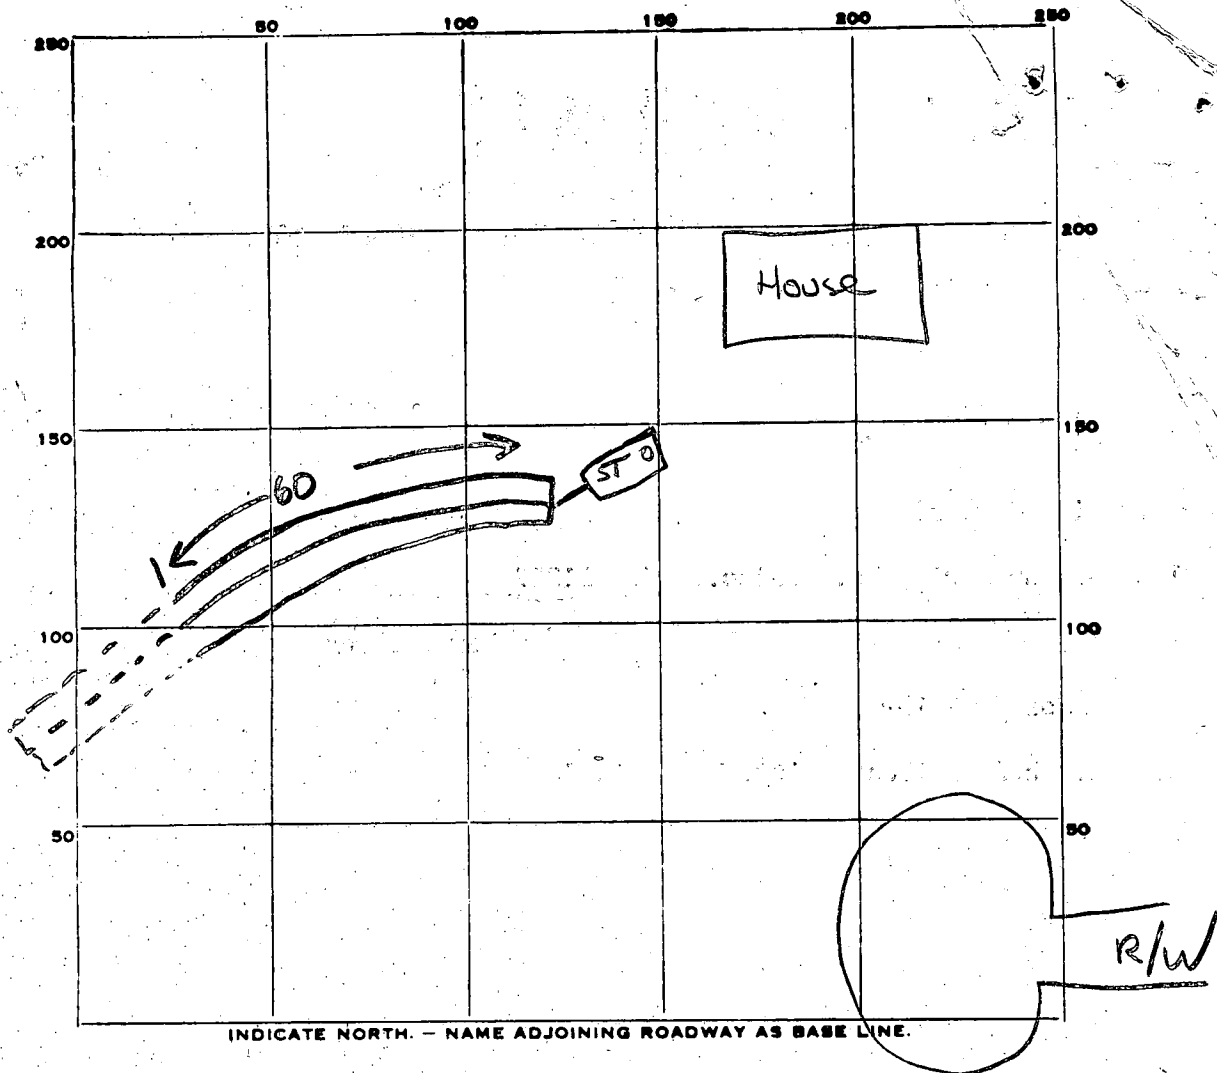

PERMIT CARD \_\_\_\_\_

SEPTIC TANK, LEVEL  \_\_\_\_\_

CLEANOUTS  \_\_\_\_\_ CAST IRON

DISTRIBUTION BOX, LEVEL Na \_\_\_\_\_

TILE FIELD, DEPTH 12 FT. TRENCH WIDTH 2 FT.

GRAVEL DEPTH 12 TOTAL LENGTH +60 FT.

NUMBER OF TRENCHES 1 TOTAL BOTTOM AREA \_\_\_\_\_

SEEPAGE PITS, INSIDE DIAMETER \_\_\_\_\_ FT. DEPTH BELOW INLET \_\_\_\_\_ FT.

ABSORBENT AREA \_\_\_\_\_ SQ. FT.

REMARKS 110d78 - 60' of 75' was excavated on arrival at 4:00. Owner will certify remaining 15' of trench. Call when gravel is added + house sewer installed. (GLK) + SS

DATE SYSTEM APPROVED 10/31/78

INSPECTOR AW Money

*Repair Perms*

# APPLICATION

A \_\_\_\_\_  
P \_\_\_\_\_

4/14/78  
1:30 PM

SEWAGE DISPOSAL TESTING  
STATE OF MARYLAND - DEPARTMENT OF HEALTH AND MENTAL HYGIENE

DISTRICT 2nd  
DATE 4/11/78

HOWARD COUNTY HEALTH DEPARTMENT  
ENVIRONMENTAL HEALTH SERVICES  
P. O. BOX 476, ELLICOTT CITY, MARYLAND 21043  
TELEPHONE: 465-5000, EXT. 356

*Install 1000 gallon septic tank & construct a trench with an inlet at 4' and a maximum depth of 12'. Begin trench in vicinity of perc hole nearest house and follow contour, keeping bottom of trench level. Trench shall be 75' in length & have 8' of stone. Call for trench insp. before adding stone.*

TO: THE COUNTY HEALTH OFFICER  
ELLICOTT CITY, MARYLAND

I, HEREBY, APPLY FOR THE NECESSARY TEST IN ORDER TO CONSTRUCT (OR RECONSTRUCT) A SEWAGE DISPOSAL SYSTEM.

PROPERTY OWNER Joseph Ogler

ADDRESS New Cut Road, Ellicott City, Md PHONE \_\_\_\_\_

PROPERTY LOCATION:

SUBDIVISION \_\_\_\_\_ LOT NO. \_\_\_\_\_

ROAD AND DESCRIPTION New Cut Road

SIZE OF LOT \_\_\_\_\_ TYPE BLDG. \_\_\_\_\_ NUMBER OF BEDROOMS \_\_\_\_\_

IF NOT SINGLE RESIDENCE DESCRIBE \_\_\_\_\_

THE SYSTEM INSTALLED UNDER THIS APPLICATION IS ACCEPTABLE ONLY UNTIL PUBLIC FACILITIES BECOME AVAILABLE.

SIGNATURE OF APPLICANT /s/ Joseph Ogler

APPROVED BY T.S. Ogler FOR Septic tank & Trench DATE 4/14/78  
(KIND OF SYSTEM)


REJECTED BY \_\_\_\_\_ FOR \_\_\_\_\_ DATE \_\_\_\_\_  
(KIND OF SYSTEM)

HOLD PENDING FURTHER TESTS \_\_\_\_\_ DATE \_\_\_\_\_

REASONS FOR REJECTION OR HOLDING \_\_\_\_\_

# THIS IS NOT A PERMIT

Dirt Cone

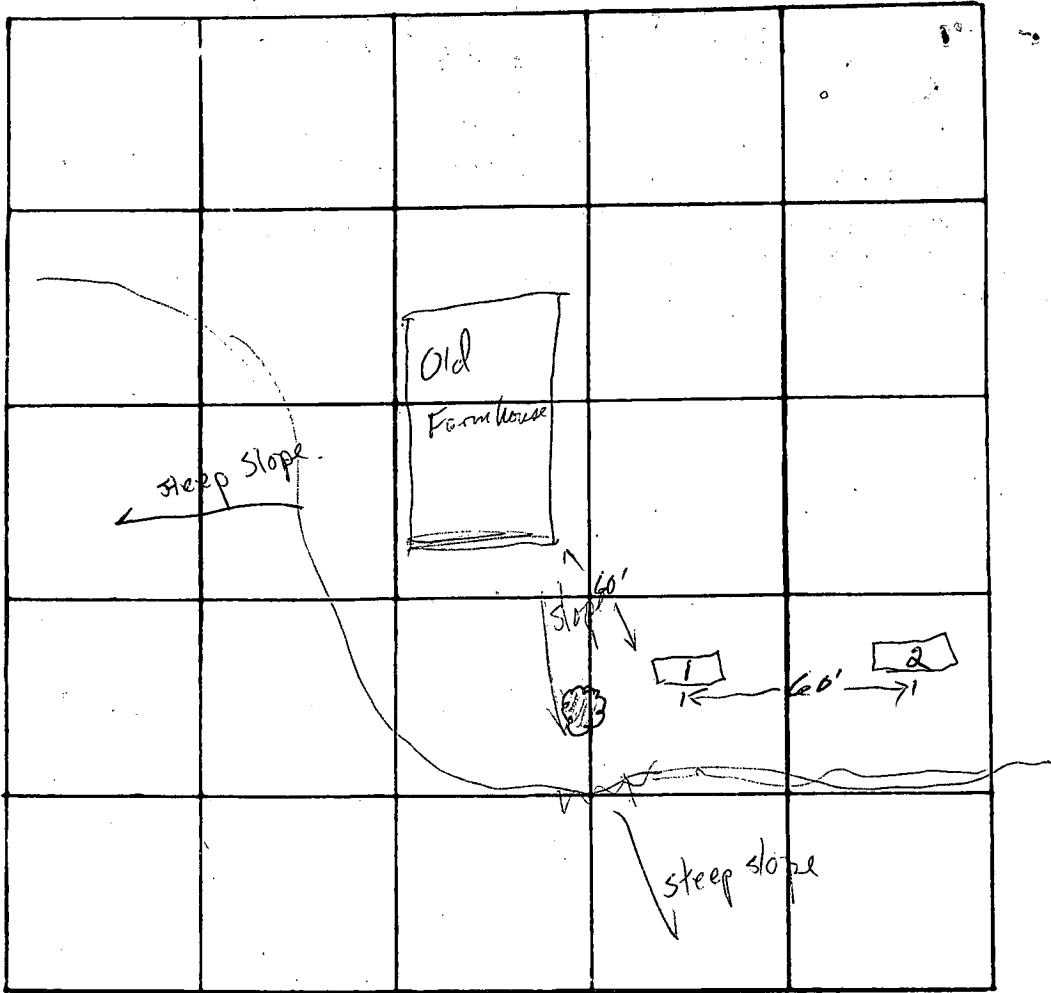

INDICATE NORTH. - NAME ADJOINING ROADWAY AS BASE LINE  
New Cut Road.

DATE	TEST NO.	DEPTH	PRE-WET		TEST - 1" DROP		TIME
			START	STOP	START	STOP	
	1	14 Visual					
	2	7 Visual					

0-4 yellow clay  
4-14 dark clayey micaceous sand - Dry.  
0-4 Less clay  
4-7 dark loam

REMARKS \_\_\_\_\_  
 TYPE OF SOIL \_\_\_\_\_  
 TESTED BY T.S. Oyle ALSO PRESENT: \_\_\_\_\_