

4/30/79

12/4/79

12+1 - will be ready

approved 4/1/80
J. Stayer

PERMIT

P 30257

A 16527

SEWAGE DISPOSAL SYSTEM

MARYLAND STATE DEPARTMENT OF HEALTH

HOWARD COUNTY

ELLCOTT CITY

INDEXED

DISTRICT 3rd.

DATE 10/1/79

Jim Rodgers
Mr. William Slater

IS PERMITTED TO INSTALL ALTER

ADDRESS 940 St. Agnes Lane, Balto., Md. 21207 PHONE 788-3924

SUBDIVISION Woodmark, Inc, ROAD 12250 Etchinson Rd. LOT 5, Block F. Sec 9

PROPERTY OWNER Mr. William Slater

ADDRESS 940 St. Agnes Lane, Balto., Md. 21207 PHONE: 788-3924

SPECIFICATIONS 4 Bedrooms 796-1699

- SEPTIC TANK CAPACITY 1250 GALLONS
- DRAIN FIELD DEPTH FEET, BOTTOM AREA SQ. FT.
- DEEP TRENCH DEPTH FEET, BOTTOM AREA SQ. FT.
- SEEPAGE PITS ABSORBENT SIDE-WALL AREA SQ. FT.
- INLET PIPE FT. BELOW ORIGINAL GRADE. MAXIMUM DEPTH FT. BELOW ORIGINAL GRADE
- EFFECTIVE DEPTH AT FT. BELOW ORIGINAL GRADE.
- LOCATE DISPOSAL AREA FT. FROM LOT LINE AND FT. FROM LOT LINE AS SEEN WHEN FACING LOT FROM

Trench - 85 ft. long - 2 ft. wide - 10 ft. deep. - 7 ft. of stone under pipe. Trench to follow contour of ground and to be inspected before gravel is installed. Begin trench 95 ft. from rear lot line and 20 ft. from left sideline as seen when facing from Etchison Dr. Trench to run towards rear lot line. NOTE: TRENCHES NOT TO BE CONNECTED IN SERIES. MUST USE DISTRIBUTION BOX OR T'S AND CONNECT TO END NEAREST SEPTIC TANK.

PLANS APPROVED BY Donald W. Monaghan DATE 9/28/79

COVER NO WORK UNTIL INSPECTED AND APPROVED.

NEITHER THE HOWARD COUNTY COUNCIL NOR THE HEALTH DEPARTMENT IS RESPONSIBLE FOR THE SUCCESSFUL OPERATION OF ANY SYSTEM.

NOTE: IF TRENCH IS USED CALL FOR INSPECTION BEFORE PLACING GRAVEL IN TRENCH.

NOTE: NO DRY WELL SHALL EXCEED 15 FOOT IN DIAMETER.


NOTE: ALL PIPE FROM HOUSE TO DISPOSAL AREA MUST BE CAST IRON.

PERMIT VOID AFTER THREE YEARS.

NOTE: INSTALL STAND PIPE ON SEPTIC TANK AND DRY WELL. STAND PIPES MUST BE 6 INCHES IN DIAMETER. CAST IRON, CONCRETE OR TERRA COTTA ACCEPTED.

*INSTALLER IS RESPONSIBLE FOR OBTAINING FINAL APPROVAL ON THIS PERMIT.

A 16527

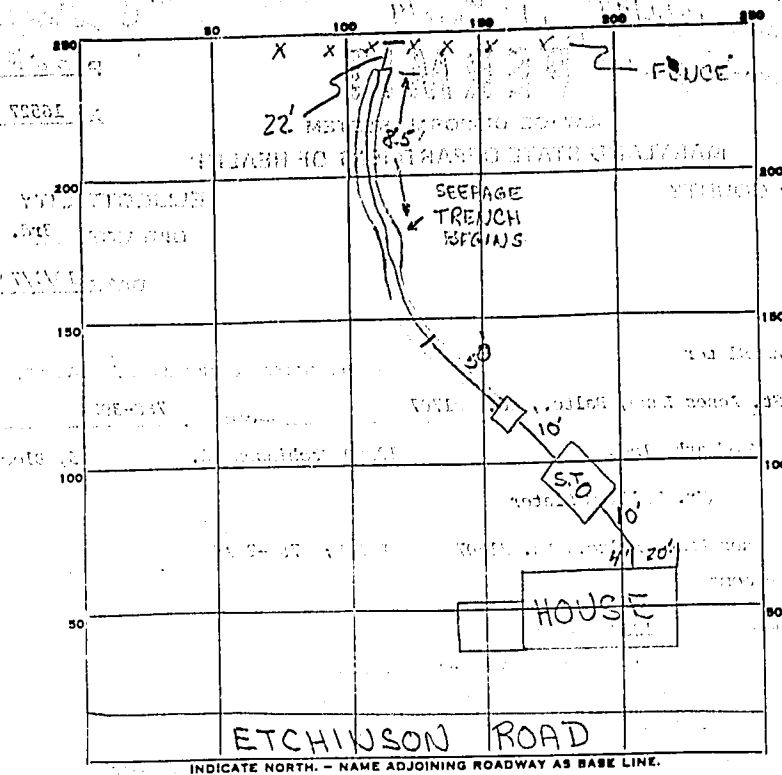

PERMIT CARD _____
 SEPTIC TANK, LEVEL _____ CLEANOUTS ST _____
 DISTRIBUTION BOX, LEVEL _____ CON. CON. _____
 TILE FIELD, DEPTH 10 FT. TRENCH WIDTH 2' FT.
 GRAVEL DEPTH 7 IN. TOTAL LENGTH 85 FT. 85
 NUMBER OF TRENCHES 1 TOTAL BOTTOM AREA 595
 SEEPLAGE PITS, INSIDE DIAMETER _____ FT. DEPTH BELOW INLET _____ FT.
 ABSORBENT AREA 595 SQ. FT.

REMARKS 11/30/79 - NEED C.O. ON SEPTIC TANK RATELY IN DIST. BOX, NO PIPES
ARE CONNECTED INTO DIST. BOX ON SEPTIC TANK, STOPPED WORK. AREA SHORT
TRENCH 2' TOO DEEP. 12/4/79 OK to come, 1.000 to trench.
Call and have gravel added to trench. Job
2/13/80 trench covered without final inspection. Per DM - dig
hub at each end of trench to check gravel. 18. 4/1/80 - letter
sent per DM - verifying gravel depth by Oliver W. Hester Jr.
 DATE SYSTEM APPROVED 4/1/80 INSPECTOR J. [Signature]