

05-346681

PERMIT

SEWAGE DISPOSAL SYSTEM

MARYLAND STATE DEPARTMENT OF HEALTH

PERMIT NO. _____

A 17501

HOWARD COUNTY

ELLICOTT CITY

11/24/78
if not 11/30
11/30/78

INDEXED

DISTRICT 5th

INDEXED

DATE 10/20/78

Mr. Steve Brady IS PERMITTED TO INSTALL ALTER _____

PHONE _____

FROM Clarksville Meadows ROAD 7102 Guilford Road LOT 3

PROPERTY OWNER Rinaboth & Virgil A. Harman

5079 Cherrywood Terrace #102

RESIDENCE 6 bedrooms

SEPTIC TANK CAPACITY 1250 GALLONS

DRAIN FIELD DEPTH _____ FEET. BOTTOM AREA _____ SQ. FT.

DEEP TRENCH DEPTH _____ FEET. BOTTOM AREA _____ SQ. FT.

SEEPAGE PITS ABSORBENT SIDE WALL AREA 240 SQ. FT. per bedroom.

INLET PIPE 3/4 FT. BELOW ORIGINAL GRADE. MAXIMUM DEPTH 114 FT. BELOW ORIGINAL GRADE

EFFECTIVE DEPTH AT _____ FT. BELOW ORIGINAL GRADE.

LOCATE DISPOSAL AREA 121 FT. FROM front LOT LINE AND 50 FT. FROM left LOT LINE AS SEEN WHEN FACING LOT FROM road. (Pore hole 1st).

14 ft. sq. dry well, 30 ft. trench.

Trench only - 100 ft.

APPROVED BY C.B. Stricker DATE 1/17/74

NO WORK UNTIL INSPECTED AND APPROVED

THE HOWARD COUNTY COUNCIL NOR THE HEALTH DEPARTMENT IS RESPONSIBLE FOR THE SUCCESSFUL OPERATION OF ANY SYSTEM.

IF TRENCH IS USED CALL FOR INSPECTION BEFORE PLACING GRAVEL IN TRENCH.

NO DRY WELL SHALL EXCEED 15 FOOT IN DIAMETER

ALL PIPE FROM HOUSE TO DISPOSAL AREA MUST BE CAST IRON.

VOID AFTER THREE YEARS.


INSTALL STAND PIPE ON SEPTIC TANK AND DRY WELL STAND PIPES MUST BE 8 INCHES IN DIAMETER. CAST IRON, CONCRETE OR TERRAZO ACCEPTED.

INSTALLER IS RESPONSIBLE FOR OBTAINING FINAL APPROVAL ON THIS PERMIT.

REG. PERMIT SIGNATURE
AND RETURNED 8-26-99
Serial # B712 0144
dick

A 17501

29086

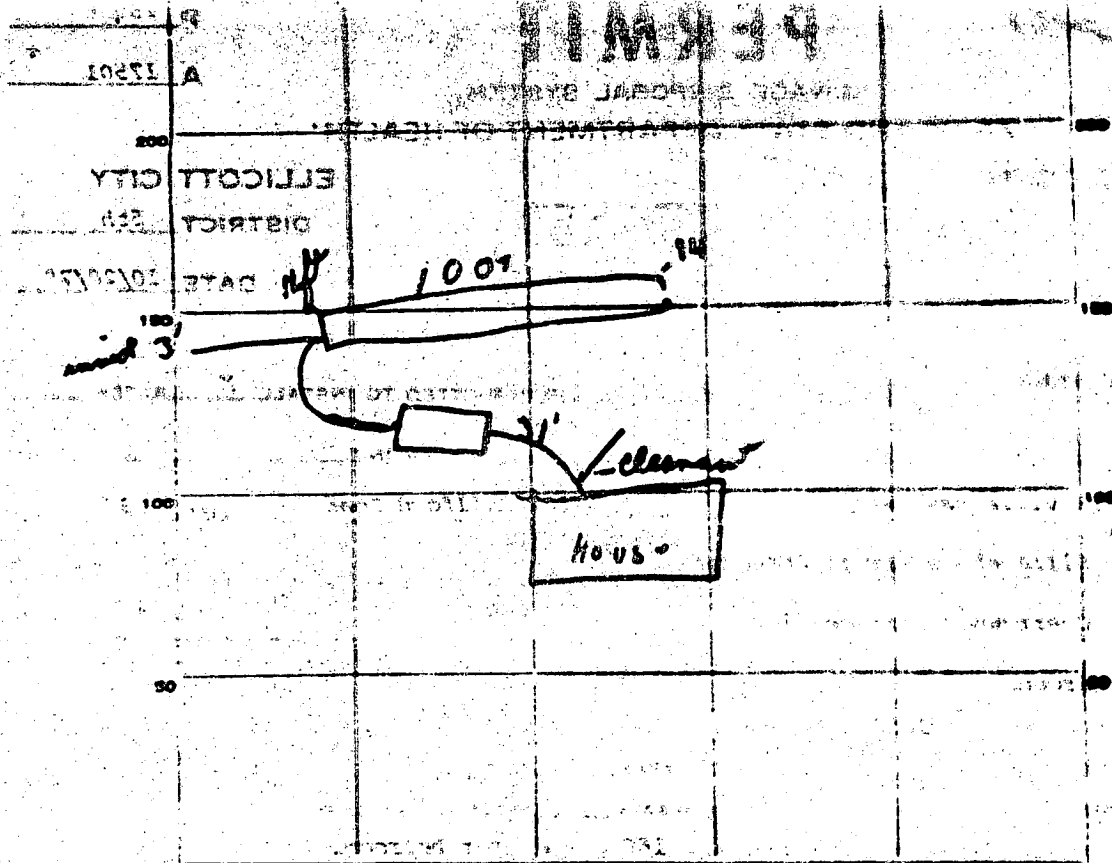

PERMIT CARD NO yes

SEPTIC TANK LEVEL OK

CLEANOUTS take trench to final grade level

DISTRIBUTION BOX LEVEL _____

TILE FIELD DEPTH _____ FT. TRENCH WIDTH _____ FT.

GRAVEL DEPTH _____ IN. TOTAL LENGTH _____ FT.

NUMBER OF TRENCHES _____ TOTAL BOTTOM AREA _____

SEEPAGE PITS, INSIDE DIAMETER _____ FT. DEPTH BELOW INLET _____ FT.

ABSORBENT AREA _____ SQ. FT.

REMARKS ~~to be installed to day... 10' trench... 10' trench~~

11-30-78 Care in 3, 3ft fall top of gravel Earl Carter vice
per note attached

DATE SYSTEM APPROVED 12-4-78

INSPECTOR [Signature]

SEWAGE DISPOSAL TESTING
MARYLAND STATE DEPARTMENT OF HEALTH
HOWARD COUNTY

ELLCOTT CITY
DISTRICT 5th
DATE Aug 29

TO: THE COUNTY HEALTH OFFICER
ELLCOTT CITY, MARYLAND

I, HEREBY, APPLY FOR THE NECESSARY TESTS IN ORDER TO CONSTRUCT (OR RECONSTRUCT) A SEWAGE DISPOSAL SYSTEM.

PROPERTY OWNER Firas Org. Ltd.

ADDRESS Widow Life Center, Columbia, MD PHONE 730-8200

PROPERTY LOCATION:

SUBDIVISION Adjacent to Clarksville Ridge LOT NO. 3

ROAD AND DESCRIPTION Intersection Rt 32 & Whitgate Lane

OCCUPANT _____ PHONE _____

PERSON TO CONSTRUCT SYSTEM _____

ADDRESS _____ PHONE _____

SIZE OF LOT 3 acres + TYPE BLDG. 4 Bedroom Res.
NUMBER OF BEDROOMS

IF NOT SINGLE RESIDENCE DESCRIBE _____

SIGNATURE OF APPLICANT

Alan C. Borg
Alan C. Borg, Pres.

APPROVED BY _____ FOR _____ DATE _____
(NAME OF SYSTEM)

REJECTED BY _____ FOR _____ DATE _____
(NAME OF SYSTEM)

HOLD PENDING FURTHER TESTS _____ DATE _____

REASONS FOR REJECTION OR HOLDING _____

THIS IS NOT A PERMIT

ROUTE 3E

N65°45'10"E 172.72'

ARCADE (100'x120')

ELEV 107

SHADE RESTRICTION LINE

BASELINE ELEV. 100'
FIRST POINT ELEV. 108'

3.006 Acres ±

PERC AREA
100'

NOTES:

A - INV. 107'

B - INV. 108'

C - INV. 109'
ELEV. 110'

321.72'

490.70'

M. 00.12.00 S

N 01° 21' 00" E

5' UTILITY EASEMENT

PROPERTY OF
THAYER

320'

N 82° 06' 40" W

