

APPLICATION

A 14223

P _____

SEWAGE DISPOSAL TESTING

MARYLAND STATE DEPARTMENT OF HEALTH

HOWARD COUNTY

3BR 4BR

ELLICOTT CITY

1000 Gal Tank

1100 Gal Tank

DISTRICT 3

Dry Well - 100 sq. ft. absorbent sidewalk area per bedroom DATE 1/17/69

to begin below the inlet. Maximum depth permitted for dry well is 9 1/2 ft. below original grade. Locate dry well 80 ft. off right sidewalk and 150 ft. off front property line as seen from Evergreen Way.

TO: THE COUNTY HEALTH OFFICER
ELLICOTT CITY, MARYLAND

I, HEREBY, APPLY FOR THE NECESSARY TESTS IN ORDER TO CONSTRUCT (OR RECONSTRUCT) A SEWAGE DISPOSAL SYSTEM.

PROPERTY OWNER Hudson Construction Co., Inc.

ADDRESS 6457 363 Chapel Avenue, Ellicott City, Md. PHONE HO 5-2205

PROPERTY LOCATION:

SUBDIVISION Evergreen Valley Estates LOT NO. 21, Sec. 6

ROAD AND DESCRIPTION 3222 Evergreen Way

OCCUPANT _____ PHONE _____

PERSON TO CONSTRUCT SYSTEM _____

ADDRESS _____ PHONE _____

SIZE OF LOT 100' x 320' x 205' x 380' TYPE BLDG. 3 BR/1
NUMBER OF BEDROOMS

IF NOT SINGLE RESIDENCE DESCRIBE _____

SIGNATURE OF APPLICANT /s/ Madeline Leonardi


✓ APPROVED BY Robert Tone FOR Dry Well DATE 6/11/70
(KIND OF SYSTEM)

REJECTED BY _____ FOR _____ DATE _____
(KIND OF SYSTEM)

HOLD PENDING FURTHER TESTS _____ DATE _____

REASONS FOR REJECTION OR HOLDING _____

THIS IS NOT A PERMIT

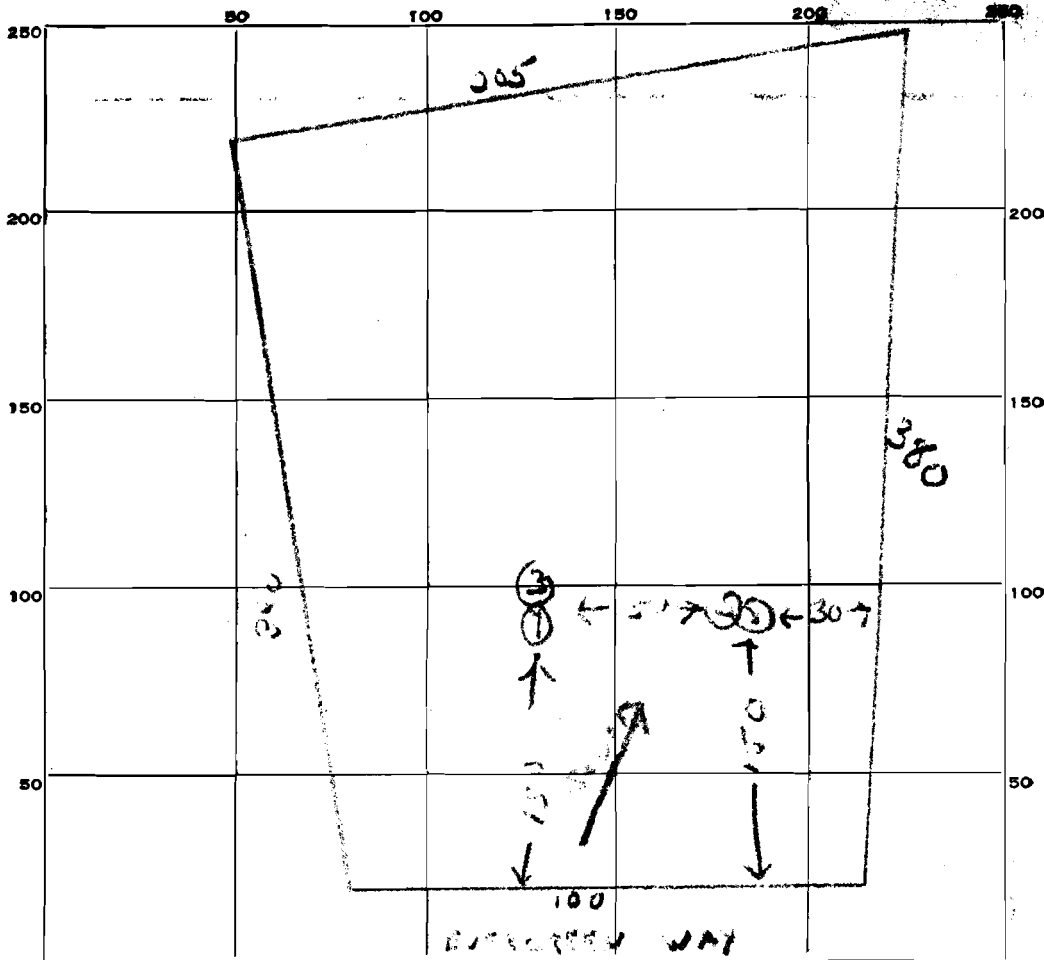

INDICATE NORTH. - NAME ADJOINING ROADWAY AS BASE LINE.

21-6

DATE	TEST NO.	DEPTH	PRE-WET		TEST - 1" DROP		TIME
			START	STOP	START	STOP	
4/25/69	1	9 1/2 ft	10 ⁰⁹	10 ¹²	10 ¹⁰	10 ¹²	2 min
	2	3 ft	10 ⁰⁹	10 ¹²	10 ¹²	10 ¹⁷	5 min
	3	9 1/2 ft	10 ⁰⁵	10 ⁰⁷	10 ⁰⁷	10 ⁰⁷	2 min
	4	9 1/2 ft	10 ⁰⁷	10 ⁰⁸	10 ⁰⁵	10 ¹¹	3 min

SOIL AUGER FINDING

R. T. Stone

TESTED BY

REMARKS