

PERMIT

SEWAGE DISPOSAL SYSTEM

MARYLAND STATE DEPARTMENT OF HEALTH

HOWARD COUNTY

ELLICOTT CITY

DISTRICT 3rd

DATE 8/4/81

INDEX

approved 8/11/81
Stayed
P 31528
A 29207

8/6/81
2:00 P.M.
8/10/81
Classified
8/11/81 AM

Jack Fyock

IS PERMITTED TO INSTALL X ALTER

ADDRESS 13775 Triadelphia Road, Glenelg, Md. 21737 PHONE 988-9270

SUBDIVISION Dickey Farms ROAD 1063 Day Road LOT 1

PROPERTY OWNER Craig L. Cairns

ADDRESS 4590 London Bridge Road, Sykesville, Md. 21784 Phone: 795-6994

SPECIFICATIONS 3 bedrooms

SEPTIC TANK CAPACITY 1000 GALLONS

DRAIN FIELD _____ DEPTH _____ FEET, BOTTOM AREA _____ SQ. FT.

DEEP TRENCH _____ DEPTH _____ FEET, BOTTOM AREA _____ SQ. FT.

SEEPAGE PITS _____ ABSORBENT SIDE-WALL AREA _____ SQ. FT.

INLET PIPE _____ FT. BELOW ORIGINAL GRADE, MAXIMUM DEPTH _____ FT. BELOW ORIGINAL GRADE

EFFECTIVE DEPTH AT _____ FT. BELOW ORIGINAL GRADE.

LOCATE DISPOSAL AREA _____ FT. FROM _____ LOT LINE AND _____ FT. FROM _____ LOT LINE AS SEEN WHEN FACING LOT FROM

TRENCH(ES) - To be 2 ft. wide. Inlet to be ^{1 1/2'} ~~2'~~ ~~2 1/2'~~ below original grade and effective absorbent area from ^{6 1/2'} ~~2'~~ ~~2 1/2'~~ to ~~7'~~ ~~7 1/2'~~ only. Maximum depth of trench(es) to be ^{6 1/2'} ~~7'~~ below original grade. A minimum of 145 sq. ft. effective absorbent sidewall area per bedroom needed. Trenches cannot exceed 100' in length. Distribution box to be used if more than 1 trench used. Two inspections of trenches required - before and after stone installed. If more than 1 trench used - need to have 15 ft. distance between trenches, center to center. Run trenches on contour. Start trench(es) at a point 30 ft. from right property line and 401 ft. from front property line when facing lot from Jim's Way, area of perc hole #13 as shown on house plan submitted by Cairns.

PLANS APPROVED BY Charles B. Streaker DATE 1/16/81

COVER NO WORK UNTIL INSPECTED AND APPROVED. *8/6/81 Grading done in area of high hole, O.K. to use 90 ft long trench with trench ending at high tilt hole (see drawing) F-S.*

NEITHER THE HOWARD COUNTY COUNCIL NOR THE HEALTH DEPARTMENT IS RESPONSIBLE FOR THE SUCCESSFUL OPERATION OF ANY SYSTEM.

NOTE: IF TRENCH IS USED CALL FOR INSPECTION BEFORE PLACING GRAVEL IN TRENCH.

NOTE: NO DRY WELL SHALL EXCEED 15 FOOT IN DIAMETER.

NOTE: ALL PIPE FROM HOUSE TO DISPOSAL AREA MUST BE CAST IRON.

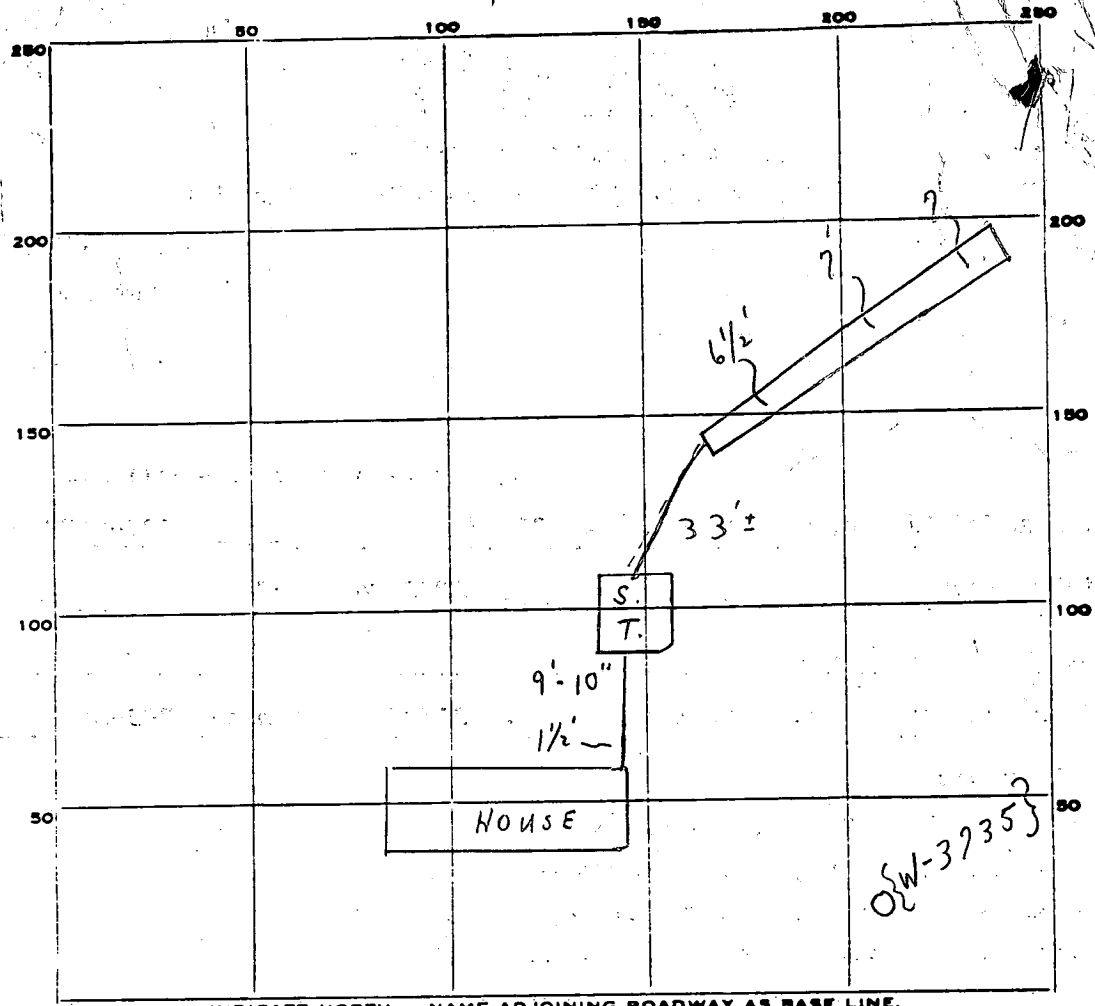
PERMIT VOID AFTER THREE YEARS.

NOTE: INSTALL STAND PIPE ON SEPTIC TANK AND DRY WELL. STAND PIPES MUST BE 6 INCHES IN DIAMETER. CAST IRON, CONCRETE OR TERRA COTTA ACCEPTED.

*INSTALLER IS RESPONSIBLE FOR OBTAINING FINAL APPROVAL ON THIS PERMIT.

A 29207

145
 435



INDICATE NORTH. - NAME ADJOINING ROADWAY AS BASE LINE.

JIM'S WAY

PERMIT CARD

SEPTIC TANK, LEVEL CLEANOUTS S.T. Terra Cotta

DISTRIBUTION BOX, LEVEL

TILE FIELD, DEPTH $6\frac{1}{2}' = 7'$ FT. TRENCH WIDTH 2 FT.

GRAVEL DEPTH 5' IN. TOTAL LENGTH 90 FT.

NUMBER OF TRENCHES 1 TOTAL BOTTOM AREA 435

SEEPAGE PITS, INSIDE DIAMETER _____ FT. DEPTH BELOW INLET _____ FT.

ABSORBENT AREA 435 SQ. FT.

REMARKS 8/6/81 Some grading has been done in area of high test hole. F.S.

8/10/81 TRENCH OK FOR STONE

8/11/81 OK to cover all work. JS

DATE SYSTEM APPROVED 8/11/81 INSPECTOR Stayer

DICKKEY FARMS

"JIM'S WAY + DAY ROAD EXTENDED" Lot Number 1

Septic tank 1 - 3 Bedrooms 1000 gallons
4 Bedrooms 1250 gallons

Trenches to be 2' wide. Inlet to be $2-2\frac{1}{2}$ ' below original grade and effective absorbant area from $2-2\frac{1}{2}' - 7-7\frac{1}{2}'$ only. Maximum depth of trenches to be $7\frac{1}{2}'$ below original grade. A minimum of 145 sq.ft. effective absorbant sidewall area per bedroom needed. Trenches can not exceed 100' in length. Distribution box to be used if more than 1 trench used. Two inspections of trenches required - before and after stone installed. If more than 1 trench used - need to have 15 ft. distance between trenches, center to center. Run trenches on contour.

LOCATION: Start trenches at a point 30' in from right property line and 401' from front property line when facing lot from JIM'S WAY. AREA OF PERC HOLE (13) AS SHOWN ON HOUSE PLAN SUBMITTED BY CAIRNS.

C.B.C.

Installer - Jack Fyock

902-2330

Retire 10/23/80
10/23/80
1:30 p.m.

APPLICATION

29207
~~29118~~

SEWAGE DISPOSAL TESTING

STATE OF MARYLAND - DEPARTMENT OF HEALTH AND MENTAL HYGIENE

HOWARD COUNTY HEALTH DEPARTMENT
ENVIRONMENTAL HEALTH SERVICES
P.O. BOX 476 ELLICOTT, MARYLAND 21043
TELEPHONE: 992-2330

Septic Tank { 1-3 Bedrooms 1000 gallons
4 Bedrooms 1250 gallons

Trenches

DISTRICT 3rd

DATE 10/30/78

See attached specs

BLDG. PERMIT SIGNED AND RETURNED 2/17/81
Serial # 45595

TO: THE COUNTY HEALTH OFFICER
ELLICOTT CITY, MARYLAND

I HEREBY APPLY FOR THE NECESSARY TEST IN ORDER TO CONSTRUCT (OR RECONSTRUCT) A SEWAGE DISPOSAL SYSTEM.

PROPERTY OWNER Craig L. Cairns

ADDRESS 4590 London Bridge Road PHONE 795-6994
SYKESVILLE, MD

PROPERTY LOCATION: 21784

SUBDIVISION Dickey Farms LOT NO. 1

ROAD AND DESCRIPTION 1063 Day Road
Jim's Way and "old" Day Rd

~~in wooded portion of lot~~ Back part of field

SIZE OF LOT 4.7 Ac TYPE BLDG. 1/2 STORY

THE SYSTEM INSTALLED UNDER THIS APPLICATION IS ACCEPTABLE ONLY UNTIL PUBLIC FACILITIES BECOME AVAILABLE.

I FULLY UNDERSTAND THE FEE CONNECTED WITH THE FILING OF THIS PERC TEST APPLICATION IS NON-REFUNDABLE UNDER ANY CIRCUMSTANCES.

SIGNATURE OF APPLICANT Craig L. Cairns

APPROVED BY C. B. Stueker FOR Whallow Trenches only DATE 1/16/81

REJECTED BY _____ FOR _____ DATE _____

HOLD PENDING FURTHER TESTS _____ DATE _____

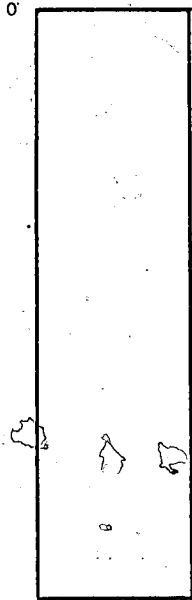
10/24/80 REASONS FOR REJECTION OR HOLDING for certified holes & easement by owner.

SENT VIA SECRETARIES THIS DATE (1) COPY OF PERC TESTS; (2)

SAMPLE PERCOLATION CERTIFICATION PLAT; (3) CERTIFY HOLE MEMO TO BE ACCOMPLISHED BY OWNER. C.B.A.

THIS IS NOT A PERMIT

SOIL PROFILE



INDICATE NORTH - NAME ADJOINING ROADWAY AS BASE LINE.

DATE	TEST NO.	DEPTH	PRE-WET		TEST - 1" DROP		TIME
			START	STOP	START	STOP	

REMARKS _____

TYPE OF SOIL _____

TESTED BY _____ ALSO PRESENT _____

APPLICATION

A 24613

SEWAGE DISPOSAL TESTING

P _____

STATE OF MARYLAND - DEPARTMENT OF HEALTH AND MENTAL HYGIENE

HOWARD COUNTY HEALTH DEPARTMENT
ENVIRONMENTAL HEALTH SERVICES

ST 3 - 1000
4 - 1250

DISTRICT 3

P. O. BOX 476, ELLICOTT CITY, MARYLAND 21043
TELEPHONE: 465-5000, EXT. 356

DATE 9-27-76

Locate the Dye 110' from the road & 27' from the left side as seen from the road. The line will enter the pw @ 3' below top, & the max depth will not exceed 10'. There will be no less than 2' of sidewalk area / BR.

m

TO: THE COUNTY HEALTH OFFICER
ELLICOTT CITY, MARYLAND

I, HEREBY, APPLY FOR THE NECESSARY TEST IN ORDER TO CONSTRUCT (OR RECONSTRUCT) A SEWAGE DISPOSAL SYSTEM.

PROPERTY OWNER James W. Dickey

ADDRESS Forsythe Rd. Sykesville PHONE 489-7148

PROPERTY LOCATION:

SUBDIVISION Day Road LOT NO. 1

ROAD AND DESCRIPTION End of hard surface on Day Road.

SIZE OF LOT 4.7758 TYPE BLDG. 3
NUMBER OF BEDROOMS

IF NOT SINGLE RESIDENCE DESCRIBE _____

THE SYSTEM INSTALLED UNDER THIS APPLICATION IS ACCEPTABLE ONLY UNTIL PUBLIC FACILITIES BECOME AVAILABLE.

SIGNATURE OF APPLICANT Charles G. [Signature]

APPROVED BY R. Morefield FOR Dw/Trench DATE 4/77
(KIND OF SYSTEM)

REJECTED BY _____ FOR _____ DATE _____
(KIND OF SYSTEM)

HOLD PENDING FURTHER TESTS _____ DATE _____

REASONS FOR REJECTION OR HOLDING _____

THIS IS NOT A PERMIT

INDICATE NORTH. - NAME ADJOINING ROADWAY AS BASE LINE

DATE	TEST NO.	DEPTH	PRE-WET		TEST 1" DROP		TIME
			START	STOP	START	STOP	

REMARKS _____

TYPE OF SOIL _____

TESTED BY _____ ALSO PRESENT: _____

APPLICATION

A _____

P _____

SEWAGE DISPOSAL TESTING

STATE OF MARYLAND - DEPARTMENT OF HEALTH AND MENTAL HYGIENE

HOWARD COUNTY HEALTH DEPARTMENT
ENVIRONMENTAL HEALTH SERVICES

P. O. BOX 476, ELLICOTT CITY, MARYLAND 21043
TELEPHONE: 465-5000, EXT. 356

DISTRICT 3

DATE 9-27-76

TO: THE COUNTY HEALTH OFFICER
ELLICOTT CITY, MARYLAND

I, HEREBY, APPLY FOR THE NECESSARY TEST IN ORDER TO CONSTRUCT (OR RECONSTRUCT) A SEWAGE DISPOSAL SYSTEM.

PROPERTY OWNER

James W. Dickey

ADDRESS

Forsythe Rd Sykesville

PHONE

489-7148

PROPERTY LOCATION:

SUBDIVISION

Day Road

LOT NO.

1

ROAD AND DESCRIPTION

End of hard surface on Day Road

SIZE OF LOT

4.7758

TYPE BLDG.

3

NUMBER OF BEDROOMS

IF NOT SINGLE RESIDENCE DESCRIBE _____

THE SYSTEM INSTALLED UNDER THIS APPLICATION IS ACCEPTABLE ONLY UNTIL PUBLIC FACILITIES BECOME AVAILABLE.

SIGNATURE OF APPLICANT

Charles E. Wilkins

APPROVED BY _____

FOR _____

DATE _____

(KIND OF SYSTEM)

REJECTED BY _____

FOR _____

DATE _____

(KIND OF SYSTEM)

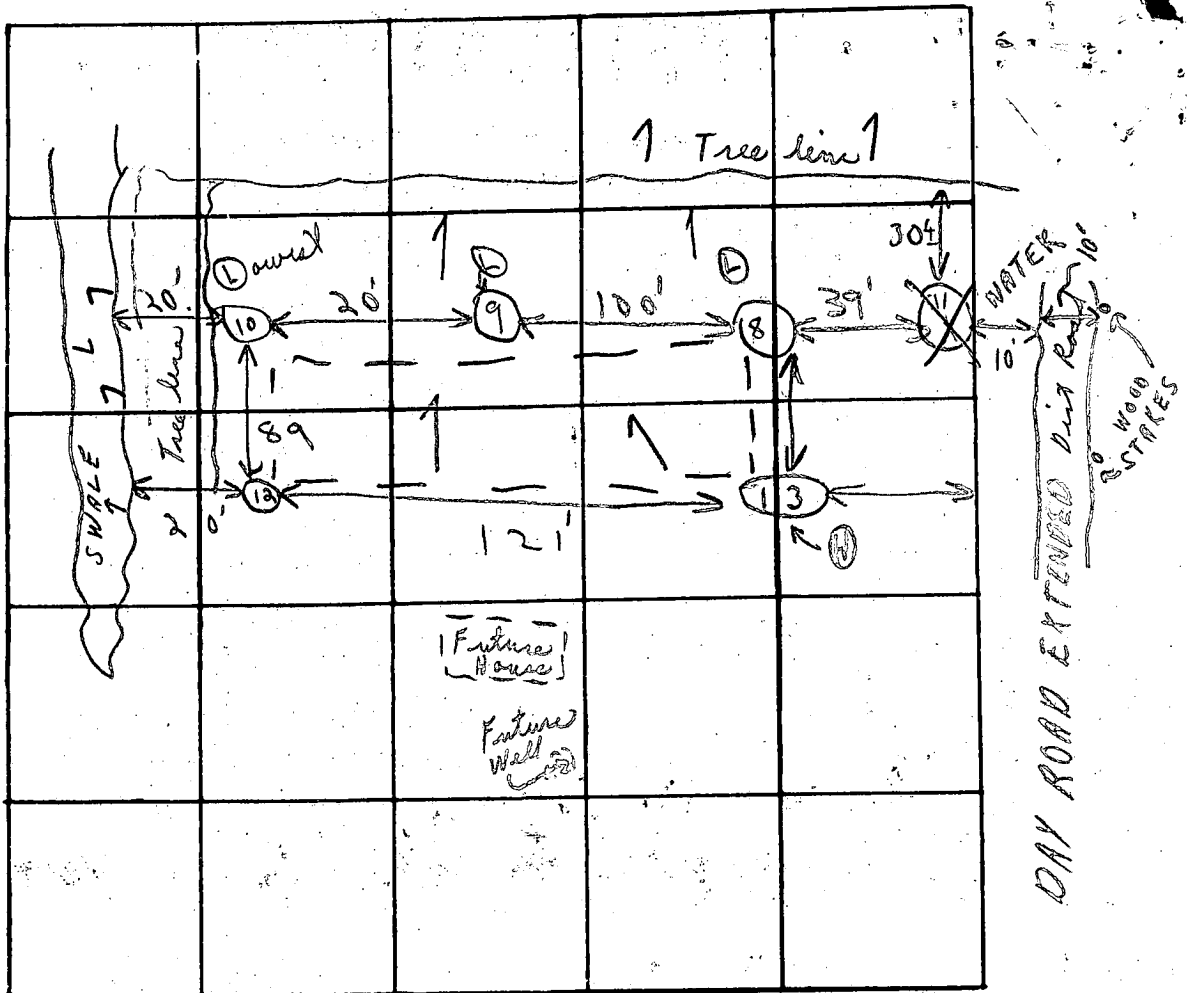
HOLD PENDING FURTHER TESTS _____

DATE _____

REASONS FOR REJECTION OR HOLDING _____

THIS IS NOT A PERMIT

/
LOT



INDICATE NORTH - NAME ADJOINING ROADWAY AS BASE LINE.

R/W

SOIL PROFILE	DATE	TEST NO.	DEPTH	PRE-WET		TEST - 1" DROP		TIME
				START	STOP	START	STOP	
1'-2'	10/23/80	9A	2'	2:04	2:06	2:08	2:13	5m
2'-12' LOAM + SANDSTONE		9B	12'	2:05	2:13	2:13	2:26	13m
		10	13'	1:30 3:0 -	clay 13'	SIMILAR TO loam	DAMP SOIL	IN BOTTOM
		11	X 13'	X 13'	CLAY + LOAM	CLAY + LOAM	X water	12' 10"
1'-2' CLAY		12A	2 1/2'	3:10	3:15	3:15	3:25	10m
2'-13 1/2' LOAM		B	13 1/2'	3:13	3:16	3:16	3:20	4m
1'-2' clay		13A	2'	3:41	3:49	3:49	4:12	23m
2'-11' LOAM + SANDSTONE HARD IN BOTTOM		(H) B.	11'	3:47	3:59	3:59	4:09	10m
								65

HOLD FOR WET SEASON (R) DO NOT INCLUDE

11 mm
145 sq ft
per bed room

REMARKS: Recommend shallow trench. HOLD FOR CERTIFIED HOLES
 TYPE OF SOIL: Below original grade 2' inlet + maximum depth 7' on contour. C.B.D.
 TESTED BY: C.B.D. ALSO PRESENT: Pete Garity + OWNER MR. CAIRNS

APPLICATION

A _____

P _____

SEWAGE DISPOSAL TESTING

STATE OF MARYLAND - DEPARTMENT OF HEALTH AND MENTAL HYGIENE

HOWARD COUNTY HEALTH DEPARTMENT
ENVIRONMENTAL HEALTH SERVICES
P. O. BOX 476, ELLICOTT CITY, MARYLAND 21043
TELEPHONE: 465-5000, EXT. 356

DISTRICT 3
DATE 9-27-76

TO: THE COUNTY HEALTH OFFICER
ELLICOTT CITY, MARYLAND

I, HEREBY, APPLY FOR THE NECESSARY TEST IN ORDER TO CONSTRUCT (OR RECONSTRUCT) A SEWAGE DISPOSAL SYSTEM.

PROPERTY OWNER James W. Dickey

ADDRESS Forsythe Rd Sykesville PHONE 489-7148

PROPERTY LOCATION: Day Road
SUBDIVISION _____ LOT NO. 1

ROAD AND DESCRIPTION End of hard surface on Day Road.

SIZE OF LOT 4.7758 TYPE BLDG. 3
NUMBER OF BEDROOMS

IF NOT SINGLE RESIDENCE DESCRIBE _____

THE SYSTEM INSTALLED UNDER THIS APPLICATION IS ACCEPTABLE ONLY UNTIL PUBLIC FACILITIES BECOME AVAILABLE

SIGNATURE OF APPLICANT Charles E. Webber

APPROVED BY _____ FOR _____ DATE _____
(KIND OF SYSTEM)


REJECTED BY _____ FOR _____ DATE _____
(KIND OF SYSTEM)

HOLD PENDING FURTHER TESTS _____ DATE _____

REASONS FOR REJECTION OR HOLDING _____

THIS IS NOT A PERMIT

#1

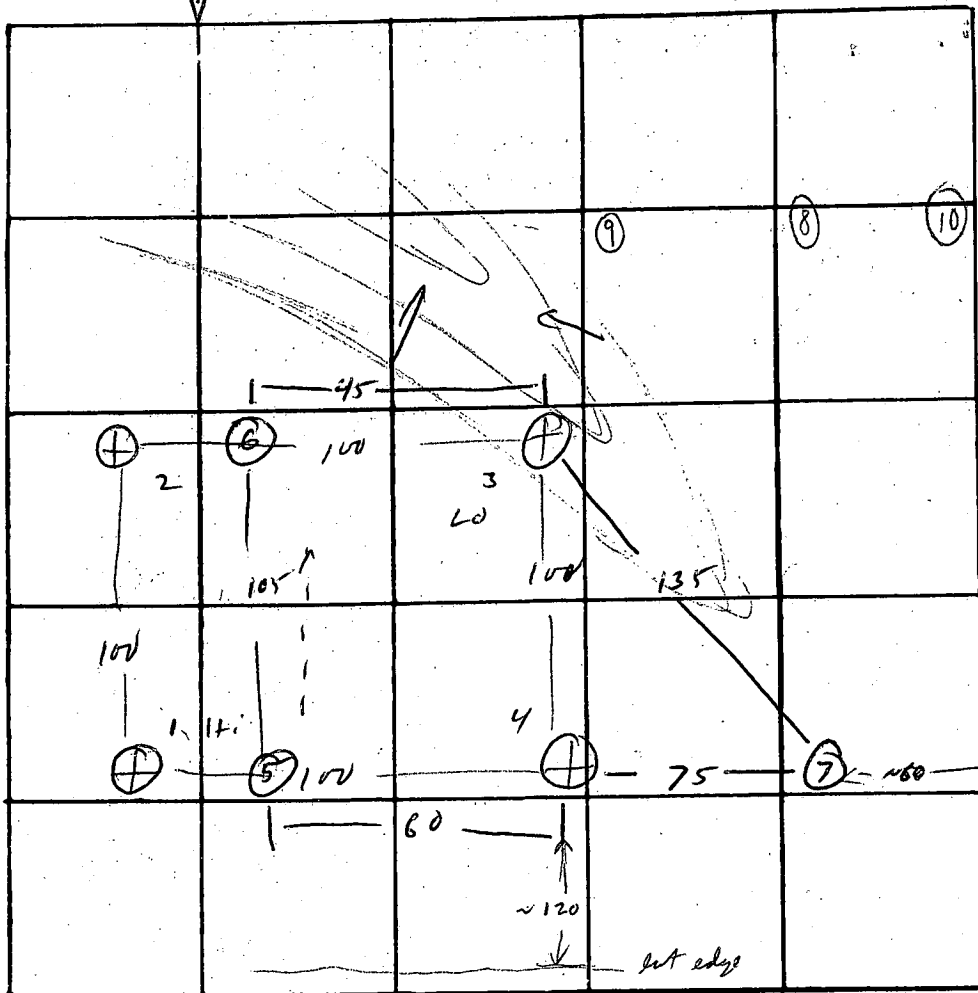

LA 1
← Dary Rd →

INDICATE NORTH. - NAME ADJOINING ROADWAY AS BASE LINE.

DATE	TEST NO.	DEPTH	PRE-WET		TEST - 1" DROP		TIME
			START	STOP	START	STOP	
12/1/26	1	3	3 ²⁸	3 ⁴⁸	3 ⁴⁸	4 ¹³	25
	(1A)	13 ^{1/2}	3 ²⁸	almost 1" in 30 min			> 30
	2	3	3 ³⁴	3 ⁴⁰	3 ⁴⁰	3 ⁵¹	11
	2A	13 ^{1/2}	3 ³⁴	3 ⁵¹	3 ⁵¹	4 ¹¹	20
	3	3 ^{1/2}	3 ³⁸	3 ⁴³	3 ⁴³	3 ⁵⁰	7
	3A	13 ^{1/2}	3 ³⁸	3 ⁴³	3 ⁴³	3 ⁵⁰	7
	4	13 ^{1/2}	vis - dry				
	5	3	10 ¹²	10 ¹³	10 ¹³	10 ²⁵	8
	5A	13 ^{1/2}	10 ¹²	10 ²⁵	10 ²⁵	10 ⁵⁶	21
	6	3 ^{1/2}	10 ⁴⁴	10 ⁴⁶	10 ⁴⁶	10 ⁵⁵	9
	6A	13 ^{1/2}	10 ⁴⁴	10 ⁴⁸	10 ⁴⁸	10 ⁵⁸	10
	7	3 13 ^{1/2}	10 ⁴²	10 ⁴⁵ 11 ⁰²	10 ⁴⁵ 11 ⁰²	10 ⁵⁸	13
	8A	3'	1:40	1:44	1:44	1:49	5m
	9	13'	1:51	1:56	1:56	2:08	12m

Soil Profile
1'-3' clay
3'-13'
LOAM

REMARKS
CBS,
TYPE OF SOIL

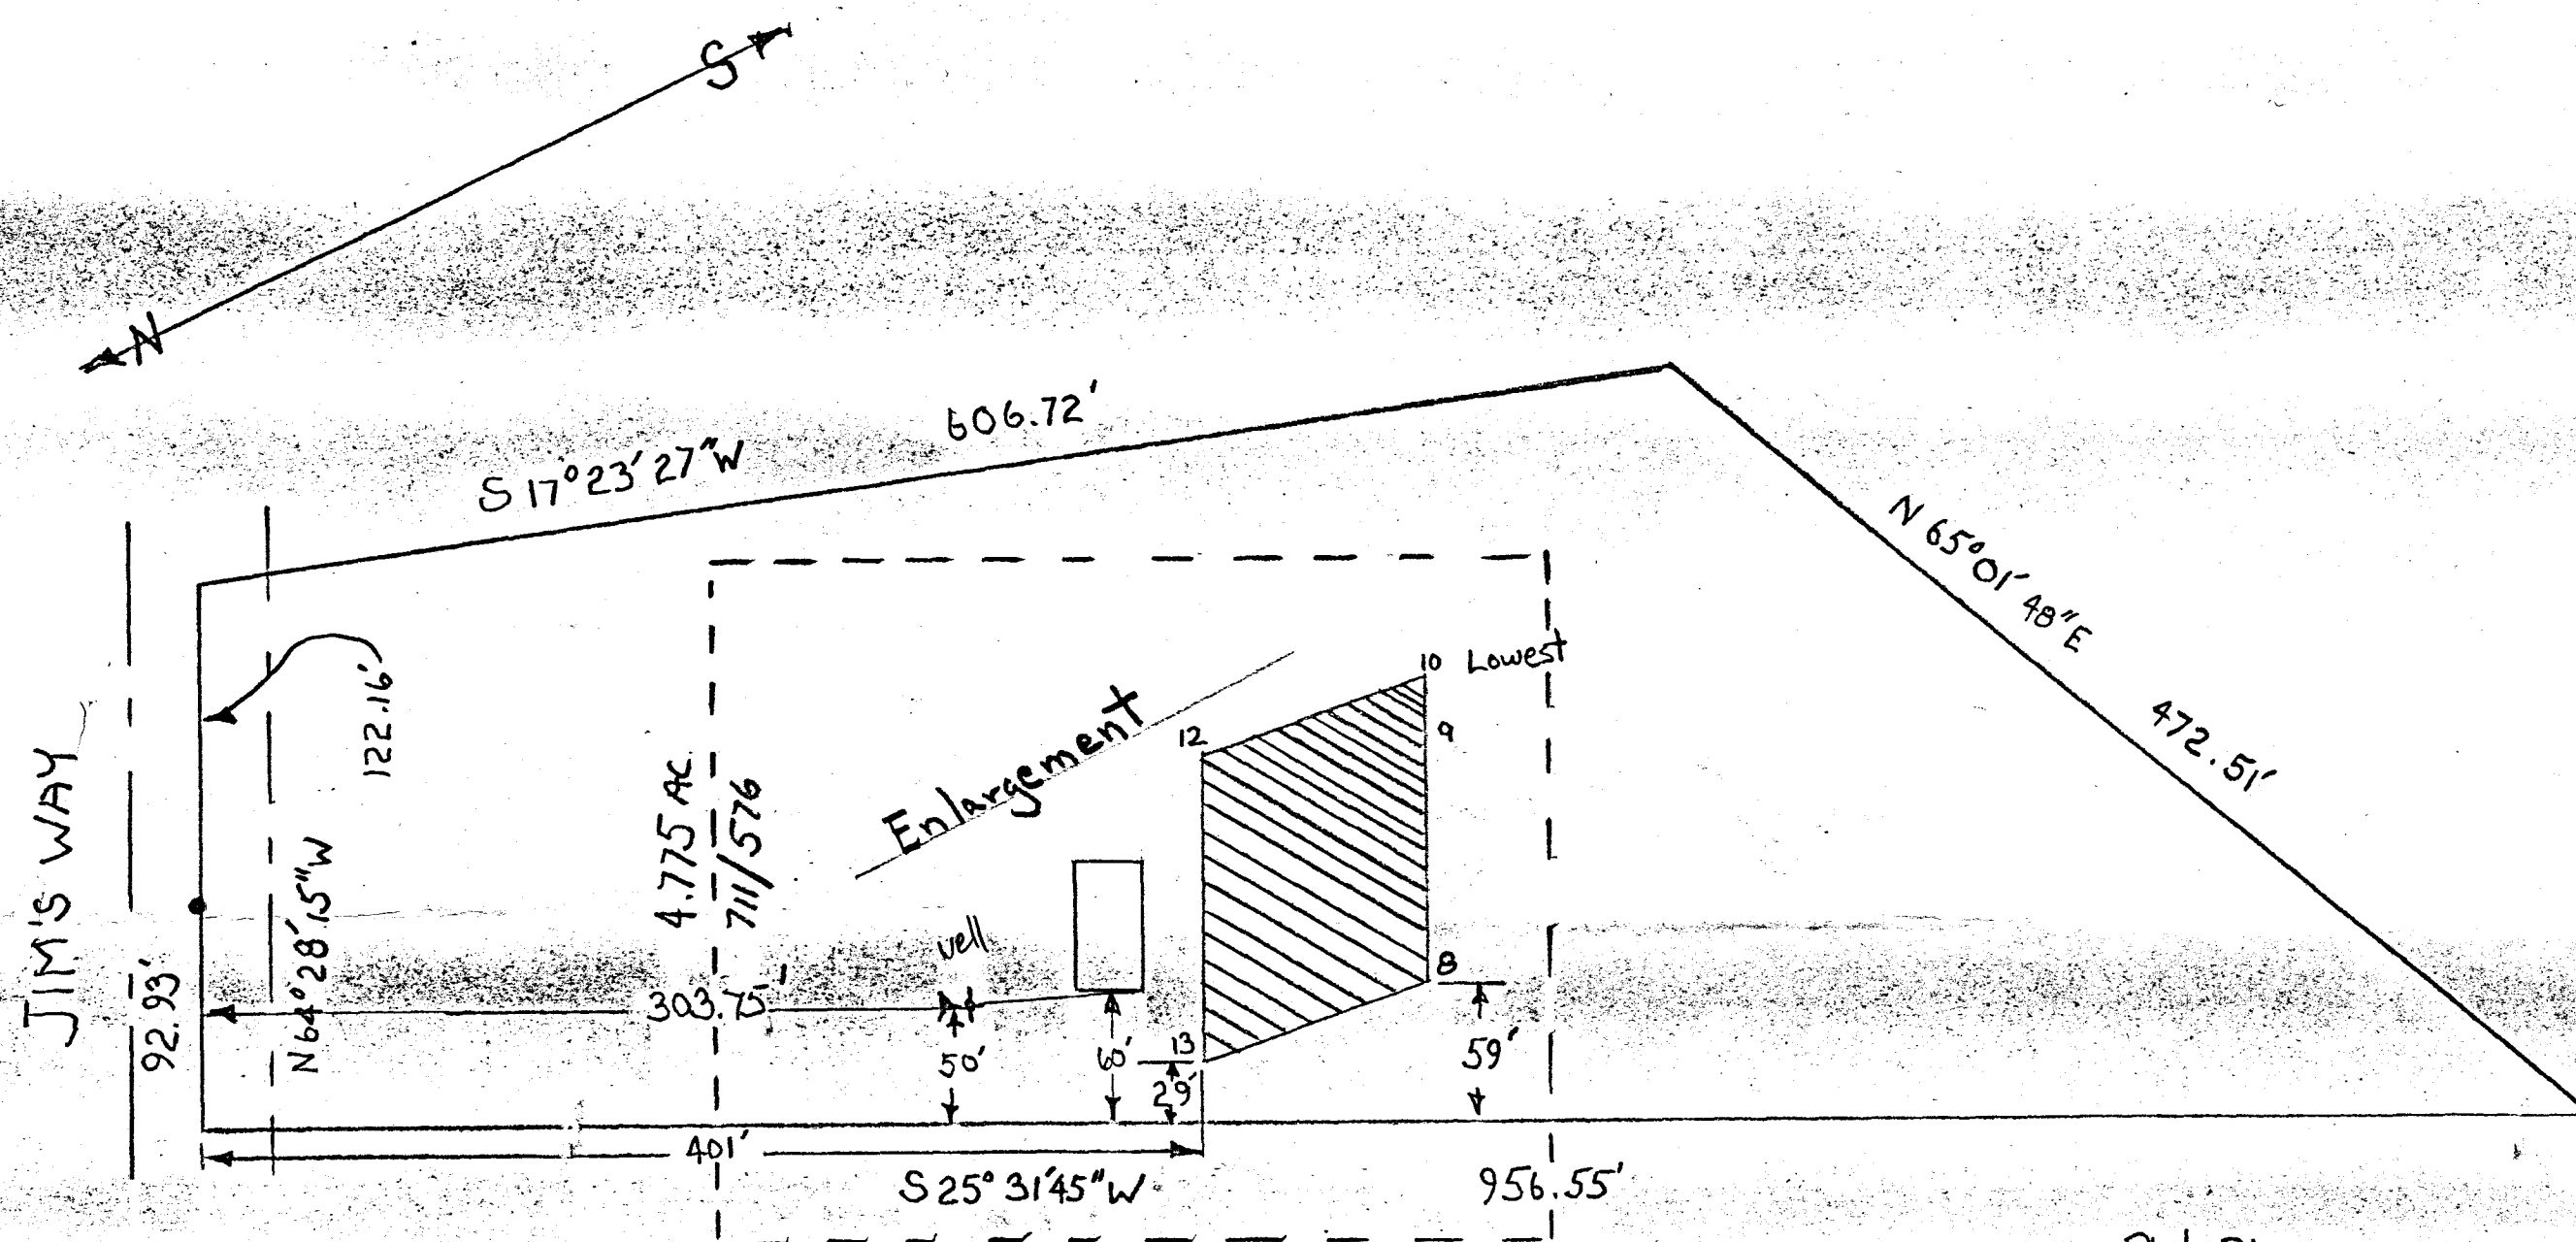
TESTED BY

M

ALSO PRESENT:

Scheel

at base of pipe
dry
(out)



JIM'S WAY

DAY ROAD EXTENDED

Enlargement

4.775 AC.
7/11/576

Well

10 Lowest

OK 11/5/80
F. Skinner

Plot Plan

Property of Craig and Cindy Cairns

Scale 1" =

Plot Plan for Lot #1 Dickey Farm
3rd Elect. Dist. How. Co. Md.
Sykesville

C1 4802 SEQUENCE NO. (WRA USE ONLY)

STATE OF MARYLAND WELL COMPLETION REPORT

THIS REPORT MUST BE SUBMITTED WITHIN 30 DAYS AFTER WELL IS COMPLETED

(THIS NUMBER IS TO BE PUNCHED IN COLS. 3-6 ON ALL CARDS)

COUNTY NUMBER A 29207

Date Received (WRA use only) 11/14/80 DATE WELL COMPLETED

Depth of Well 160 (TO NEAREST FOOT)

PERMIT NO. FROM "PERMIT TO DRILL WELL" HO-73-373.5

OWNER CAIRNS CRAIG last name first name STREET OR RFD JIM'S WAY TOWN Sykesville SUBDIVISION DICKEY FARMS SECTION LOT 1

WELL LOG table with columns: DESCRIPTION (Use additional sheets if needed), FEET (FROM, TO), Check if water bearing. Rows include Top soil, Shale, Clay, Sandstone, Granite, Sandstone, Granite, Sandstone, Granite.

WELL HAS BEEN GROUTED (Circle Appropriate Box) YES [Y] NO [N] TYPE OF GROUTING MATERIAL CEMENT [CM] BENTONITE CLAY [BC] NO. OF BAGS 10 NO. OF POUNDS 2000 GALLONS OF WATER 50 DEPTH OF GROUT SEAL (to nearest foot) from 0 ft. to 40 ft.

CASING RECORD casing types insert appropriate code below [ST] STEEL [CO] CONCRETE [PL] PLASTIC [OT] OTHER MAIN CASING TYPE [ST] 6 Nominal diameter top (main) casing (nearest inch) 47 Total depth of main casing (nearest foot)

OTHER CASING (if used) diameter inch depth (feet) from to

SCREEN RECORD screen type or openhole insert appropriate code below [ST] STEEL [BR] BRASS BRONZE [PL] PLASTIC [HO] OPEN HOLE [OT] OTHER

DEPTH (nearest ft.) 160 45 160 SLOT SIZE DIAMETER OF SCREEN (NEAREST INCH)

GRAVEL PACK IF WELL DRILLED WAS FLOWING WELL CIRCLE BOX [F]

WRA USE ONLY (NOT TO BE FILLED IN BY DRILLER) T (E.R.O.S.) W Q 70 TELESCOPE CASING 72 LOG INDICATOR OTHER DATA

PUMPING TEST HOURS PUMPED (nearest hour) 2 PUMPING RATE (gal. per min. to nearest gal.) 10 METHOD USED TO MEASURE PUMPING RATE [BUCKET] WATER LEVEL (distance from land surface) BEFORE PUMPING 50 WHEN PUMPING 160 TYPE OF PUMP USED (for test) [A] air [P] piston [T] turbine [C] centrifugal [R] rotary [O] other (describe below) [J] jet [S] submersible

PUMP INSTALLED DRILLER WILL INSTALL PUMP (CIRCLE APPROPRIATE BOX) YES [Y] NO [N] IF DRILLER INSTALLS PUMP, THIS SECTION MUST BE COMPLETED FOR ALL WELLS EXCEPT HOME USE TYPE OF PUMP (WRITE APPROPRIATE LETTER IN BOX - SEE ABOVE: (A, C, J, P, R, S, T, O)) CAPACITY: GALLONS PER MINUTE (to nearest gallon) PUMP HORSE POWER PUMP COLUMN LENGTH (nearest ft.) CASING HEIGHT (circle appropriate box and enter casing height) [+2] above LAND SURFACE [-] below 2 (nearest foot)

LOCATION OF WELL ON LOT SHOW PERMANENT STRUCTURE SUCH AS BUILDING, SEPTIC TANKS, AND/OR LANDMARKS AND INDICATE NOT LESS THAN TWO DISTANCES (MEASUREMENTS TO WELL) WELL 50' RIGHT-LOT LINE

CIRCLE APPROPRIATE BOX [A] A WELL WAS ABANDONED AND SEALED WHEN THIS WELL WAS COMPLETED [E] ELECTRIC LOG OBTAINED [P] TEST WELL CONVERTED TO PRODUCTION WELL

I HEREBY CERTIFY THAT I HAVE COMPLIED WITH ALL CONDITIONS STATED ON THE ABOVE-CAPTIONED "PERMIT TO DRILL WELL", AND THAT INFORMATION CONTAINED IN THIS REPORT IS TRUE, ACCURATE, AND COMPLETE TO THE BEST OF MY KNOWLEDGE, INFORMATION AND BELIEF.

DRILLERS IDENT. NO. 40 DRILLERS SIGNATURE SITE SUPERVISOR (sign of driller or journeyman responsible for sitework if different from permittee)

B 1 6330 SEQUENCE NO. (WRA USE ONLY)

STATE OF MARYLAND
WATER RESOURCES ADMINISTRATION
TAWES STATE OFFICE BLDG., ANNAPOLIS, MARYLAND 21401
APPLICATION FOR PERMIT TO DRILL WELL

WRA PERMIT NUMBER HO-73-3735
 FILL IN THIS FORM COMPLETELY

DATE RECEIVED (WRA USE ONLY)
10/27/80
11/14/80
9:30 A.M.

OWNER Cairns, Craig
 COL 15 LAST NAME COL 16 FIRST NAME COL 17 COL 18 
STREET OR RFD 4590 London Bridge Rd.
 COL 36 COL 37 COL 38 
POST OFFICE Sykesville Md 21784
 COL 67 COL 68 COL 69 
B 1 CONTINUED **DRILLER INFORMATION**

DATE 10-24-80 LICENSE NUMBER 40
 COL 1 COL 2 
B 3 LOCATION OF WELL

COUNTY Howard
 COL 1 COL 2 
SUBDIVISION Section Howard
 COL 23 COL 24 COL 25 
SECTION 46 LOT 1
 COL 44 COL 45 COL 46 
NEAREST TOWN Sykesville
 COL 52 COL 53 COL 54 
MILES FROM TOWN (ENTER 0 IF IN TOWN) 3
 COL 73 COL 74 COL 75 COL 76 COL 77 COL 78 COL 79 COL 80 COL 81 COL 82 COL 83 COL 84 COL 85 COL 86 COL 87 COL 88 COL 89 COL 90 COL 91 COL 92 COL 93 COL 94 COL 95 COL 96 COL 97 COL 98 COL 99 COL 100

B 2 WELL INFORMATION

MAXIMUM PUMPING RATE (GALLONS PER MINUTE) 5
 COL 1 COL 2 
AVERAGE DAILY QUANTITY NEEDED (GALLONS PER DAY) 600
 COL 1 COL 2 
USE FOR WATER (CIRCLE APPROPRIATE BOX)

HOME (SINGLE OR DOUBLE HOUSEHOLD UNIT ONLY)
 FARMING, AGRICULTURE, IRRIGATION
 INDUSTRIAL, COMMERCIAL, STATE AND FEDERAL GOVERNMENT.
 MUNICIPAL WATER SUPPLY
 PRIVATE WATER COMPANY
 TEST

MUST HAVE STATE HEALTH DEPT. APPROVAL

B 4 DIRECTION FROM TOWN (CIRCLE APPROPRIATE BOX)

NORTH EAST NORTHWEST SOUTHWEST
 SOUTH WEST NORTHEAST SOUTHEAST

NEAR WHAT ROAD Winn Way
 COL 11 COL 12 COL 13 
ON WHICH SIDE OF ROAD (CIRCLE APPROPRIATE BOX) NORTH SOUTH EAST WEST

DISTANCE FROM ROAD (ENTER DISTANCE AND CIRCLE APPROPRIATE BOX) 150
 COL 34 COL 35 COL 36 
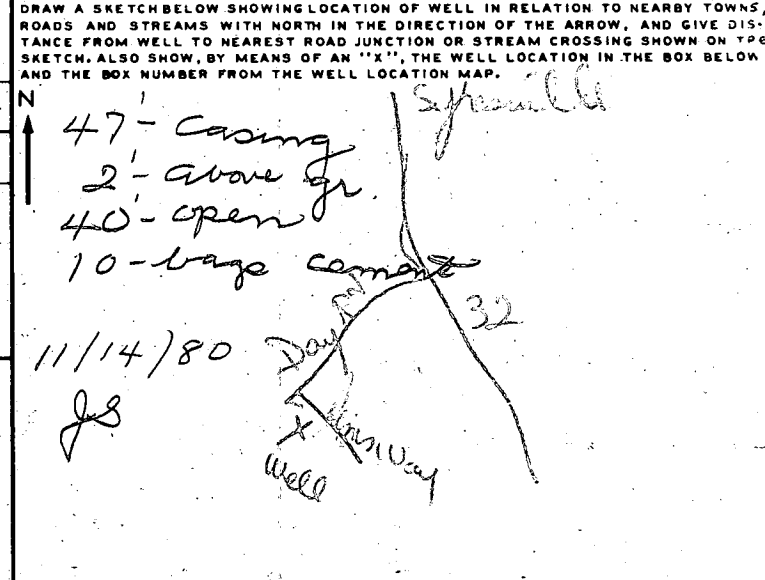
APPROXIMATE DEPTH OF WELL 150 FEET
 COL 24 COL 25 COL 26 
APPROXIMATE DIAMETER OF WELL 6" (NEAREST INCH)
 COL 1 COL 2 
METHOD OF DRILLING USED (CIRCLE APPROPRIATE METHOD)

BORED (OR AUGERED) JETTED DRIVEN
 AIR-ROTARY AIR-PERCUSSION ROTARY (HYDRAULIC ROTARY)
 CABLE REVERSE-ROTARY DRIVE-POINT

OTHER (DESCRIBE) _____



REPLACEMENT OR DEEPEMED WELLS (CIRCLE APPROPRIATE BOX)

THIS WELL WILL NOT REPLACE AN EXISTING WELL
 THIS WELL WILL REPLACE A WELL THAT WILL BE ABANDONED AND SEALED
 THIS WELL WILL REPLACE A WELL THAT WILL BE USED AS A STANDBY
 THIS WELL WILL DEEPEM AN EXISTING WELL
 PERMIT NUMBER OF WELL TO BE REPLACED OR DEEPEMED (IF AVAILABLE) _____

NOT TO BE FILLED IN BY DRILLER (WRA USE ONLY)

APPROPRIATION PERMIT NUMBER _____ ENGINEER REVIEW DISTRICT NO. _____
 COL 54 COL 55 COL 56 
FORCE _____ WRITE INITIALS IN BOX _____ CONDITIONS _____
 COL 67 COL 68 COL 69 
BOX NUMBER 800
540

NORTH COORDINATE 545000
 COL 50 COL 51 COL 52 
EAST COORDINATE 080500
 COL 57 COL 58 COL 59 
ELEVATION AT WELL HEAD (FEET) _____
 COL 65 COL 66 COL 67 
B 4 CONTINUED **HEALTH DEPARTMENT APPROVAL**

STATE HEALTH (CIRCLE BOX) S COUNTY NAME HOWARD COUNTY NO. A29207
 COL 1 COL 2 
DATE 110580 APPROVED BY Frank Skinner
 COL 43 COL 44 COL 45 
B 5 SPECIAL CONDITIONS 8-83 (WRA USE ONLY)

1 2 3 (SEQ. NO.) 6