

Approved
CLL
28 MAR 79

3/27/79 P.C.D
c-50

PERMIT

SEWAGE DISPOSAL SYSTEM

MARYLAND STATE DEPARTMENT OF HEALTH*

HOWARD COUNTY

02-242990

ELLICOTT CITY

P 29522
A Repair

DISTRICT 2nd

DATE 2/26/79

INDEXED

Mr. Van Sant

IS PERMITTED TO INSTALL _____ ALTER X

ADDRESS Frederick Road, West Friendship, Md. PHONE _____

SUBDIVISION _____ ROAD 3995 College Avenue LOT _____

PROPERTY OWNER Mr. Sewell, Mr. Burgess & Mr. Kidwell

ADDRESS Dollege Avenue, Ellicott City, Md. 21043

SPECIFICATIONS

SEPTIC TANK CAPACITY _____ GALLONS
DRAIN FIELD _____ DEPTH _____ FEET, BOTTOM AREA _____ SQ. FT.
DEEP TRENCH _____ DEPTH _____ FEET, BOTTOM AREA _____ SQ. FT.
SEEPAGE PITS _____ ABSORBENT SIDE-WALL AREA _____ SQ. FT.
INLET PIPE _____ FT. BELOW ORIGINAL GRADE. MAXIMUM DEPTH _____ FT. BELOW ORIGINAL GRADE
EFFECTIVE DEPTH AT _____ FT. BELOW ORIGINAL GRADE.
LOCATE DISPOSAL AREA _____ FT. FROM _____ LOT LINE AND _____ FT. FROM _____ LOT LINE AS SEEN WHEN
FACING LOT FROM

REPAIR - Call for an appointment when ground is opened up and Sanitarian will

recommend the repair system. ^{3 1/2'} ^{100'} ^{6'} ^{3'} ^{6"}
wide to trench & deep to of

*stone per Hodges specs updated 3/13/79. Place ditch in
approx 50 to 90 ft from College Ave and 80 to 100 ft from house - run ditch off
old S/S system*

PLANS APPROVED BY Palmer F. Wine DATE 2/26/79

COVER NO WORK UNTIL INSPECTED AND APPROVED.

NEITHER THE HOWARD COUNTY COUNCIL NOR THE HEALTH DEPARTMENT IS RESPONSIBLE FOR THE SUCCESSFUL OPERATION OF ANY SYSTEM.


- NOTE: IF TRENCH IS USED CALL FOR INSPECTION BEFORE PLACING GRAVEL IN TRENCH.
 - NOTE: NO DRY WELL SHALL EXCEED 15 FOOT IN DIAMETER.
 - NOTE: ALL PIPE FROM HOUSE TO DISPOSAL AREA MUST BE CAST IRON.
- PERMIT VOID AFTER THREE YEARS.

NOTE: INSTALL STAND PIPE ON SEPTIC TANK AND DRY WELL. STAND PIPES MUST BE 6 INCHES IN DIAMETER. CAST IRON, CONCRETE OR TERRA COTTA ACCEPTED.

*INSTALLER IS RESPONSIBLE FOR OBTAINING FINAL APPROVAL ON THIS PERMIT.

BOG. PERMIT SIGNED
AND RETURNED 3/19/79
Serial # 30976
Interior Attention

P 29522

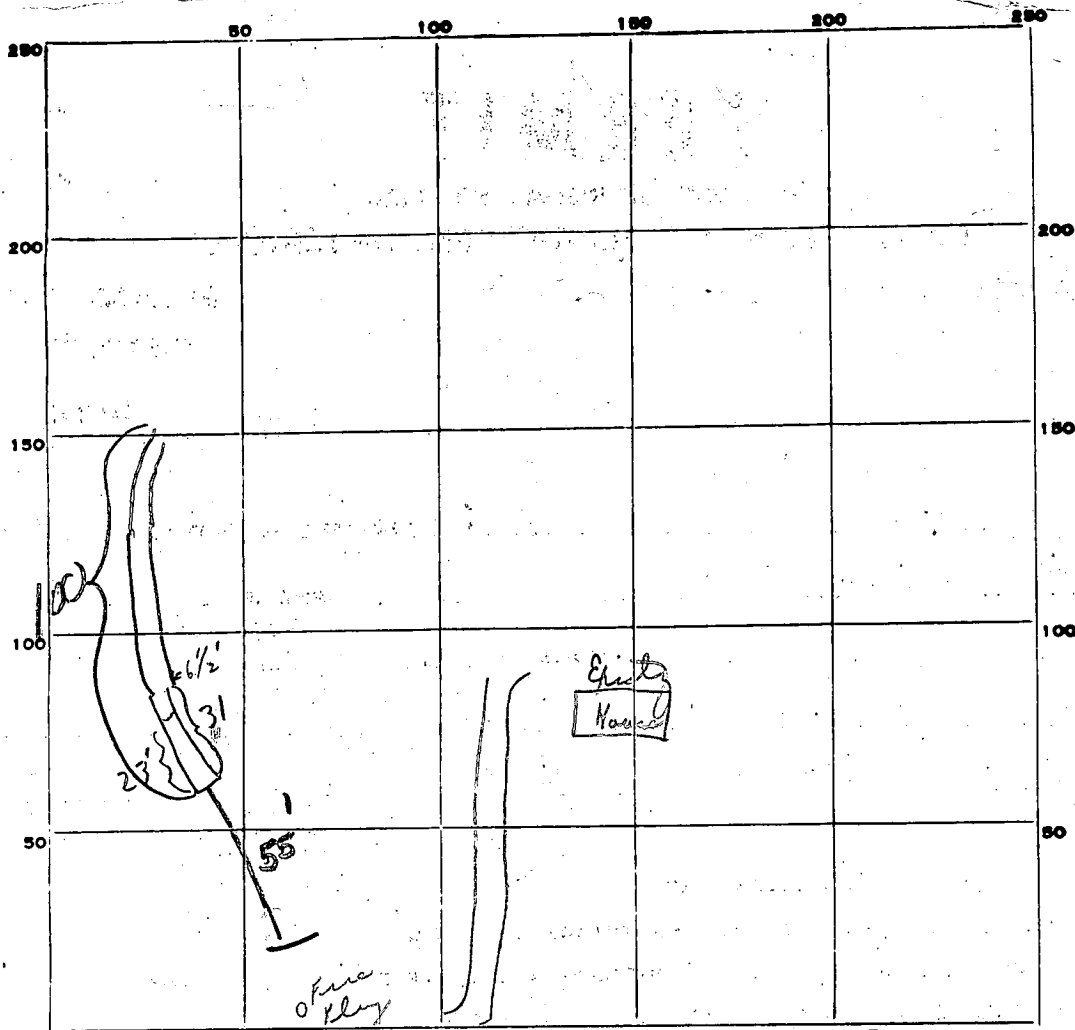

INDICATE NORTH - NAME ADJOINING ROADWAY AS BASE LINE.

College Ave

EC

PERMIT CARD

Yes

SEPTIC TANK, LEVEL

CLEANOUTS

N/A

DISTRIBUTION BOX, LEVEL

TILE FIELD, DEPTH

6 1/2'

FT.

TRENCH WIDTH

2' +

FT.

GRAVEL DEPTH

1'

TOTAL LENGTH

100^{3/4}

FT.

NUMBER OF TRENCHES

TOTAL BOTTOM AREA

SEEPAGE PITS, INSIDE DIAMETER

FT.

DEPTH BELOW INLET

FT.

ABSORBENT AREA

SQ. FT.

REMARKS

3/29/79 (1) 23' of trench has stone in it - trench covered
 and signed off to contractor - to call before stone installed
 in two trenches - for inspection Partial OK
 3/28/79 - OK to put gravel in trench - close off old line upper
 area flowing - call for work when all work is done

28 MAR 79 - Junction box eliminated. Cast iron to trench. Final OK. (GLI)

DATE SYSTEM APPROVED

28 MAR 79

INSPECTOR

G. Keller