

4/20/79
4/24/79

App.
24/01/79

P 29720
A 22376

PERMIT

SEWAGE DISPOSAL SYSTEM
MARYLAND STATE DEPARTMENT OF HEALTH*

HOWARD COUNTY

INDEXED
INDEXED

ELLICOTT CITY

DISTRICT 528

DATE 4/27/79

4/18/79
please

Jim Brittingham

IS PERMITTED TO INSTALL R ALTER

ADDRESS _____ PHONE _____

SUBDIVISION The Heritage ROAD DRY PACE ROAD LOT 27

PROPERTY OWNER King GERRON - John Syrk

ADDRESS _____

SPECIFICATIONS 4 bedrooms

SEPTIC TANK CAPACITY 1250 GALLONS
DRAIN FIELD _____ DEPTH _____ FEET. BOTTOM AREA _____ SQ. FT.
DEEP TRENCH _____ DEPTH _____ FEET. BOTTOM AREA _____ SQ. FT.
SEEPAGE FITS _____ ABSORBENT SIDE-WALL AREA _____ SQ. FT.
INLET PIPE _____ FT. BELOW ORIGINAL GRADE. MAXIMUM DEPTH _____ FT. BELOW ORIGINAL GRADE
EFFECTIVE DEPTH AT _____ FT. BELOW ORIGINAL GRADE.
LOCATE DISPOSAL AREA _____ FT. FROM _____ LOT LINE AND _____ FT. FROM _____ LOT LINE AS SHOWN ON
FACING LOT FROM _____

BP SED
#39957

DRAINFIELD-The sewage disposal field will begin at a point 33 ft. from the property line (right lot line), and 195 ft. from the 100 ft. prop. line (Dry Pace Road) as seen from the road. The invert will enter the field at 2 ft. below original grade and the maximum trench depth will not exceed 11 ft. The trenches will have a total combined length of 120 ft., with no trench exceeding 100 ft. in length. Each trench will be 2 ft. wide, contain 6 ft. of stone and run parallel to each other, 20 ft. apart center-to-center to be connected in series. Trenches to follow the contour of the land.

PLANS APPROVED BY R. McFarland DATE _____

COVER NO WORK UNTIL INSPECTED AND APPROVED.

NEITHER THE HOWARD COUNTY COUNCIL NOR THE HEALTH DEPARTMENT IS RESPONSIBLE FOR THE SUCCESSFUL OPERATION OF ANY SYSTEM.

NOTE: IF TRENCH IS USED CALL FOR INSPECTION BEFORE PLACING GRAVEL IN TRENCH.

NOTE: NO DRY WELL SHALL EXCEED 16 FOOT IN DIAMETER.

NOTE: ALL PIPE FROM HOUSE TO DISPOSAL AREA MUST BE CAST IRON.

PERMIT VOID AFTER THREE YEARS.

NOTE: INSTALL STAND PIPE ON SEPTIC TANK AND DRY WELL. STAND PIPES MUST BE 6 INCHES IN DIAMETER. CAST IRON, CONCRETE OR TERRA COTTA ACCEPTED.

*INSTALLER IS RESPONSIBLE FOR OBTAINING FINAL APPROVAL ON THIS PERMIT.

HD - 23


BLDG. PERMITS SIGNED
AND RETURNED 2-4-98
Serial # B109720
Interior Alteration
Basement

FILED
22376

06660

D P O R 3 R P T Y D D

1/26

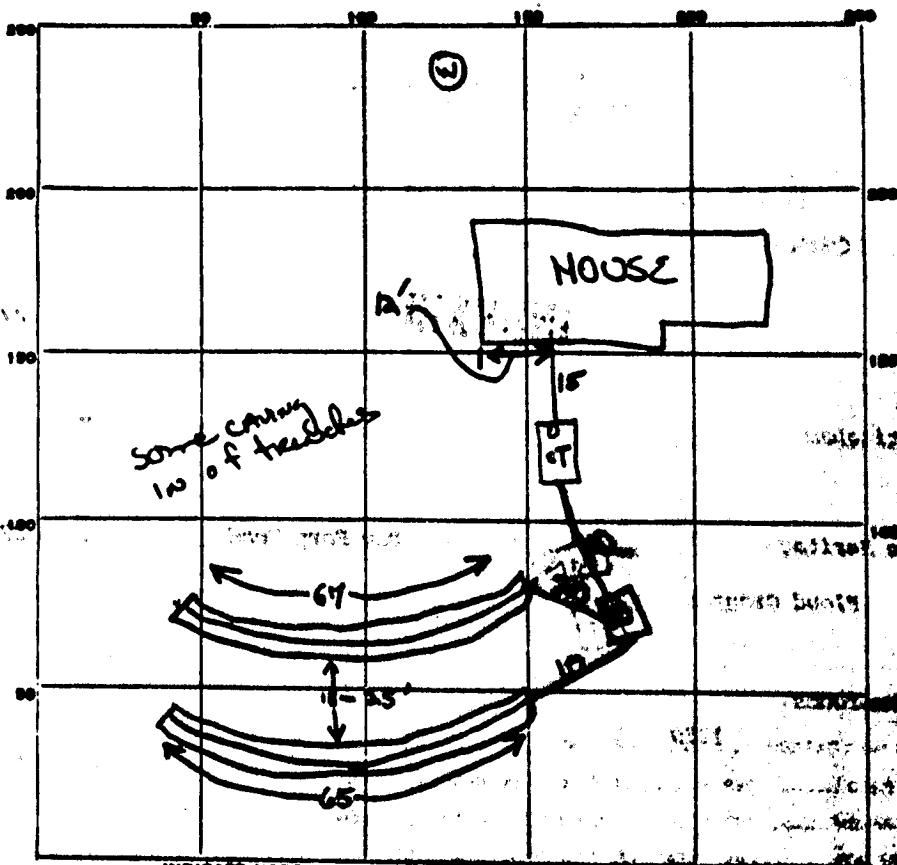

INDICATE NORTH - NAME ADJOINING ROADWAY AS BASE LINE
PIONEER CIRCLE

PERMIT CARD _____

SEPTIC TANK, LEVEL 1250 tapered CLEANOUTS 1

DISTRIBUTION BOX, LEVEL 2x2x1 with balls

TILE FIELD, DEPTH 12 FT. TRENCH WIDTH 2

GRAVEL DEPTH 8 TOTAL LENGTH 132

NUMBER OF TRENCHES 2 TOTAL BOTTOM AREA 10.56

SEEPAGE PITS, INSIDE DIAMETER _____ FT. DEPTH BELOW INLET _____ FT.

ABSORBENT AREA _____ SQ. FT.

REMARKS 18 Apr 79 - Call for final when severs, cleanouts, distribution box
are installed, gravel added to trench, and septic tank can be inspected
for 5120 (GLK) 20 Apr 79 - Call for final when gravel added
to trench. OK to backfill from house to distribution box (GLK)
24 Apr 79 - Final OK. (GLK)

DATE SYSTEM APPROVED 24 Apr 79 INSPECTOR G. Keller

APPLICATION

HOWARD COUNTY

PERMIT APPLICATION

DEPARTMENT OF INSPECTIONS, LICENSES & PERMIT
3430 COURT HOUSE DRIVE, ELLICOTT CITY, MARYLAND 21043

SERIAL NUMBER

B00109720

B00109720

BUILDING ADDRESS (HOUSE NO., STREET, TOWN OR AREA)

14201 Pioneer Circle 31103
Glenely MD 21737

GRADING/SEDIMENT CONTROL YES NO

SDP #

DESCRIPTION OF WORK AUTHORIZED

Finish Basement - Metal studs
& Sheetrock, suspended ceiling to
create (1) rec. room & (1) storage area &
(1) bathroom

LOT NO.	PARCEL NO.	SEC.	AREA	BLOCK NO.	LIBER	FOLIO
27	184	-	-	19	-	-
SUB DIVISION		ZONE	ZONE MAP	ELEC. DIST.	CENSUS TR.	
11E HENDER		R20C	21	5	6051.01	

OWNER NAME AND ADDRESS PHONE NO.
 Synek, John (301) 854-6847
 14201 Pioneer Circle
 Glenely MD 21737

SIZE OF BLDG.	FRONT	DEPTH	HEIGHT
26' x 44'	44'	26'	15'

OCCUPANT'S NAME AND ADDRESS PHONE NO.
 Same as above

TYPE OF BLDG.	AREA	VOLUME	ROOF
B. ROOMS			
ROOMS			
BATHS			
FIREPLACES			

ARCHITECT OR ENGINEER'S NAME AND ADDRESS PHONE NO.

FOOTINGS	FOUNDATION	S. WALLS

CONTRACTOR'S NAME AND ADDRESS PHONE NO.
 Longwood Construction (301) 829-8825
 12311 Jess Smith Rd.
 Mt. Airy MD 21771

UTILITIES					
WATER/WELL	SEWER/SEPTIC	GAS	ELECTRICITY	TYPE OF HEAT	AC

I have carefully examined and read this application and know the same is true and correct, and that in doing this work, all provisions of Howard County Ordinances and the State Laws of Maryland will be complied with, whether specified or not; and I will notify the Department of Inspections, and Permits twenty-four hours in advance when I am ready for the inspections called for elsewhere in the application; and that no work will be covered up until such inspections have been completed with.

EXISTING USE PROPOSED USE
 SFD SFD/w/bsmt

SIGNATURE DATE
 [Signature] 2/4/98

EST. CONSTRUCTION COST LICENSE NUMBER PERMIT FEE
 10,000.00 [Blank] 73.00

W/S CODE

FOR OFFICE USE ONLY

DISTANCE IN FEET FROM R/W LINE TO FRONT BUILDING LINE _____
 SIDE YARD (DISTANCE IN FEET FROM SIDE BLDG. LINE TO SIDE PROPERTY LINE) _____
 TO SIDE BUILDING LINE _____
 DISTANCE IN FEET, REAR YD. REQUIRING SET _____
 BACK (CORNER LOT ONLY) _____

FUNCTION	DATE	SIGNATURE APPROVAL
ZONING/PLANNING		
SHA		
SEDIMENT/GRADING		
BUILDING OFFICIAL		
WATER & SEWER		
HEALTH DEPT.	2/4/98	[Signature]
FIRE PROTECTION		
STORM WATER MGM.		

Check payable to: DIRECTOR OF FINANCE OF HOWARD COUNTY

CAUTION
 To begin construction before a permit placard has been issued and displayed on the job is a violation of the law.
 Use and occupancy permit must be applied for two weeks before it will be issued.

APPROVED [Signature] DATE

IMPORTANT: PLEASE SHOW ZIP CODES AND AREA CODES WHEREVER REQUIRED.

LP-69-591

Distribution of Copies:
 White - Building Official
 Green - Planning & Zoning
 Yellow - Engineering
 Pink - Health Dept.
 Gold - S.H.A.