

6/20/79 lunch
before if possible

Approved 6/20/79
R/H

PERMIT

P 29849
A Repair

SEWAGE DISPOSAL SYSTEM

MARYLAND STATE DEPARTMENT OF HEALTH*

HOWARD COUNTY

03-280098

ELLICOTT CITY

DISTRICT 3rd

INDEXED

DATE 5/21/79

Jack Fyock IS PERMITTED TO INSTALL ALTER X

ADDRESS 13775 Triadelphia Road, Glenelg, Md. PHONE 988-9270

SUBDIVISION _____ ROAD 11120 Douglas Road LOT _____

PROPERTY OWNER Mr. BECKER

ADDRESS Douglas Road, Marriottsville, Md.

SPECIFICATIONS 3 BR

SEPTIC TANK CAPACITY _____ GALLONS
DRAIN FIELD _____ DEPTH _____ FEET, BOTTOM AREA _____ SQ. FT.
DEEP TRENCH _____ DEPTH _____ FEET, BOTTOM AREA _____ SQ. FT.
SEEPAGE PITS _____ ABSORBENT SIDE-WALL AREA _____ SQ. FT.
INLET PIPE _____ FT. BELOW ORIGINAL GRADE. MAXIMUM DEPTH _____ FT. BELOW ORIGINAL GRADE
EFFECTIVE DEPTH AT _____ FT. BELOW ORIGINAL GRADE.
LOCATE DISPOSAL AREA _____ FT. FROM _____ LOT LINE AND _____ FT. FROM _____ LOT LINE AS SEEN WHEN
FACING LOT FROM

REPAIR - Call for an appointment when ground is opened up and Sanitarian will

recommend repair system. 6/20/79 DITCH 71 FT DEEP

OFF STONE 360 SQ FT SIDE WALL AREA

OFF OLD D.W.F.

PLANS APPROVED BY Palmer F. Wine DATE 5/21/79

COVER NO WORK UNTIL INSPECTED AND APPROVED.

NEITHER THE HOWARD COUNTY COUNCIL NOR THE HEALTH DEPARTMENT IS RESPONSIBLE FOR THE SUCCESSFUL OPERATION OF ANY SYSTEM.


- NOTE: IF TRENCH IS USED CALL FOR INSPECTION BEFORE PLACING GRAVEL IN TRENCH.
- NOTE: NO DRY WELL SHALL EXCEED 15 FOOT IN DIAMETER.
- NOTE: ALL PIPE FROM HOUSE TO DISPOSAL AREA MUST BE CAST IRON.

PERMIT VOID AFTER THREE YEARS.

NOTE: INSTALL STAND PIPE ON SEPTIC TANK AND DRY WELL. STAND PIPES MUST BE 6 INCHES IN DIAMETER. CAST IRON, CONCRETE OR TERRA COTTA ACCEPTED.

*INSTALLER IS RESPONSIBLE FOR OBTAINING FINAL APPROVAL ON THIS PERMIT.

P29849

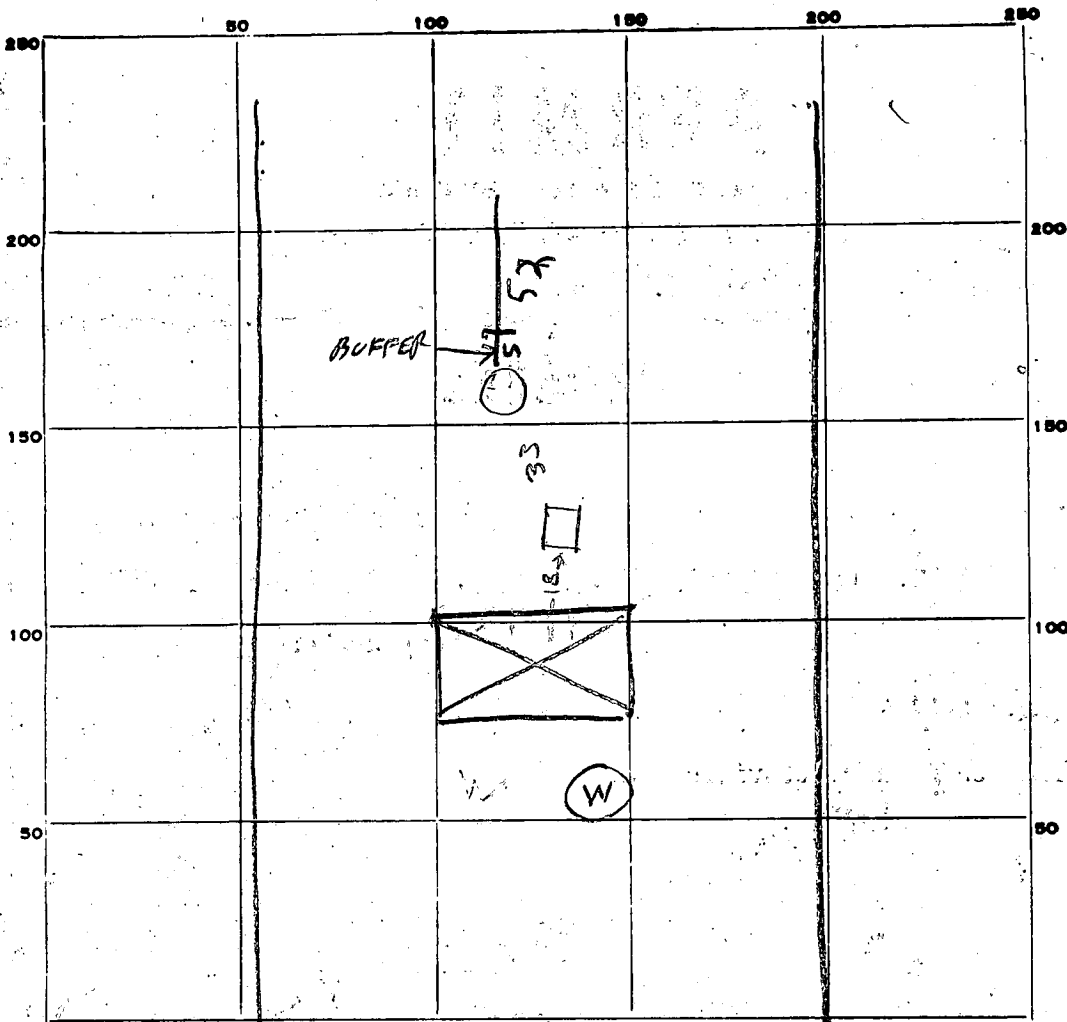

INDICATE NORTH NAME ADJOINING ROADWAY AS BASE LINE
 ← TO MARRIOTTSVILLE DOUGLAS DR

PERMIT CARD _____

SEPTIC TANK, LEVEL _____ CLEANOUTS _____

DISTRIBUTION BOX, LEVEL _____ 50

TILE FIELD, DEPTH 1 1/2 FT. TRENCH WIDTH 2 FT. 8

GRAVEL DEPTH 8.5 IN. TOTAL LENGTH 57 FT.

NUMBER OF TRENCHES 1 TOTAL ^{SIDE} BOTTOM AREA 467

SEEPAGE PITS, INSIDE DIAMETER _____ FT. DEPTH BELOW INLET _____ FT.

ABSORBENT AREA _____ SQ. FT.

REMARKS 6/20/79 AM SOIL VERY SANDY & 11 1/2 FT 50

DEEP DITCH DUG AM

6/20/79 PM - STONE & PIPE ADDED TO DITCH

DATE SYSTEM APPROVED 6/20/79

INSPECTOR Raymond Hodger

incomplete
Not satisfactory
4/1/64
6/1/64

PERMIT

SEWAGE DISPOSAL SYSTEM

4/1/64
8.

P. _____
A. _____

HOWARD COUNTY

ELLICOTT CITY

INDEXED

DISTRICT _____

DATE _____

IS PERMITTED TO INSTALL A _____

ADDRESS _____ PHONE _____

A SEWAGE DISPOSAL SYSTEM LOCATED AT _____

SUBDIVISION _____ ROAD _____ LOT _____

PROPERTY OWNER _____

ADDRESS _____

SPECIFICATIONS _____

DRAIN FIELD _____ DEPTH _____ FEET, BOTTOM AREA _____ SQ. FT.

SEWAGE PITS _____ ABSORBENT SIDE-WALL AREA _____ SQ. FT.

SEPTIC TANK CAPACITY _____ GALLONS

FOR GARBAGE GRINDER, INCREASED DISPOSAL AREA _____

OTHER _____

(For example 12 ft. in diameter and 15 ft. long below ground.)
Place the dry well 100 ft. to 200 ft. from the house and _____
along the front lot line and in the center of the lot.

PLANS APPROVED BY _____ DATE _____


FILL SEPTIC TANK AND DISTRIBUTION BOX WITH WATER BEFORE CALLING FOR AN INSPECTION. COVER NO WORK UNTIL INSPECTED AND APPROVED.

NEITHER THE HOWARD COUNTY COMMISSIONERS NOR THE HEALTH DEPARTMENT IS RESPONSIBLE FOR THE SUCCESSFUL OPERATION OF ANY SYSTEM.

E.L.D. Rise
Jeanette
John

12/19/63

3.74
 11
 638
 37.687
 31.407
 2880

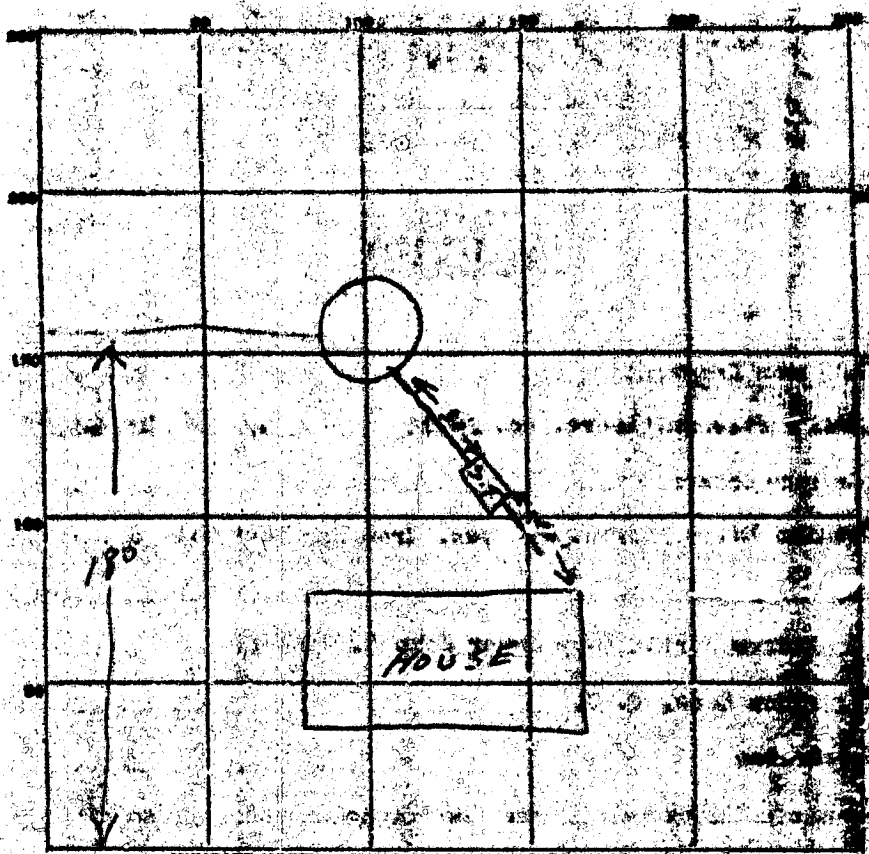

INDICATE NORTH - NAME ADJOINING ROADWAY AS BASE LINE
 DOUGLAS ROAD

PERMIT CARD OK
 SEPTIC TANK LEVEL OK INCREMENTS OK
 DISTRIBUTION BOX LEVEL OK
 TILE FIELD, DEPTH _____ FT. TRENCH WIDTH _____ FT.
 GRAVEL DEPTH _____ IN. TOTAL LENGTH _____ FT.
 NUMBER OF TRENCHES _____ TOTAL BOTTOM AREA _____
 SEEPAGE PITS, INSIDE DIAMETER 10 FT. DEPTH BELOW INLET 9 FT.
 ABSORBENT AREA 222 SQ. FT.

REMARKS 6/15/64 Well to wall diameter 15" 3ft of footage
Dry Well top not properly set. Six inches of stone around
dry well has required. Several need to be laid to top
course of block. Right hand side of Dry Well in the side
that does not have 6" of gravel. J.D.L.

DATE SYSTEM APPROVED 6/15/64 INSPECTOR Thomas J. Starnil



← TO MARANTHIALE
 DOUGLAS RD

DATE	TEST NO.	DEPTH	PNEUMET.		TEST - 1" DIAM.		TIME
			START	STOP	START	STOP	
12/18/89	1	3 1/2	137	142	142	152	10
"	2	4 1/2	138	152	10 inch Holes		
"	3	11	Hole @ King's Canyon		NO APPROPRIATE		

SOIL AUGER FINDING _____
 TESTED BY Raymond Hodges
 REMARKS _____
 ALSO PRESENT BY Ann D. LOT NO. _____

APPLICATION

SEWAGE DISPOSAL TESTING

MARYLAND STATE DEPARTMENT OF HEALTH

HOWARD COUNTY *750 Ballon Tank*

ELLICOTT CITY

Dry Well - 325 soft sidewall

DISTRICT _____

DATE *12-16-65*

*Area below the top of clay
(5' or more 12 ft. in diameter and 12 ft. deep below grade)
Place the drywell 150 ft. to 180 ft. from the
barbed wire fence along the front lot line
at the center of the lot*

TO: THE COUNTY HEALTH OFFICER
ELLICOTT CITY, MARYLAND

I, HEREBY, APPLY FOR THE NECESSARY TESTS IN ORDER TO CONSTRUCT OR RECONSTRUCT A SEWAGE DISPOSAL SYSTEM.

PROPERTY OWNER

Andrew Harbin

ADDRESS

St. Johns Lane

PHONE _____

PROPERTY LOCATION

SUBDIVISION _____

LOT NO. _____

ROAD AND DESCRIPTION

*Douglas Rd - approx 300 yds from
Manisteeville Rd on left.*

OCCUPANT _____

PHONE _____

PERSON TO CONSTRUCT SYSTEM

ADDRESS _____

PHONE _____

SIZE OF LOT

100' x 400'

TYPE BLDG

3

NUMBER OF UNITS _____

IF NOT SINGLE RESIDENCE DESCRIBE _____

SIGNATURE OF APPLICANT

John P. Butler

*8236 N. Brandegee Rd
Belt 22-23*

APPROVED

Raymond Hodges

FOR

Dry Well

DATE

19 DEC 1965

REJECTED BY _____

FOR _____

REASON OF REJECTION _____

DATE _____

HOLD PENDING FURTHER TESTS _____

DATE _____

REASONS FOR REJECTION OR HOLDING _____

THIS IS NOT A PERMIT