

12/6/79
afternoon please

12/7/79
afternoon please

approved 12/10/79

J. Stayer

P 29881

PERMIT

SEWAGE DISPOSAL SYSTEM

MARYLAND STATE DEPARTMENT OF HEALTH*

A REPAIR

HOWARD COUNTY

ELLICOTT CITY

DISTRICT _____

DATE 5/31/79

12/10/79

INDEXED

INSTALLER-CONDON

Mr. Randall Rowe

975-2441

IS PERMITTED TO INSTALL

ALTER

ADDRESS _____

PHONE _____

SUBDIVISION _____

ROAD 3698 Shady Lane

LOT _____

PROPERTY OWNER Mr. Randall Rowe

ADDRESS _____

SPECIFICATIONS 3 bedroom house

SEPTIC TANK CAPACITY 1000 GALLONS

DRAIN FIELD _____ DEPTH _____ FEET, BOTTOM AREA _____ SQ. FT.

DEEP TRENCH DEPTH 10 1/2 FEET, BOTTOM AREA _____ SQ. FT.

SEEPAGE PITS _____ ABSORBENT SIDE-WALL AREA _____ SQ. FT.

INLET PIPE _____ FT. BELOW ORIGINAL GRADE, MAXIMUM DEPTH _____ FT. BELOW ORIGINAL GRADE

EFFECTIVE DEPTH AT _____ FT. BELOW ORIGINAL GRADE.

LOCATE DISPOSAL AREA _____ FT. FROM _____ LOT LINE AND _____ FT. FROM _____ LOT LINE AS SEEN WHEN FACING LOT FROM

REPAIR-CALL FOR INSPECTION WHEN GROUND IS OPENED UP SO SANITARIAN CAN RECOMMEND

REPAIR SYSTEM. 12/4/79 DEEP DITCH 10 1/2 FT DEEP 2 FT

WIDE 7 FT STONE (460 SQ FT) 66 FT LONG

PLACE DITCH 15 FT FROM THE FENCE IN FRONT OF THE HOUSE

PLANS APPROVED BY Palmer F. Wine

DATE 5/31/79

COVER NO WORK UNTIL INSPECTED AND APPROVED.

PARALLEL TO THE FENCE

NEITHER THE HOWARD COUNTY COUNCIL NOR THE HEALTH DEPARTMENT IS RESPONSIBLE FOR THE SUCCESSFUL OPERATION OF ANY SYSTEM.

NOTE: IF TRENCH IS USED CALL FOR INSPECTION BEFORE PLACING GRAVEL IN TRENCH.

NOTE: NO DRY WELL SHALL EXCEED 15 FOOT IN DIAMETER. THE FENCE IS LOCATED

NOTE: ALL PIPE FROM HOUSE TO DISPOSAL AREA MUST BE CAST IRON. ABOUT 170 FT

PERMIT VOID AFTER THREE YEARS.

IN FRONT OF THE HOUSE

NOTE: INSTALL STAND PIPE ON SEPTIC TANK AND DRY WELL. STAND PIPES MUST BE 6 INCHES IN DIAMETER, CAST IRON, CONCRETE OR TERRA COTTA ACCEPTED. SEE DRAWING ON BACK OF


*INSTALLER IS RESPONSIBLE FOR OBTAINING FINAL APPROVAL ON THIS PERMIT.

HD - 23

COM DRAIN SHEET

SEWAGE LIFT PUMP NEEDED HERE

P 29881

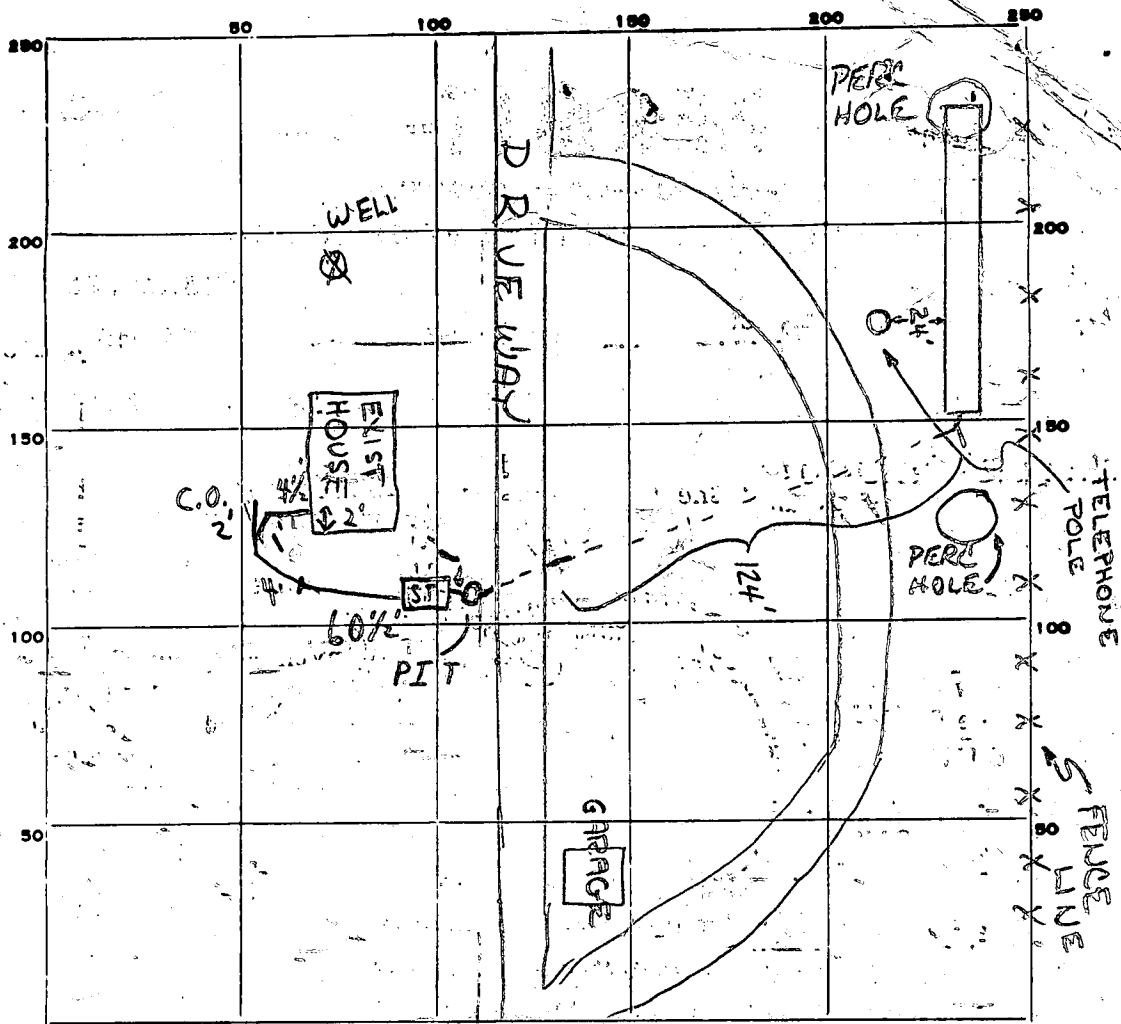

INDICATE NORTH. - NAME ADJOINING ROADWAY AS BASE LINE.

PERMIT CARD

SEPTIC TANK, LEVEL CLEANOUTS S.T. - cast iron

DISTRIBUTION BOX, LEVEL _____

TILE FIELD, DEPTH 10 1/2' FT. TRENCH WIDTH 2 FT.

GRAVEL DEPTH 7 1/2' IN. TOTAL LENGTH 80 FT.

NUMBER OF TRENCHES 1 TOTAL BOTTOM AREA 600

SEEPAGE PITS, INSIDE DIAMETER _____ FT. DEPTH BELOW INLET _____ FT.

ABSORBENT AREA 600 SQ. FT.

REMARKS 12/6/79 - OK TO ADD GRAVEL TO TRENCH. CHECK TO SEE IF 2" PLASTIC PIPE IS OK TO RUN UNDER DRIVEWAY AT 2'-3' R.D. - PLASTIC PIPE MUST BE ENCASED, CALLED INSTALLER LEFT MESSAGE TO ENCASE IT. 12/6/79

12/7/79 TRENCH OK TO COVER TO 3' OF AREA OF CONNECTION. FROM 4:10 PM P.M.

SEPTIC TANK AREA - OK TO COVER LINE* TO 1' OF PIT; OK TO COVER FROM SAND TO 1' OF EITHER END OF C.I. PIPE UNDER DRIVEWAY'S HOUSE TO THE SEPTIC TANK AND TO PIT. CALLED OK TO COVER LINE EXCEPT FOR ABOVE AREAS NOTED. DISCUSSED WITH MR WINE VIA MR CONDON'S PHONE IN

DATE SYSTEM APPROVED 12/10/79 INSPECTOR [Signature]

TRUCK. P.M. TO CALL FOR FINAL. C.B.D. 12/10/79 OK to cover all work

PERMIT

P 29882

A REPAIR

SEWAGE DISPOSAL SYSTEM

MARYLAND STATE DEPARTMENT OF HEALTH*

HOWARD COUNTY

ELLICOTT CITY

DISTRICT _____

DATE 5/31/79

Mr. Randall Rowe IS PERMITTED TO INSTALL ALTER X

ADDRESS 3608 Shady Lane PHONE _____

SUBDIVISION _____ ROAD 3698 Shady Lane LOT _____

PROPERTY OWNER Mr. Randall Rowe

ADDRESS _____

SPECIFICATIONS 1 bedroom house

SEPTIC TANK CAPACITY 1000 GALLONS

DRAIN FIELD _____ DEPTH _____ FEET, BOTTOM AREA _____ SQ. FT.

DEEP TRENCH _____ DEPTH _____ FEET, BOTTOM AREA _____ SQ. FT.

SEEPAGE PITS _____ ABSORBENT SIDE-WALL AREA _____ SQ. FT.

INLET PIPE _____ FT. BELOW ORIGINAL GRADE. MAXIMUM DEPTH _____ FT. BELOW ORIGINAL GRADE

EFFECTIVE DEPTH AT _____ FT. BELOW ORIGINAL GRADE.

LOCATE DISPOSAL AREA _____ FT. FROM _____ LOT LINE AND _____ FT. FROM _____ LOT LINE AS SEEN WHEN FACING LOT FROM

REPAIR-CALL FOR INSPECTION WHEN GROUND IS OPENED UP SO SANITARIAN CAN RECOMMEND

REPAIR SYSTEM.

PLANS APPROVED BY Palmer F. Wine DATE 5/31/79

COVER NO WORK UNTIL INSPECTED AND APPROVED.

NEITHER THE HOWARD COUNTY COUNCIL NOR THE HEALTH DEPARTMENT IS RESPONSIBLE FOR THE SUCCESSFUL OPERATION OF ANY SYSTEM.

NOTE: IF TRENCH IS USED CALL FOR INSPECTION BEFORE PLACING GRAVEL IN TRENCH.

NOTE: NO DRY WELL SHALL EXCEED 15 FOOT IN DIAMETER.

NOTE: ALL PIPE FROM HOUSE TO DISPOSAL AREA MUST BE CAST IRON.


PERMIT VOID AFTER THREE YEARS.

NOTE: INSTALL STAND PIPE ON SEPTIC TANK AND DRY WELL. STAND PIPES MUST BE 8 INCHES IN DIAMETER. CAST IRON, CONCRETE OR TERRA COTTA ACCEPTED.

BLDG. PERMIT SIGNED
AND RETURNED 9/4/81

Serial # 47672
Mobile home

*INSTALLER IS RESPONSIBLE FOR OBTAINING FINAL APPROVAL ON THIS PERMIT.

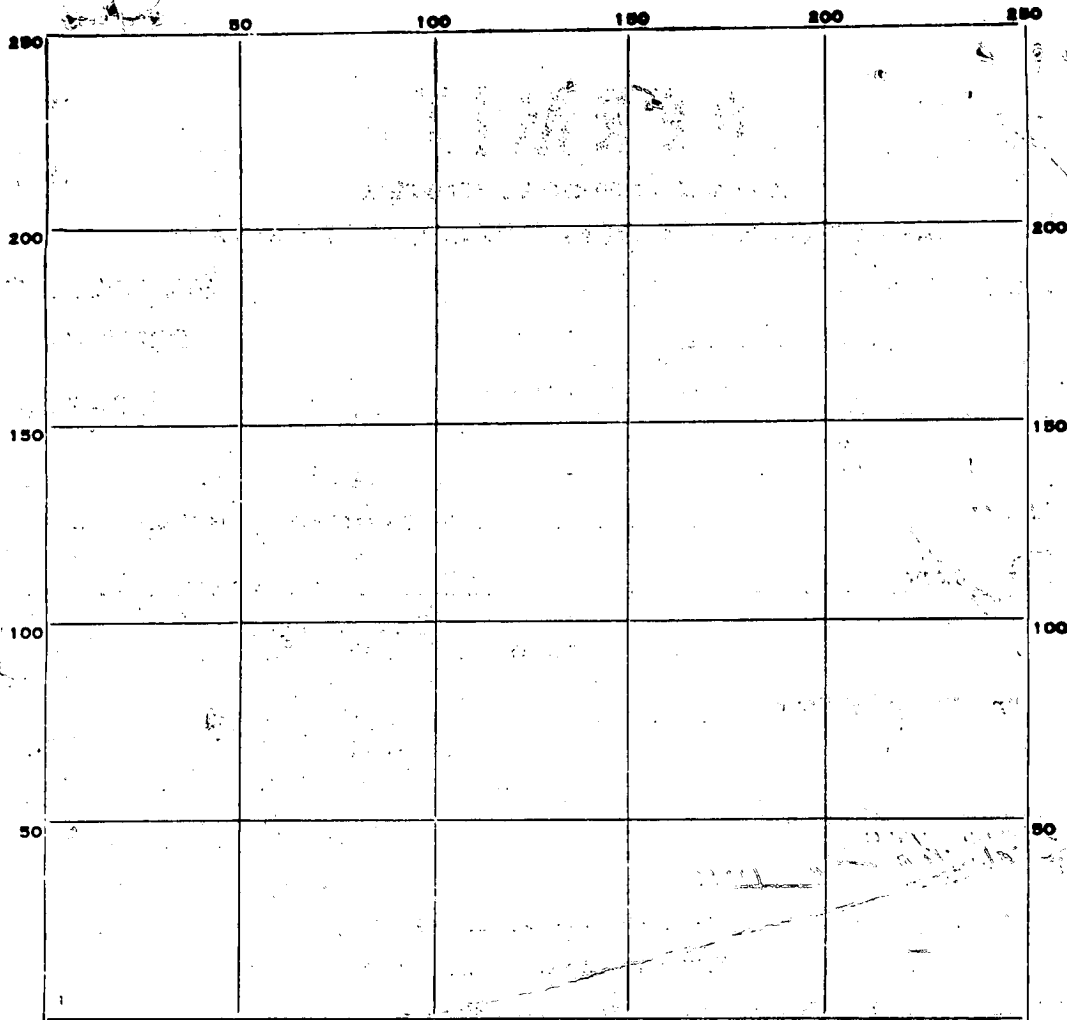

INDICATE NORTH — NAME ADJOINING ROADWAY AS BASE LINE.

PERMIT CARD _____

SEPTIC TANK, LEVEL _____ CLEANOUTS _____

DISTRIBUTION BOX, LEVEL _____

TILE FIELD, DEPTH _____ FT. TRENCH WIDTH _____ FT.

GRAVEL DEPTH _____ IN. TOTAL LENGTH _____ FT.

NUMBER OF TRENCHES _____ TOTAL BOTTOM AREA _____

SEEPAGE PITS, INSIDE DIAMETER _____ FT. DEPTH BELOW INLET _____ FT.

ABSORBENT AREA _____ SQ. FT.

REMARKS _____


DATE SYSTEM APPROVED _____ INSPECTOR _____

66
 $\frac{66}{2} = 33$
 607/460
 92
 40

66
 $\frac{66}{2} = 33$

66
 $\frac{66}{2} = 33$

66
 $\frac{66}{2} = 33$
 7/460
 40

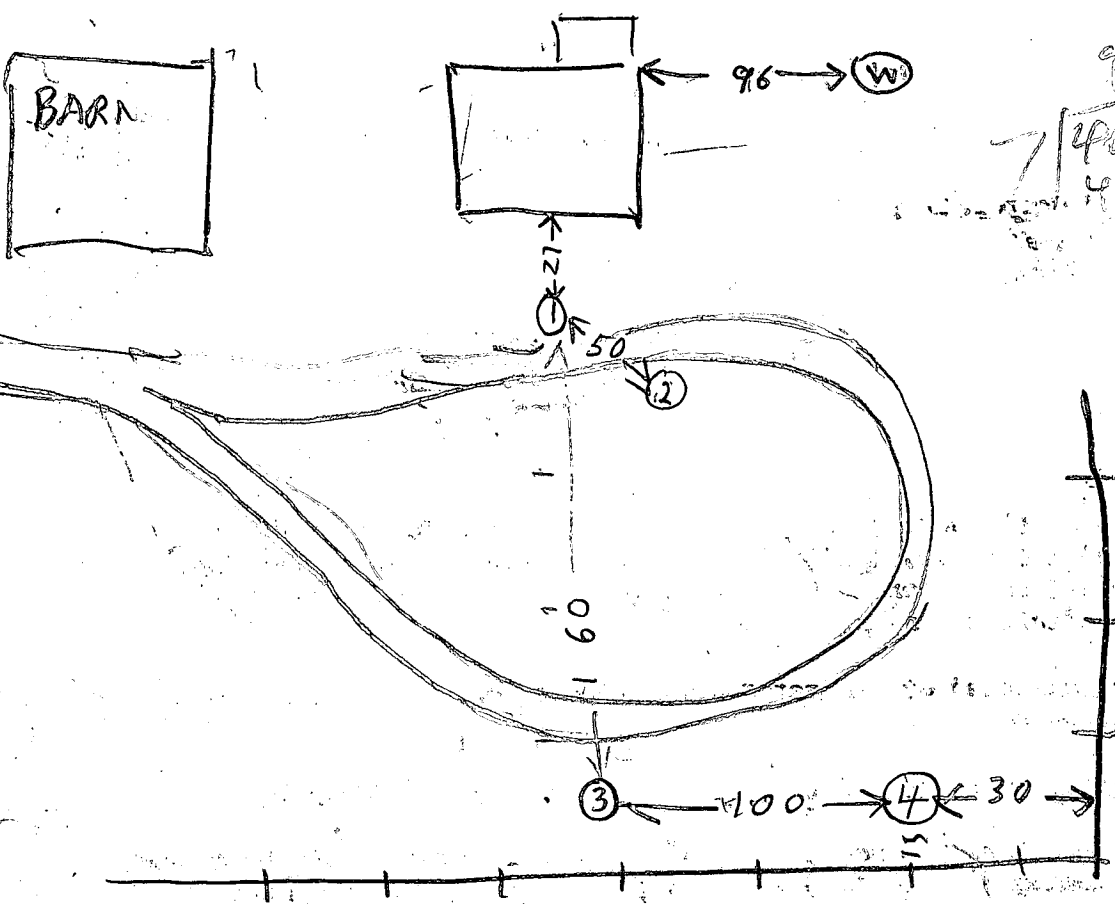

45
 $\frac{360}{40} = 9$

12/5/79

1S	3 1/2	230	233	233	236
1V	9	ALL SANDY BOT ROCK BOTTOM			
2V	7	ALL SANDY BOT ROCK BOTTOM			
3V	12	TOP 3 1/2 FT CLAY BOT 8 1/2 FT SAND			
4V	12	TOP 5 FT CLAY BOT 7 FT SAND			

Lotestart Real Estate
 Agent Late RH

also present Norman London Backhoe
 Mike Marden " " "
 Realtor Sharon Barotski
BUYER Dr ERNEST COLVON
OWNER Gladwin Bedford Corp

