

6/11/76 Approved
nb & d'w
June 11 1976

PERMIT

SEWAGE DISPOSAL SYSTEM

P 23376

A _____

MARYLAND STATE DEPARTMENT OF HEALTH

HOWARD COUNTY

ELLICOTT CITY

INDEXED

DISTRICT 4th

DATE 6/10/76

Jack Fyock

IS PERMITTED TO INSTALL _____ ALTER

ADDRESS 13775 Triadelphia Road, Glenelg, Maryland PHONE 988-9270

A SEWAGE DISPOSAL SYSTEM LOCATED AT _____

SUBDIVISION _____ ROAD Hobbs Road - from Burnt-woods turn right on Hobbs ROAD

PROPERTY OWNER Mr. Hubbard LOT Road - 1st house on left

ADDRESS Hobbs Road, Glenelg, Maryland

SPECIFICATIONS

DRAIN FIELD _____ DEPTH _____ FEET, BOTTOM AREA _____ SQ. FT.

SEEPAGE PITS _____ ABSORBENT SIDE-WALL AREA _____ SQ. FT.

SEPTIC TANK CAPACITY _____ GALLONS

FOR GARBAGE GRINDER, INCREASE DISPOSAL AREA 22% & TANK CAPACITY 30%.

OTHER REPAIR - Call for inspection when ground is opened up so Sanitarian can

recommend repair system. → 10' trench 5' of stone box - 420#


effective Sept running perpendicular to Hobbs Rd

PLANS APPROVED BY Palmer Wine DATE 6/10/76

FILL SEPTIC TANK AND DISTRIBUTION BOX WITH WATER BEFORE CALLING FOR AN INSPECTION. COVER NO WORK UNTIL INSPECTED AND APPROVED.

NEITHER THE HOWARD COUNTY COMMISSIONERS NOR THE HEALTH DEPARTMENT IS RESPONSIBLE FOR THE SUCCESSFUL OPERATION OF ANY SYSTEM.

A 23376

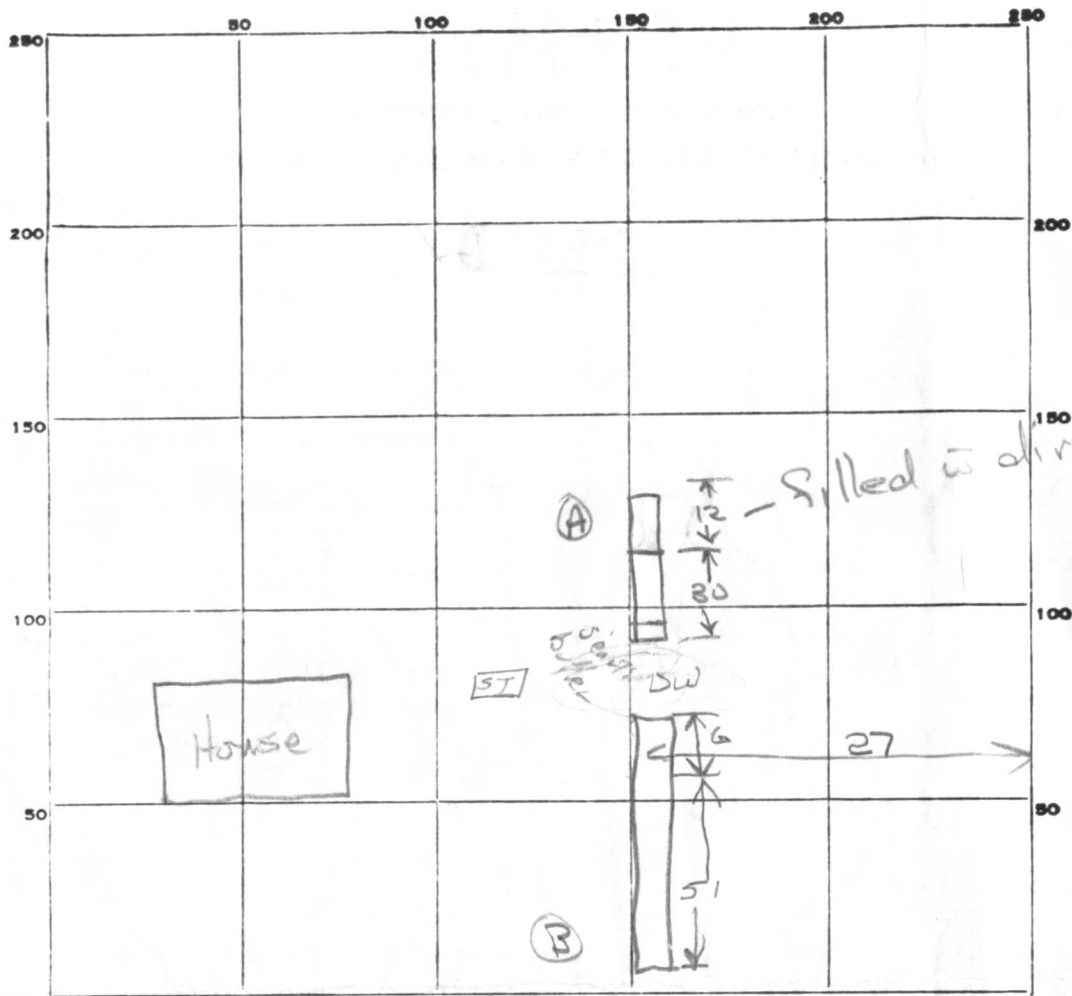

51
 - 2
 357

 25
 - 5
 125

 125
 357
 582

INDICATE NORTH. - NAME ADJOINING ROADWAY AS BASE LINE.

Hobbs Rd

property line

PERMIT CARD Final

SEPTIC TANK, LEVEL NA CLEANOUTS NA

DISTRIBUTION BOX, LEVEL NA

TILE FIELD, DEPTH 8/12 FT. TRENCH WIDTH 2 FT.

GRAVEL DEPTH 5/7 FT. TOTAL LENGTH 76 FT.

NUMBER OF TRENCHES 2 one side TOTAL BOTTOM AREA 582

SEEPAGE PITS, INSIDE DIAMETER _____ FT. DEPTH BELOW INLET _____ FT.

ABSORBENT AREA _____ SQ. FT.

REMARKS June 11 1976 At 1:50 - trench A discontinued hit rock - moved up hill and installed trench B

DATE SYSTEM APPROVED June 11 1976 1:50 INSPECTOR DON & hb