

HOWARD COUNTY
 PERMIT APPLICATION

PERMIT NUMBER
 307002620

Building Address 11910 Falside Road
ELLICOTT CITY, MD 21042
 Suite/Apt. #: _____ SDPWP/Petition #: _____
 Census Tract _____ Subdivision _____
 Section _____ Area _____ Lot _____
 Tax Map _____ Parcel _____ Grid _____
 Zoning _____ Map Coordinates _____ Lot size _____

Property Owner's Name FLOYD + MYRNA MALVEAUX
 Address 11910 Falside Road
 City ELLICOTT CITY State MD Zip Code 21042
 Home Phone (301) 596-5056 Work Phone _____
 Applicant's Name & Mailing Address (if other than stated hereon):
BRETT SCHOOLNICK
 Phone (410) 995-6363 Fax (410) 992-3211

Existing Use Single Family Dwelling
 Proposed Use SFD
 Estimated Construction Cost \$ 55,000.00
 Description of Work Remodel Hall Bathroom
(48 s.f.) Convert Ext. Porch
(12 x 16) into SUNROOM

Contractor Company Baywood Design Build
 Contact Person BRETT SCHOOLNICK
 Address 5550 STARRH PLACE Ste. 100
 City Columbia State MD Zip Code 21044
 License No. 21664
 Phone (410) 995-6363 Fax (410) 992-3211

Occupant or Tenant Owner
 Contact Name _____
 Address see above
 City _____ State _____ Zip Code _____
 Phone _____ Fax _____

Engineer or Architect Company _____
 Contact Person _____
 Address _____
 City _____ State _____ Zip Code _____
 Phone _____ Fax _____

BUILDING DESCRIPTION - COMMERCIAL

BUILDING DESCRIPTION - RESIDENTIAL

Building Characteristics	Utilities
Height: _____	Water Supply: _____ _____ Public _____ Private
No. of stories: _____	Sewage Disposal: _____ _____ Public _____ Private
Gross area, sq. ft. per floor: _____	Electric Yes <input type="checkbox"/> No <input type="checkbox"/> Gas Yes <input type="checkbox"/> No <input type="checkbox"/>
Use group: _____	Heating System: _____ Electric <input type="checkbox"/> Oil <input type="checkbox"/> Natural Gas <input type="checkbox"/> Propane Gas <input type="checkbox"/>
Construction type: _____ _____ Reinforced Concrete _____ Structural Steel _____ Masonry _____ Wood Frame _____ State Certified Modular	Sprinkler system: N/A <input type="checkbox"/> _____ Full _____ Partial _____ Other Suppression _____ # of Heads

Building Characteristics	Utilities
SF Dwelling <input checked="" type="checkbox"/> SF Townhouse <input type="checkbox"/> _____ Depth _____ Width _____	Water Supply: _____ _____ Public _____ Private
1st floor: _____	Sewage Disposal: _____ _____ Public _____ Private
2nd floor: _____	Electric Yes <input type="checkbox"/> No <input type="checkbox"/> Gas Yes <input type="checkbox"/> No <input type="checkbox"/>
Basement: _____	Heating System: _____ Electric <input type="checkbox"/> Oil <input type="checkbox"/> Natural Gas <input type="checkbox"/> Propane Gas <input type="checkbox"/>
Finished Basement <input type="checkbox"/> Unfinished Basement <input type="checkbox"/> Crawl space <input type="checkbox"/> Slab on Grade <input type="checkbox"/> No. of Bedrooms _____ Height: _____ Multi-family dwellings: No. of efficiency units: _____ No. of 1 BR units: _____ No. of 2 BR units: _____ No. of 3 BR units: _____	Sprinkler system: N/A <input type="checkbox"/> _____ NFPA #13D _____ NFPA #13R _____ Other:
Other Structure: _____ Dimensions: _____ Footings: _____ Roof Height: _____ _____ State Certified Modular _____ Manufactured Home	

THE UNDERSIGNED HEREBY CERTIFIES AND AGREES AS FOLLOWS: (1) THAT HE/SHE IS AUTHORIZED TO MAKE THIS APPLICATION; (2) THAT THE INFORMATION IS CORRECT; (3) THAT HE/SHE WILL COMPLY WITH ALL REGULATIONS OF HOWARD COUNTY WHICH ARE APPLICABLE THERETO; (4) THAT HE/SHE WILL PERFORM NO WORK ON THE ABOVE REFERENCED PROPERTY NOT SPECIFICALLY DESCRIBED IN THIS APPLICATION; (5) THAT HE/SHE GRANTS COUNTY OFFICIALS THE RIGHT TO ENTER ONTO THIS PROPERTY FOR THE PURPOSE OF INSPECTING THE WORK PERMITTED AND POSTING NOTICES.

Applicant's Signature
The Baywood Design Build Group, Inc.
 Title/Company

Print Name Brett Schoolnick
President
 Date _____


Checks payable to: **DIRECTOR OF FINANCE OF HOWARD COUNTY**
 ** PLEASE WRITE NEATLY AND LEGIBLY. **

FOR OFFICE USE ONLY

AGENCY	DATE	SIGNATURE	APPROVAL
Land Development, DPZ			
State Highways			
Building Official			
Dev. Engineering, DPZ			
Health	<u>6/21/07</u>	<u>R. Buiha</u>	
Fire Protection			
Is Sediment Control approval required prior to issuance? YES <input type="checkbox"/> NO <input type="checkbox"/>			
CONTINGENCY CONSTRUCTION START: <input type="checkbox"/>			
ONE STOP SHOP: <input type="checkbox"/>			
Distribution of Copies- White: Building Official Green: LDD, DPZ			

DPZ SETBACK INFORMATION	PROPERTY ID#
Front: _____	Filing fee \$ _____
Rear: _____	Permit fee \$ _____
Side: _____	Excise tax \$ _____
Side St.: _____	Add'l per. fee \$ _____
All minimum setbacks met? YES <input type="checkbox"/> NO <input type="checkbox"/>	TOTAL FEES \$ _____
Is Entrance Permit required? YES <input type="checkbox"/> NO <input type="checkbox"/>	Sub-total paid \$ _____
Historic District? YES <input type="checkbox"/> NO <input type="checkbox"/>	Balance due \$ _____
Lot Coverage for NewTown Zone _____	Check # _____
SDP/Red-line approval date _____	Validation # _____
Accepted by _____	

1" = 60'

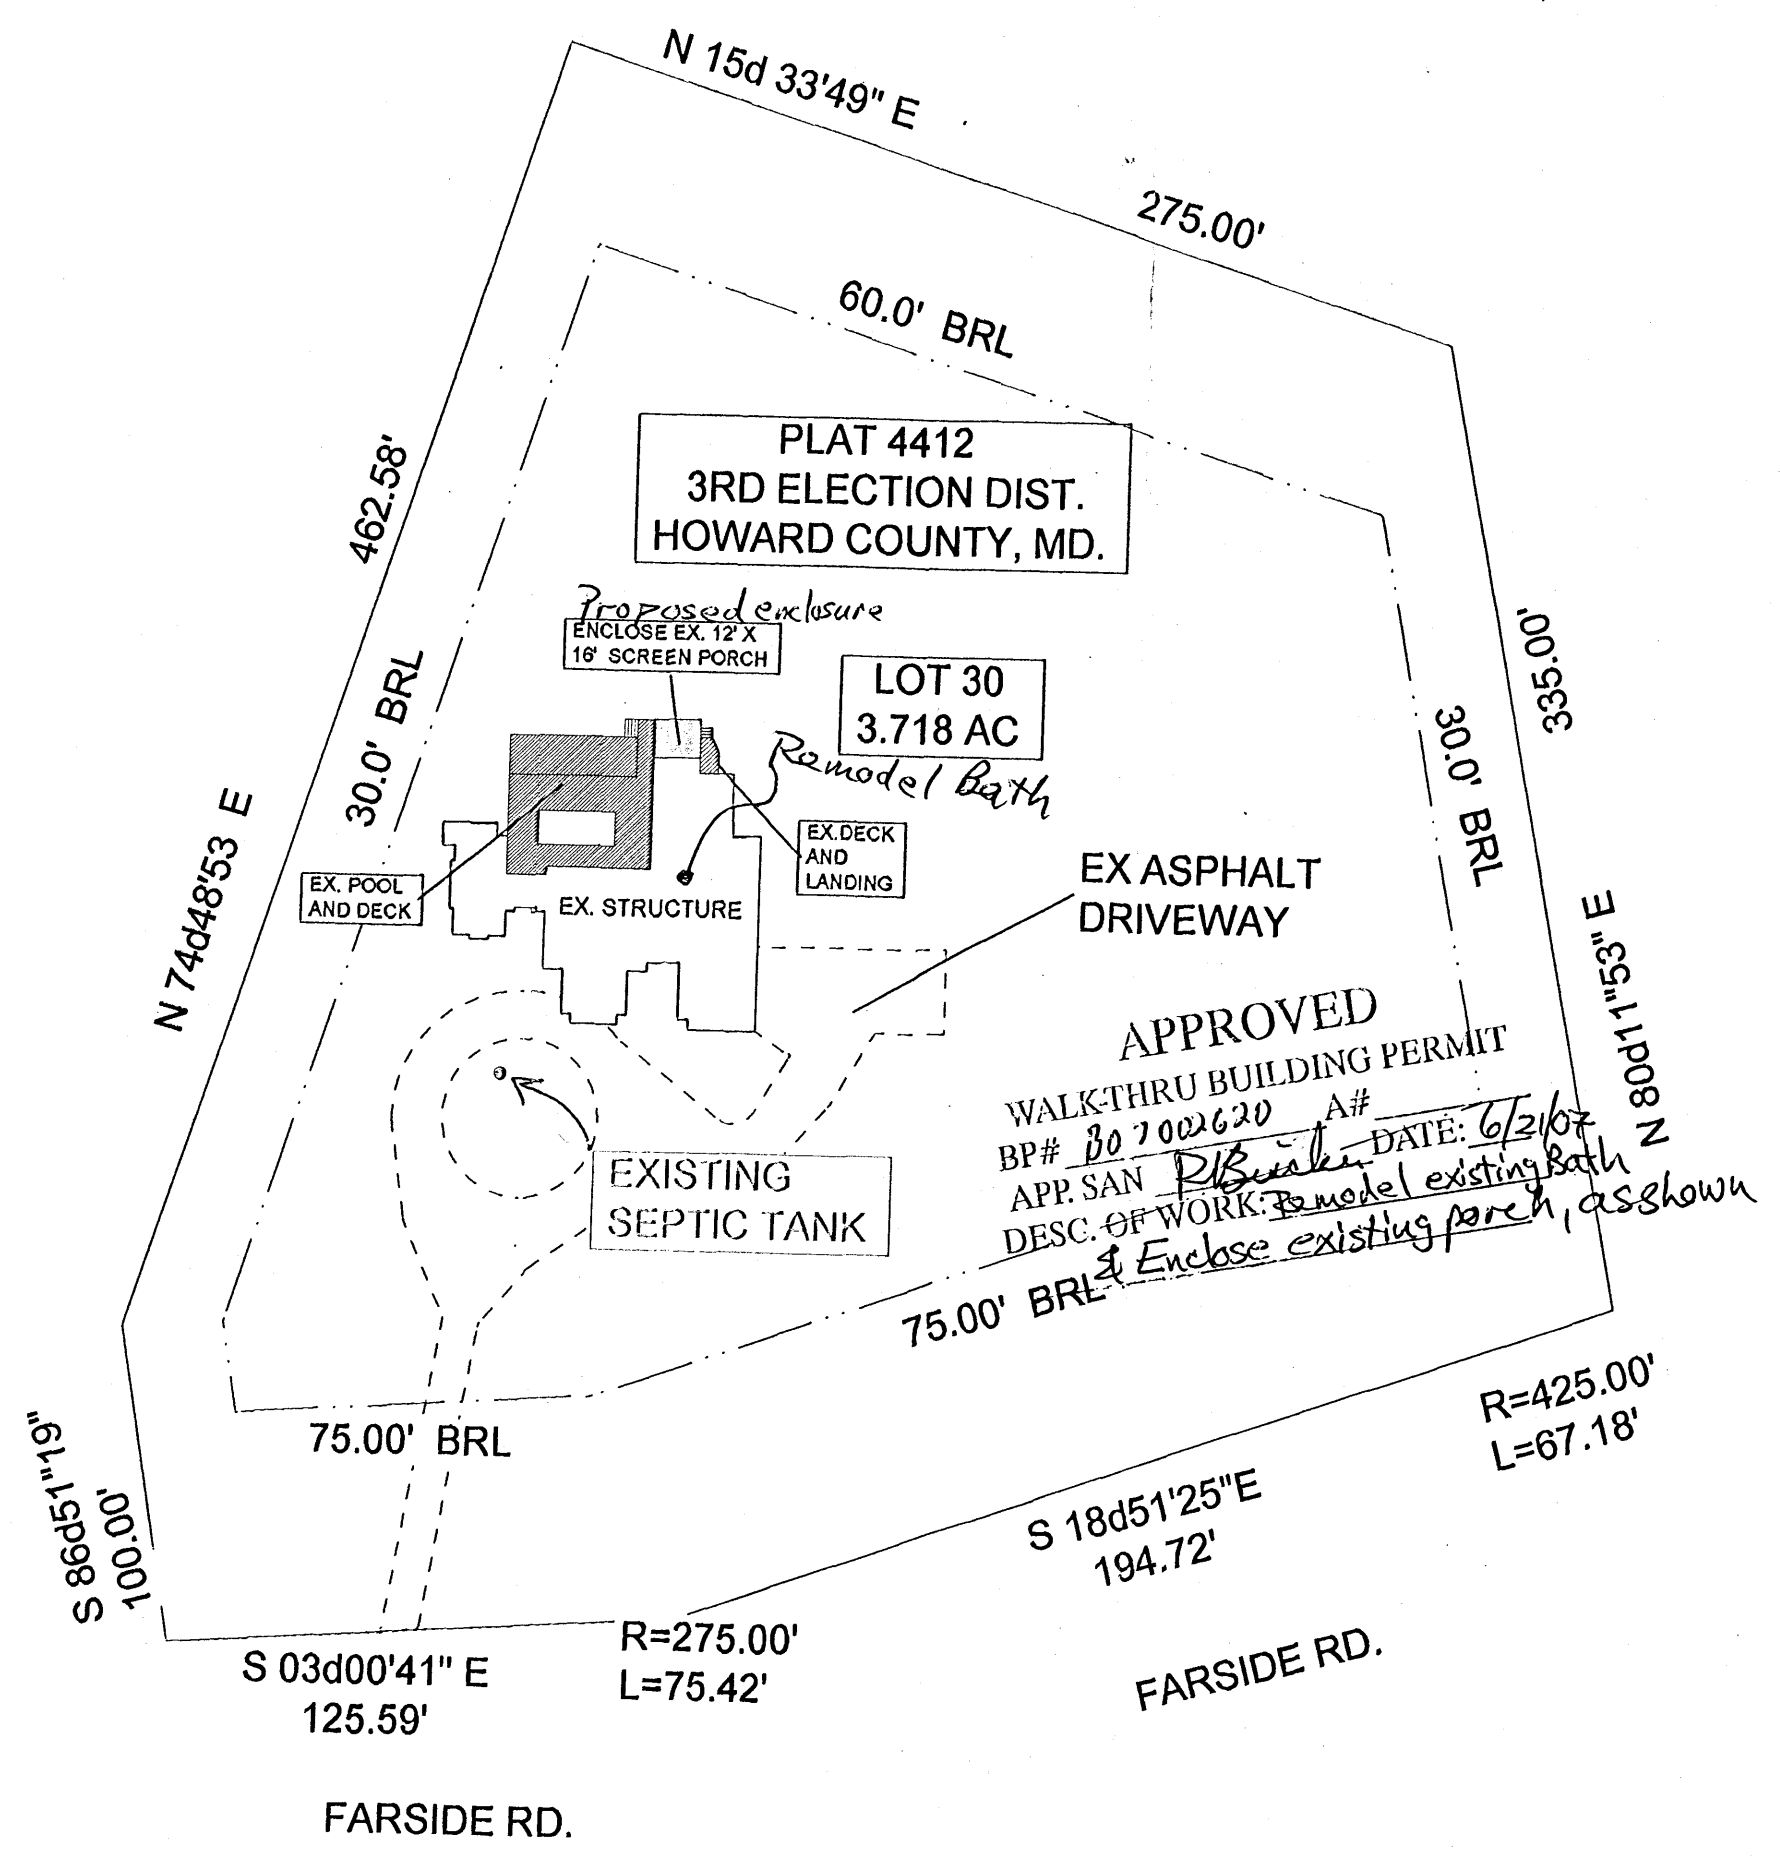

COPYRIGHT 2007
 THE BAYWOOD DESIGN/BUILD GROUP, INC.
 ALL RIGHTS RESERVED
 No use or intended use
 without expressed written approval

**MALVEAUX
 SUNROOM & BATH**

The Baywood Design/Build Group, Inc.
 5550 Sterrett Place Suite 100
 Columbia, MD 21044
 410.995.6363 Fax 410.992.3211

not to scale

275'

± 200'

*well

± 50'

fence

± 200'

pool

House

FRONT

□ septic tank


8/6/82
Sketch OK for pool
G.S.

526'

335'

400'

Farside Rd

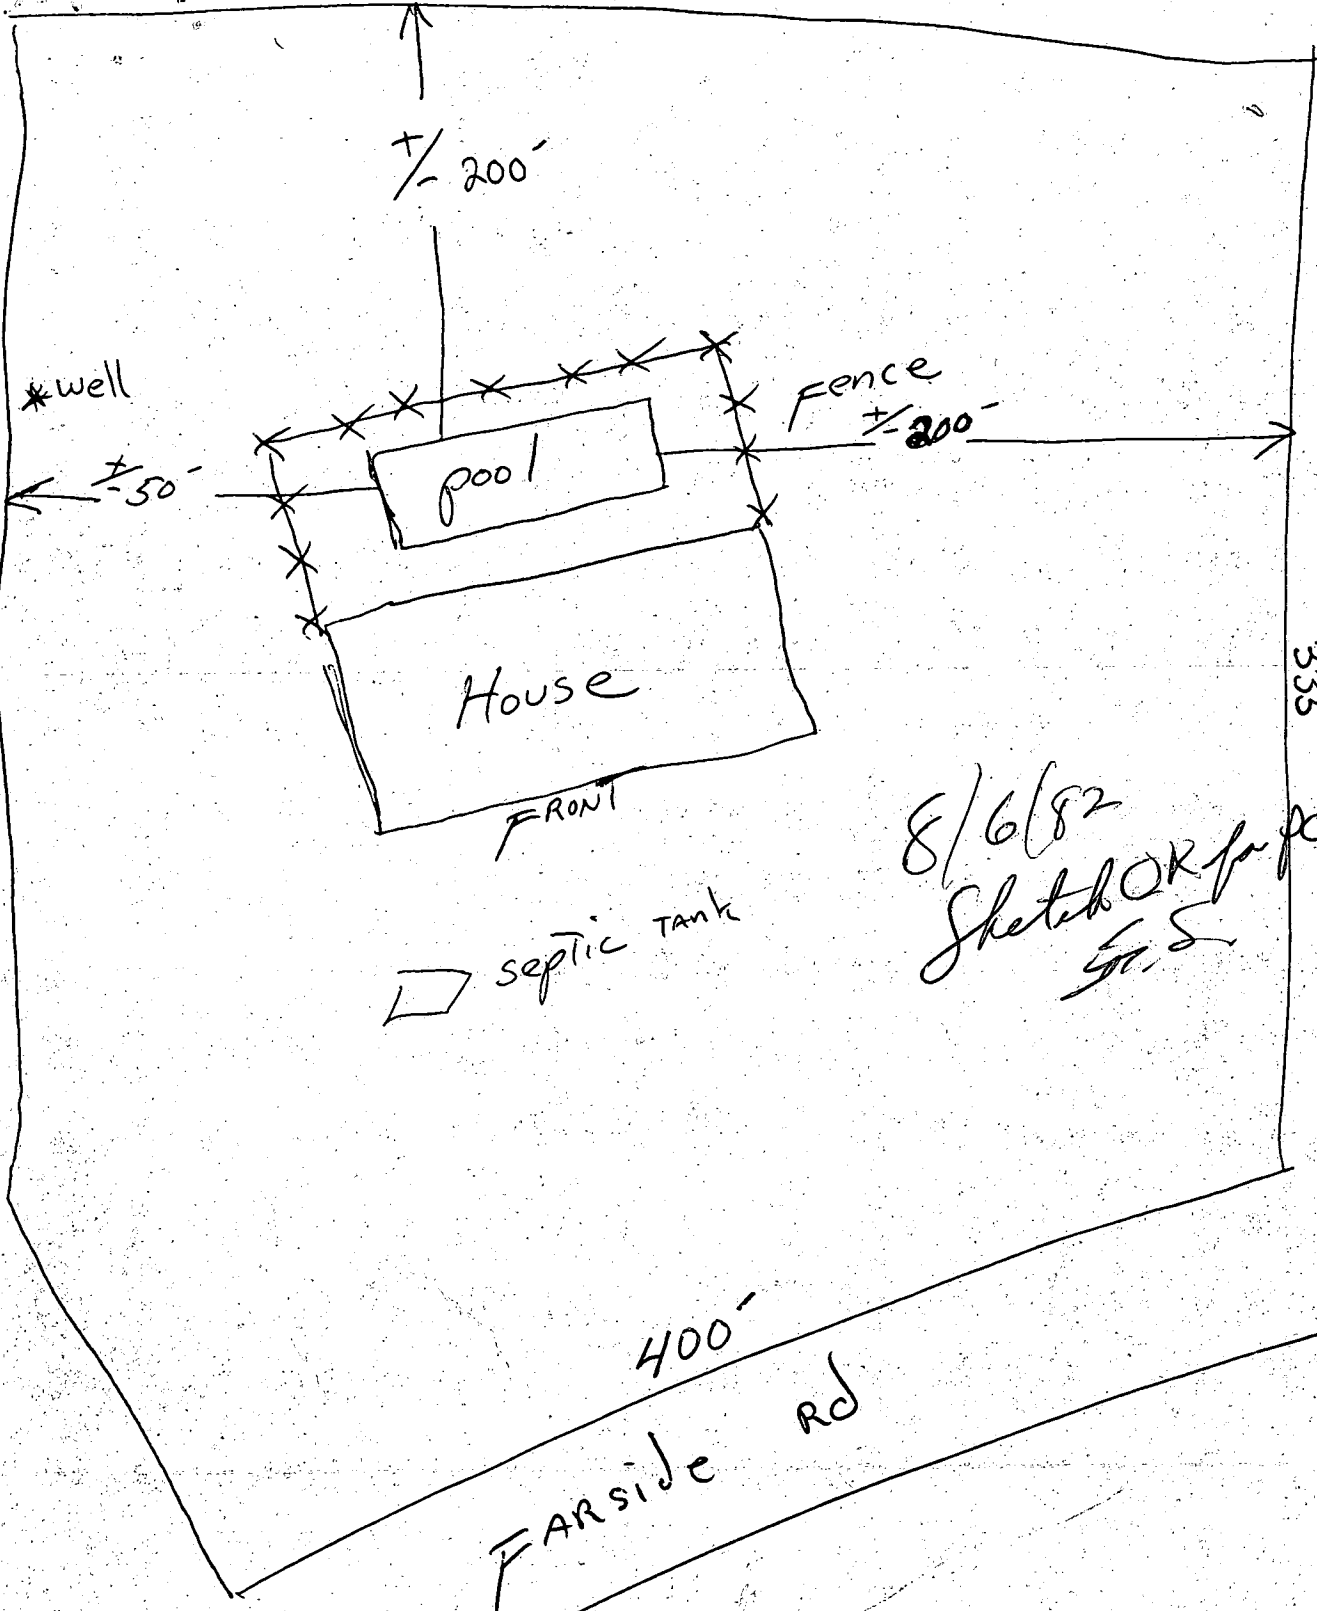

SMITH RESIDENCE
 LOT 39 FARSIDE
 SCALE: 1" = 30'

SEPTIC SYSTEM DATA:

PREPARED BY HUDKINS ASSOC.

INV. @ HOUSE : 397.15

SEPTIC TANK : (1000 GAL.) (3 BAYS)

EX. GR. 399.00
 FIN. GR. 398.00
 INV. IN. 396.65
 INV. OUT. 396.40

DRYWELL : (450 SQ. FT. SIDEWALL AREA BELOW INLET)


EX. GR. 400.00
 FIN. GR. 400.00
 INV. IN. 396.00
 INV. OUT. 396.00

TRENCH : (2' WIDE, 20' LONG)

EX. GR. 400.00
 FIN. GR. 400.00
 TOP OF STONE 396.40
 INV. IN. 395.90
 BOTTOM OF STONE 390.40

DRYWELL :
 INLET 4' BELOW ORIG. GRADE, MAX DEPTH 10'
 75' FROM LEFT R. CORNER OF LOT, 142'
 BACK FROM R. @ FARSIDE ROAD

5' EARTH BUFFER BETWEEN DRYWELL &
 TRENCH.
 2 INSPECTIONS RECD OF TRENCH BEFORE
 & AFTER STONE IN
 RUN TRENCH ON CONTOUR

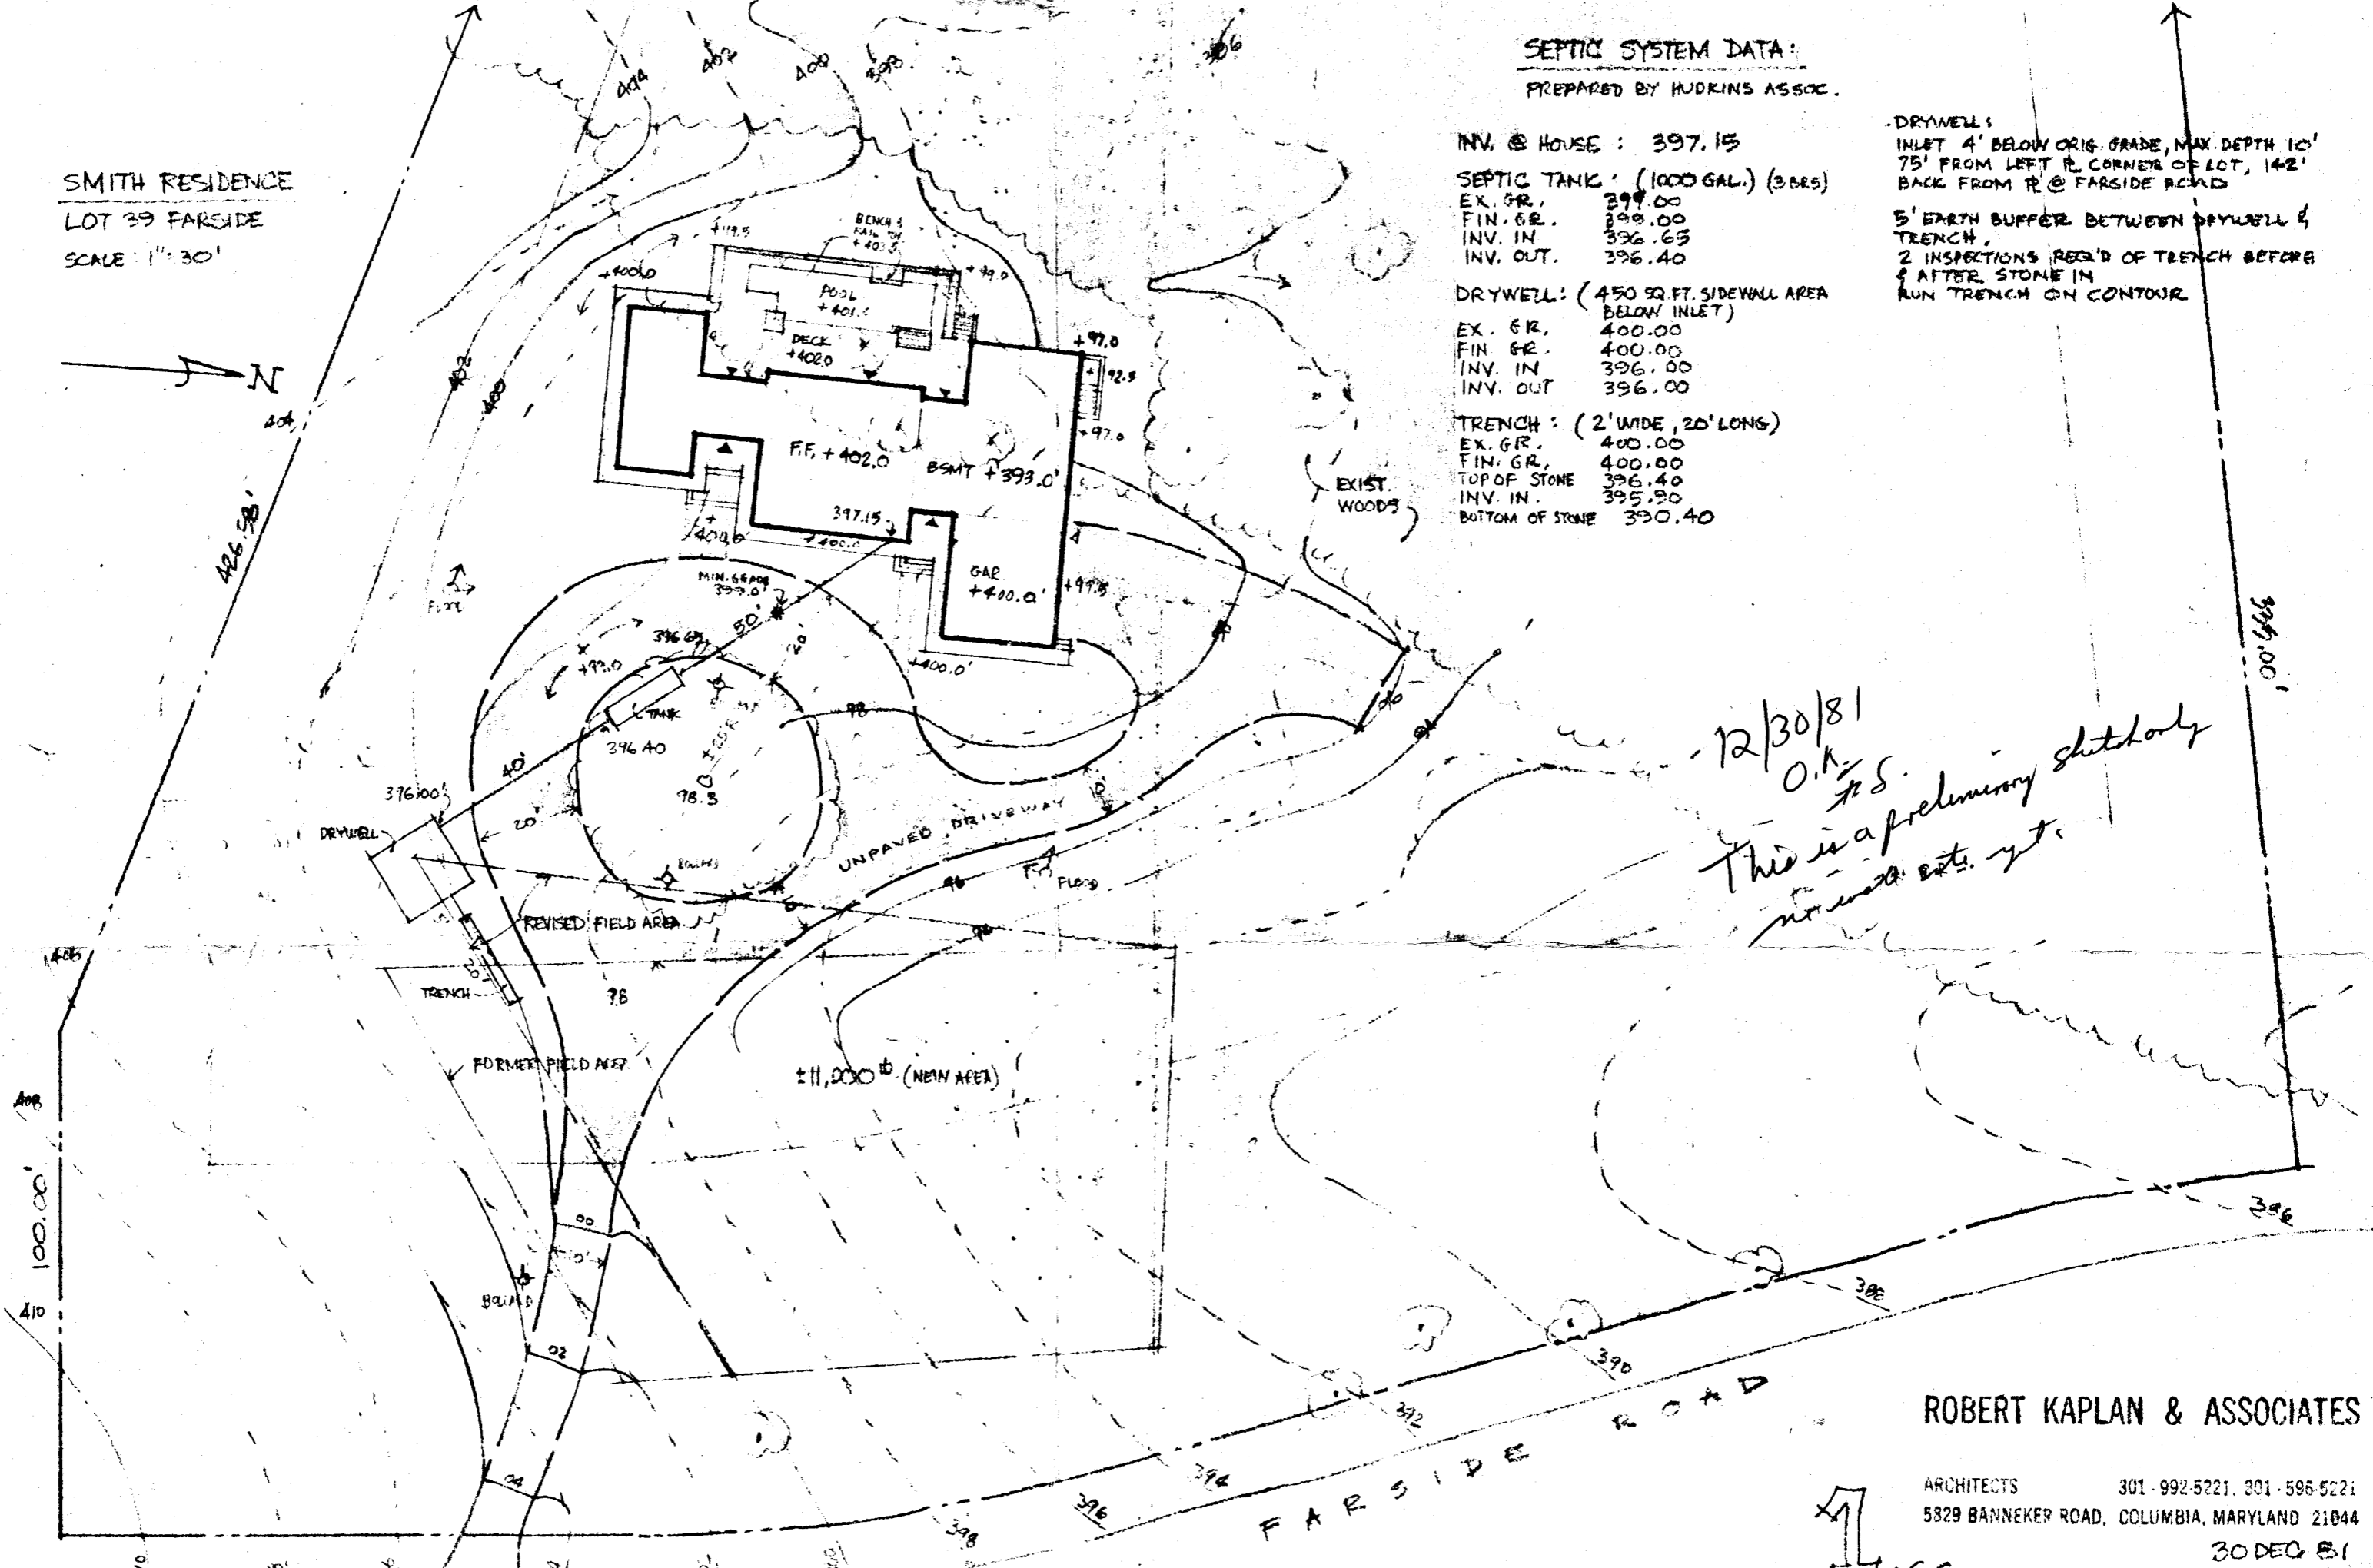


12/30/81
 O.K.
 #5.
 This is a preliminary sketch only
 no final est. yet.

ROBERT KAPLAN & ASSOCIATES

ARCHITECTS 301-992-5221, 301-596-5221
 5329 BANNEKER ROAD, COLUMBIA, MARYLAND 21044

30 DEC 81

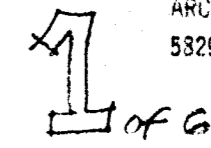



LOTS 37-41, 52, 55
 PLAT # 4412 SHEET 8 of 10
 3RD ELECTION DISTRICT
 HOWARD COUNTY, MD.

FAR SIDE ROAD
 55' R.W.
 R=275.00 L=75.42
 S 03° 05' 41" E 120.59
 518° 51' 37" E 194.72
 75' B.R.L.
 148.52
 103'

7/3/02 -
 OK
 SRU

PROPOSED ADDITIONS	
DINING ROOM	- 320.4
PORCH	- 75.4
GARDEN ROOM / STUDY	- 187.4
TOTAL	582.4

LOT 39
 3.718 AC. ±

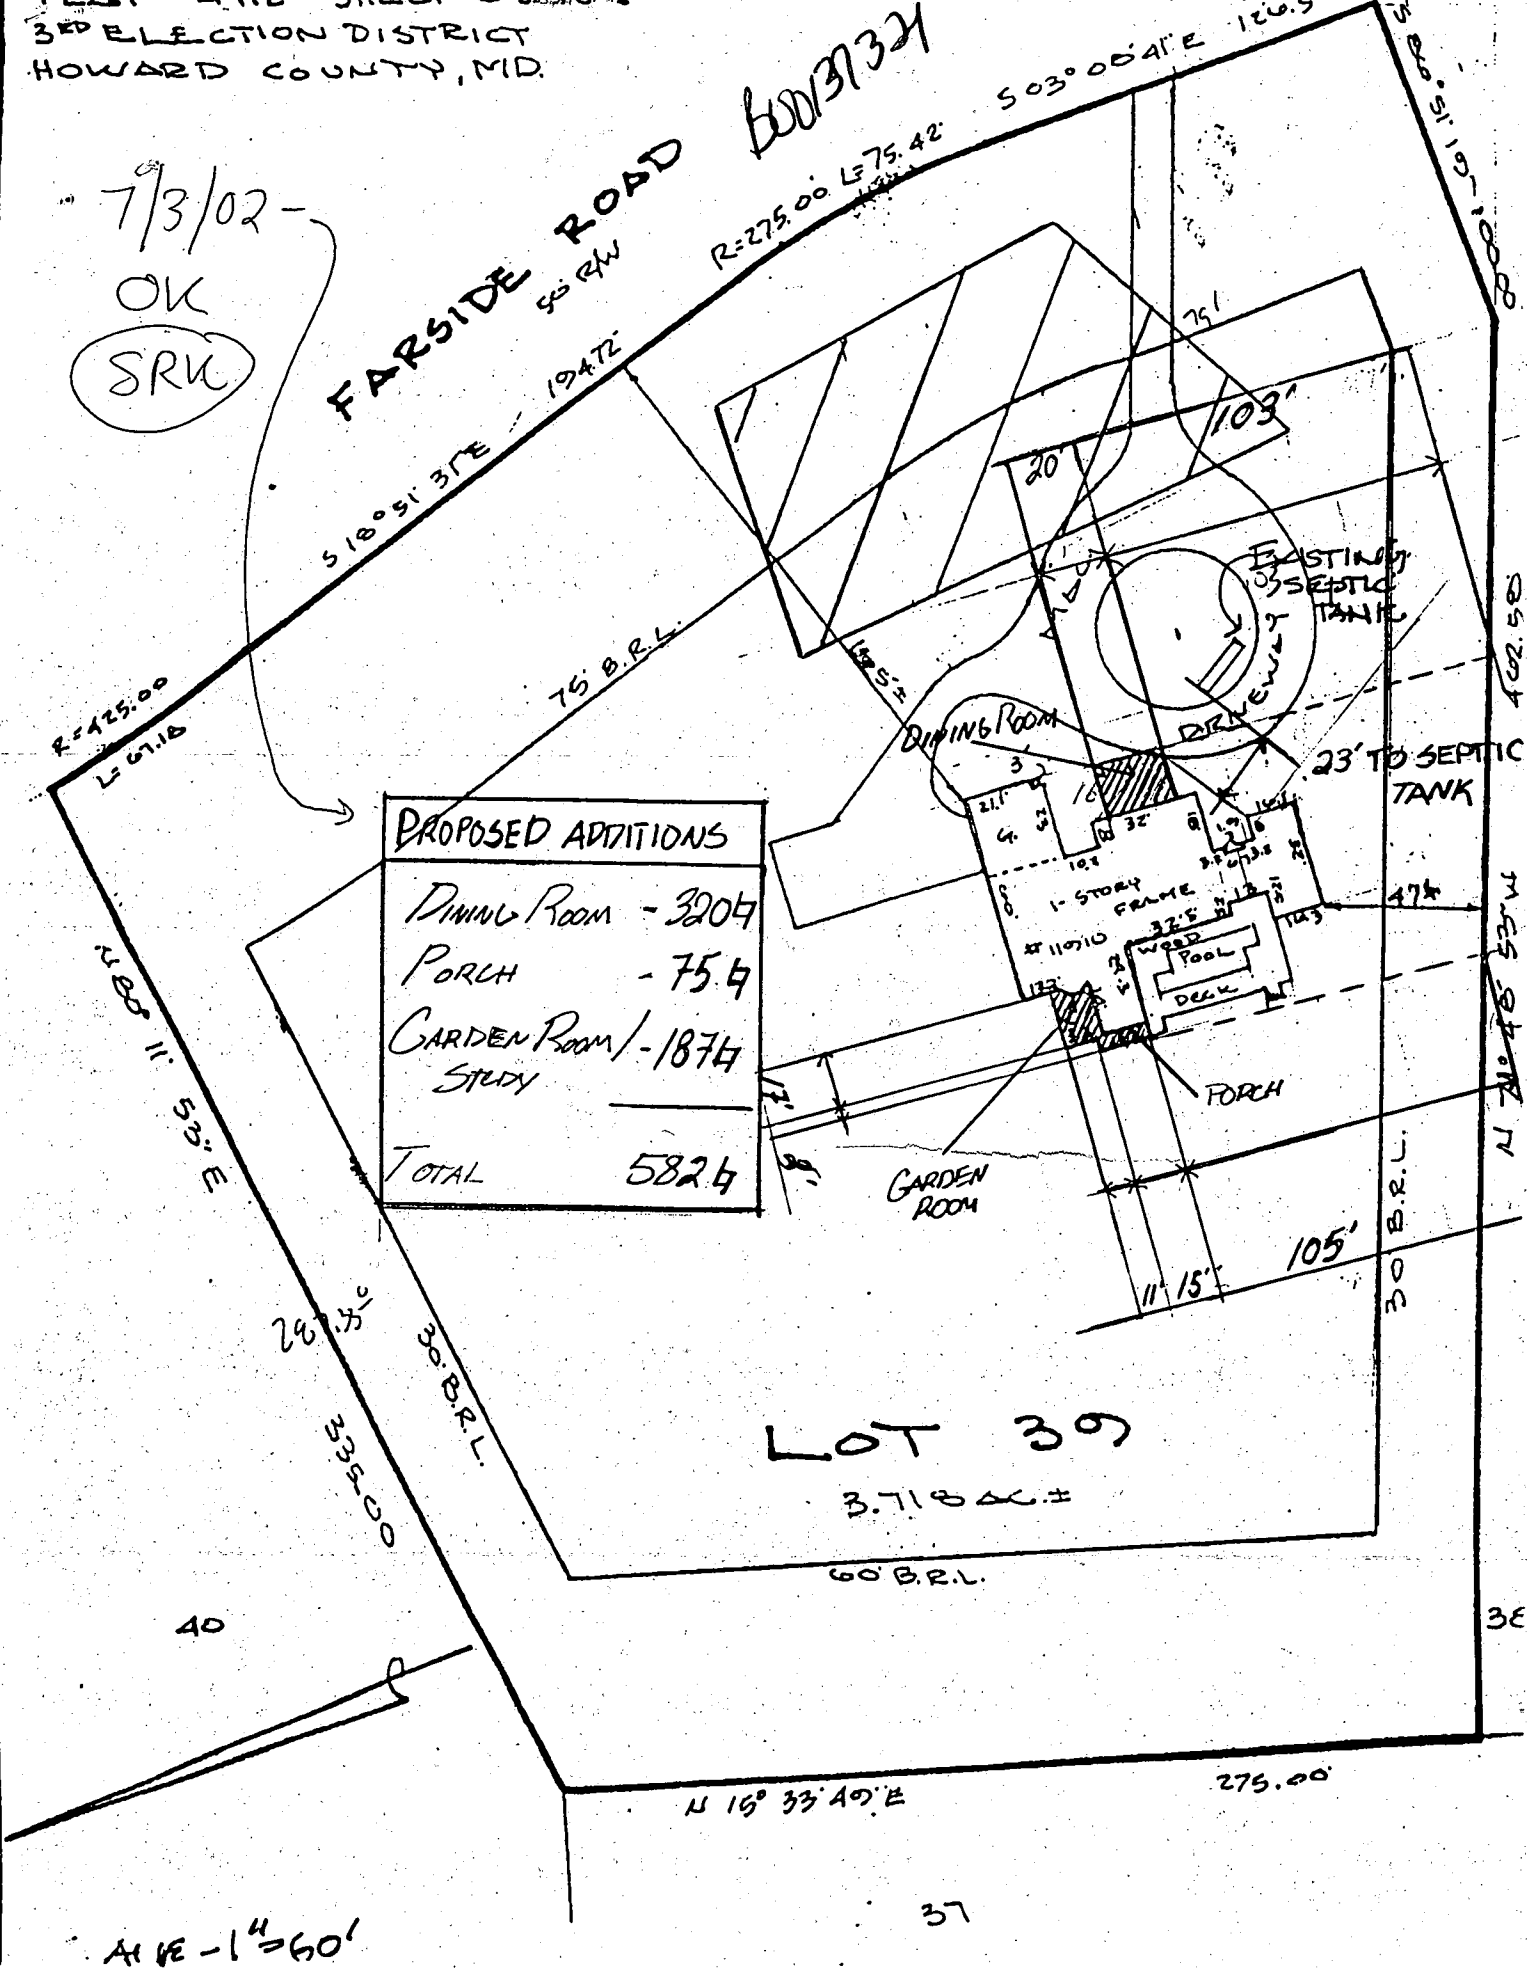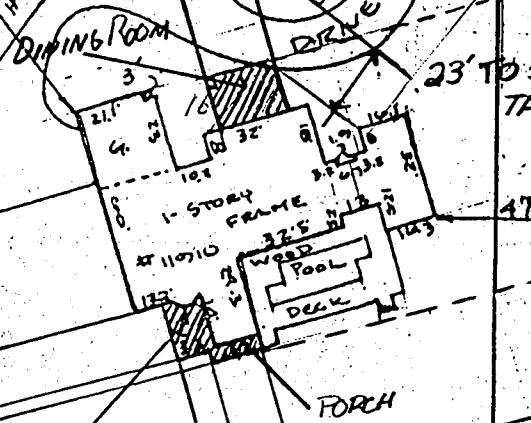

At VE - 1" = 60'