

APPLICATION

A 28417

P _____

SEWAGE DISPOSAL TESTING

STATE OF MARYLAND - DEPARTMENT OF HEALTH AND MENTAL HYGIENE
 HOWARD COUNTY HEALTH DEPARTMENT
 ENVIRONMENTAL HEALTH SERVICES
 P O. BOX 476, ELLICOTT CITY, MARYLAND 21043
 TELEPHONE: 465-5000, EXT. 356

Septic Tank { 1-3 Bedrooms 1000 gallons
 4 Bedrooms 1250 gallons

DISTRICT 3
 DATE May 12, 1978

TO: THE COUNTY HEALTH OFFICER
ELLICOTT CITY, MARYLAND

I HEREBY APPLY FOR THE NECESSARY TEST IN ORDER TO CONSTRUCT (OR RECONSTRUCT) A SEWAGE DISPOSAL SYSTEM.

PROPERTY OWNER Woodmark, Inc.

ADDRESS 9267 Balto. Nat'l. Pike PHONE 461-2889

PROPERTY LOCATION:

SUBDIVISION Farside LOT NO. 10 39

ROAD AND DESCRIPTION Rt. 110 West to left on Rt. 111, left on Folly Quarter, left on Homewood, 1 mile to property on left

SIZE OF LOT 3 plus acres TYPE BLDG. 11
NUMBER OF BEDROOMS

IF NOT SINGLE RESIDENCE DESCRIBE _____

THE SYSTEM INSTALLED UNDER THIS APPLICATION IS ACCEPTABLE ONLY UNTIL PUBLIC FACILITIES BECOME AVAILABLE.

SIGNATURE OF APPLICANT *[Signature]*

APPROVED BY _____ FOR _____ DATE 11
(KIND OF SYSTEM)


REJECTED BY _____ FOR _____ DATE _____
(KIND OF SYSTEM)

HOLD PENDING FURTHER TESTS _____ DATE _____

REASONS FOR REJECTION OR HOLDING for new lot lines

THIS IS NOT A PERMIT

39

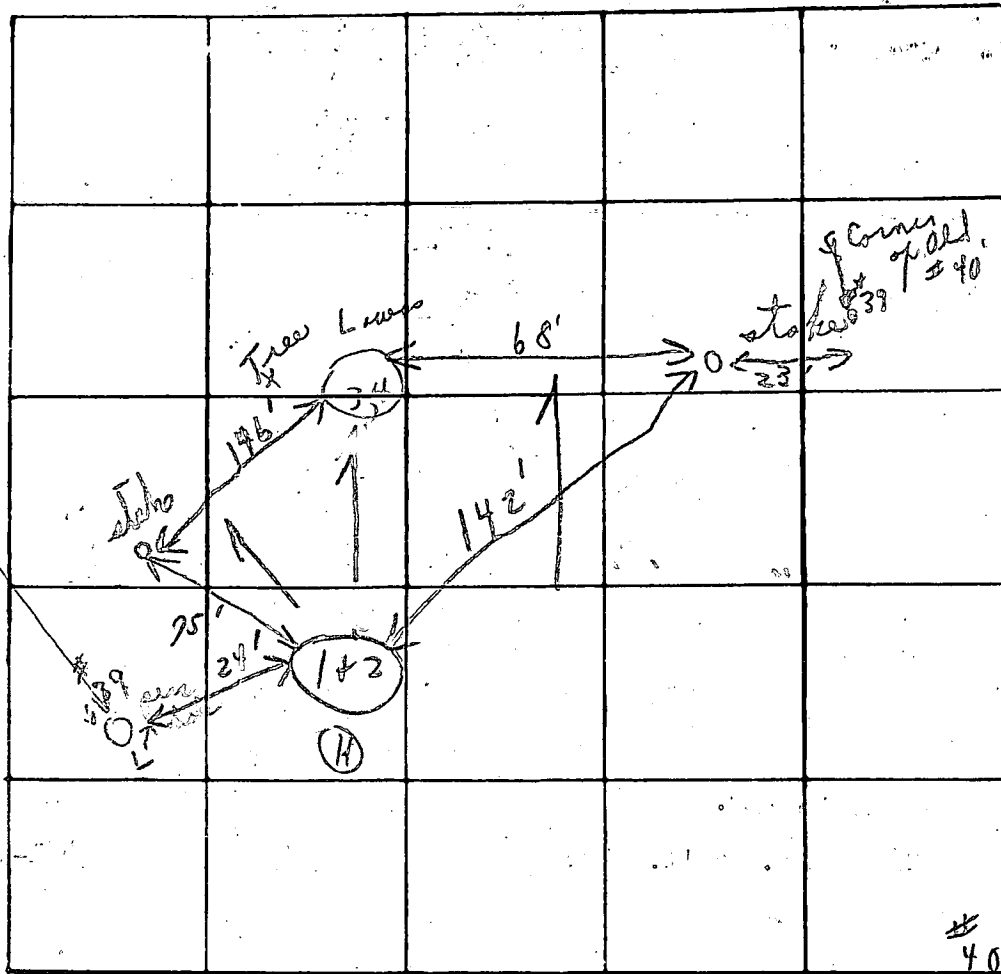

INDICATE NORTH - NAME ADJOINING ROADWAY AS BASE LINE

39

H
40
Tests on #39 per JAD To security

Soil Profile

Below clay loam

DATE	TEST NO.	DEPTH	PRE-WET		TEST 1" DROP		TIME
			START	STOP	START	STOP	
7/14/78	1	4'	11:40	11:41	11:41	11:43	2 in
	2	12'	11:40	11:42	11:42	11:46	4 in
	3A	3'	11:47	11:	Pulled pipe & lower shelf		
	4	11'	11:47	11:49	11:49	11:53	4
	5		2 Holes ok		P.F.W		
	3B	4'	11:50	12:00	12:00	12:10	10 in
						4	20

Summary
Depth 4'
150 sq ft.
per bedroom

7/14/78 { Tests in Open field # near #39 per 20/7. }
 REMARKS { #39 per JAD }
 TYPE OF SOIL { C. Bd }
 TESTED BY { C. Bd & J. D. }
 ALSO PRESENT: { No tests }
 { 7/14/78 }
 { C. Bd }