

02-227-827

# PERMIT

SEWAGE DISPOSAL SYSTEM

P 23939

A \_\_\_\_\_

MARYLAND STATE DEPARTMENT OF HEALTH

HOWARD COUNTY

## INDEXED

ELLICOTT CITY

DISTRICT 2

DATE 9/17/76

*9/17/76*  
*between 11:30 & 2 PM.*  
*Pete WB*

Jenkins Brothers IS PERMITTED TO INSTALL \_\_\_\_\_ ALTER

ADDRESS Wallas Park, Ellicott City, Md. PHONE 465-6646

A SEWAGE DISPOSAL SYSTEM LOCATED AT \_\_\_\_\_

SUBDIVISION \_\_\_\_\_ ROAD 9573 Old Frederick Rd. LOT \_\_\_\_\_

PROPERTY OWNER Marqurski 2nd house on left after Mt. Hebron School going toward

ADDRESS 9573 Old Frederick Rd.

SPECIFICATIONS - 4 bedrooms REPLACE SEPTIC TANK ONLY

DRAIN FIELD \_\_\_\_\_ DEPTH \_\_\_\_\_ FEET, BOTTOM AREA \_\_\_\_\_ SQ. FT.

SEEPAGE PITS \_\_\_\_\_ ABSORBENT SIDE-WALL AREA \_\_\_\_\_ SQ. FT.

SEPTIC TANK CAPACITY 1,250 GALLONS

FOR GARBAGE GRINDER, INCREASE DISPOSAL AREA 22% & TANK CAPACITY 50%.


OTHER \_\_\_\_\_

PLANS APPROVED BY Palmer F. Wine DATE 9/17/76

FILL SEPTIC TANK AND DISTRIBUTION BOX WITH WATER BEFORE CALLING FOR AN INSPECTION. COVER NO WORK UNTIL INSPECTED AND APPROVED.

NEITHER THE HOWARD COUNTY COMMISSIONERS NOR THE HEALTH DEPARTMENT IS RESPONSIBLE FOR THE SUCCESSFUL OPERATION OF ANY SYSTEM.

A 23939

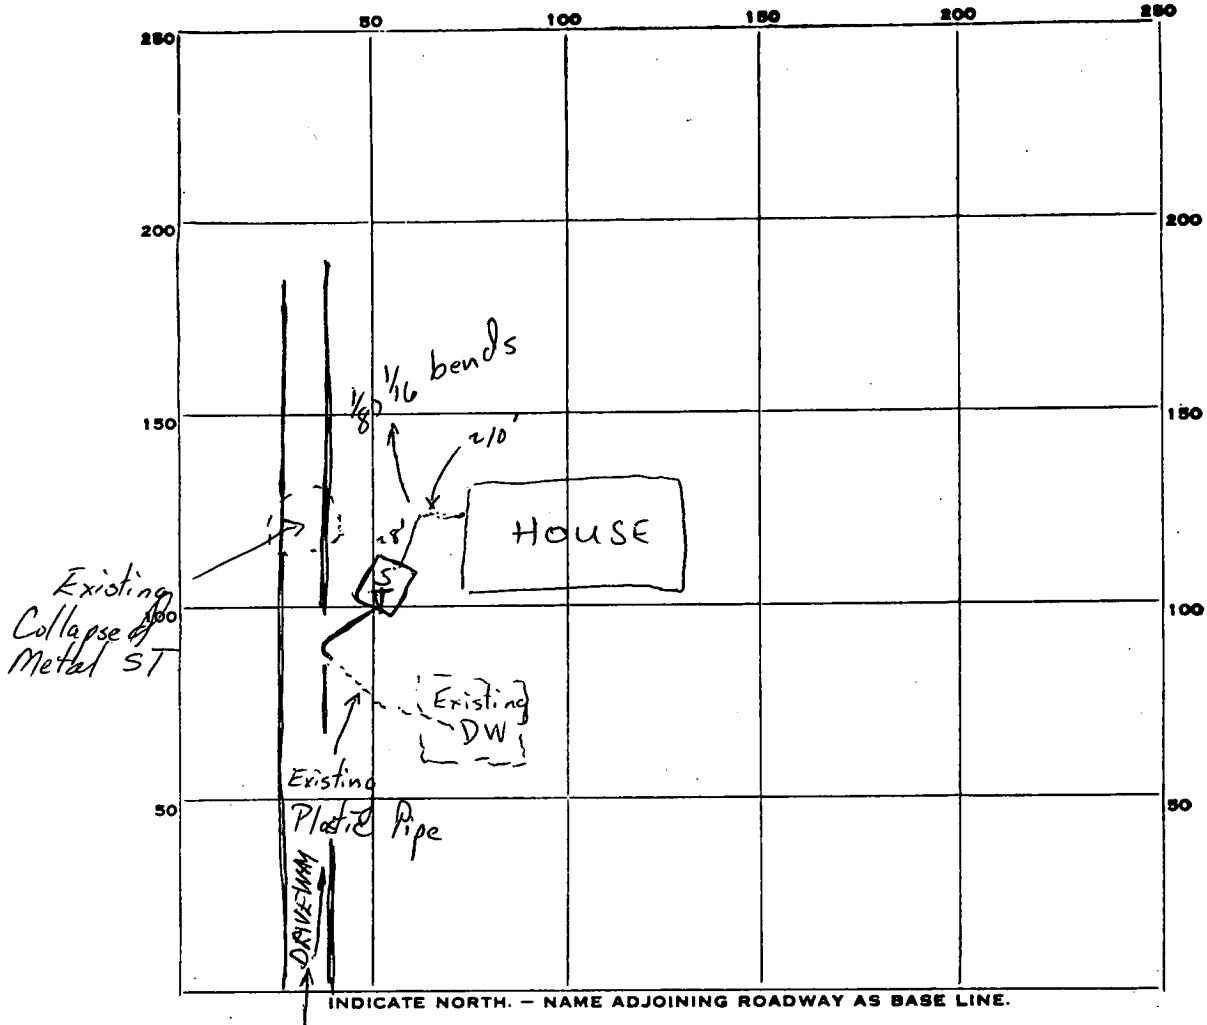

INDICATE NORTH. - NAME ADJOINING ROADWAY AS BASE LINE.

PERMIT CARD  \_\_\_\_\_ ST

SEPTIC TANK, LEVEL 1250'  \_\_\_\_\_ CLEANOUTS  cast iron to grade

DISTRIBUTION BOX, LEVEL \_\_\_\_\_

TILE FIELD, DEPTH \_\_\_\_\_ FT. TRENCH WIDTH \_\_\_\_\_ FT.

GRAVEL DEPTH \_\_\_\_\_ IN. TOTAL LENGTH \_\_\_\_\_ FT.

NUMBER OF TRENCHES \_\_\_\_\_ TOTAL BOTTOM AREA \_\_\_\_\_

SEEPAGE PITS, INSIDE DIAMETER \_\_\_\_\_ FT. DEPTH BELOW INLET \_\_\_\_\_ FT.

ABSORBENT AREA \_\_\_\_\_ SQ. FT.

REMARKS 9/17/76 1:45 PM - Not ready

9/17/76 1250 gal ST installed. OK

DATE SYSTEM APPROVED 9/17/76 INSPECTOR Arthur H. Zupp