

PERMIT

SEWAGE DISPOSAL SYSTEM

P 23176
A _____

MARYLAND STATE DEPARTMENT OF HEALTH

HOWARD COUNTY

ELLICOTT CITY

INDEXED

DISTRICT 5

DATE 4/30/76

~~5/20/76~~ 5/20/76
between 11:00
& 12 noon
knowing on how
Mrs. Spangler will
be there
Contract
over
line

Chris Spangler _____ IS PERMITTED TO INSTALL _____ ALTER X

ADDRESS 8928-F Town & Country Blvd., Ellicott City, Md. PHONE 465-9217

A SEWAGE DISPOSAL SYSTEM LOCATED AT _____

SUBDIVISION Heritage Heights ROAD 6117 Thompson Drive LOT 3 BLK D

PROPERTY OWNER Mr. Paul R. Spangler DEONIS CROSS

ADDRESS _____

SPECIFICATIONS

DRAIN FIELD _____ DEPTH _____ FEET, BOTTOM AREA _____ SQ. FT.

SEEPAGE PITS _____ ABSORBENT SIDE-WALL AREA _____ SQ. FT.

SEPTIC TANK CAPACITY _____ GALLONS

FOR GARBAGE GRINDER, INCREASE DISPOSAL AREA 22% & TANK CAPACITY 50%.

OTHER REPAIR - Call for inspection when ground is opened up so Sanitarian can

recommend repair system. - trench - 2' wide - 11' deep - 7ft. of trench

sign - trench to be at least 60' long.


* permission given to install small basement tank for outdoor utility shed
show start of trench & 2' wide trench

PLANS APPROVED BY Palmer F. Wine DATE 4/30/76

FILL SEPTIC TANK AND DISTRIBUTION BOX WITH WATER BEFORE CALLING FOR AN INSPECTION. COVER NO WORK UNTIL INSPECTED AND APPROVED.

NEITHER THE HOWARD COUNTY COMMISSIONERS NOR THE HEALTH DEPARTMENT IS RESPONSIBLE FOR THE SUCCESSFUL OPERATION OF ANY SYSTEM.

P
23176

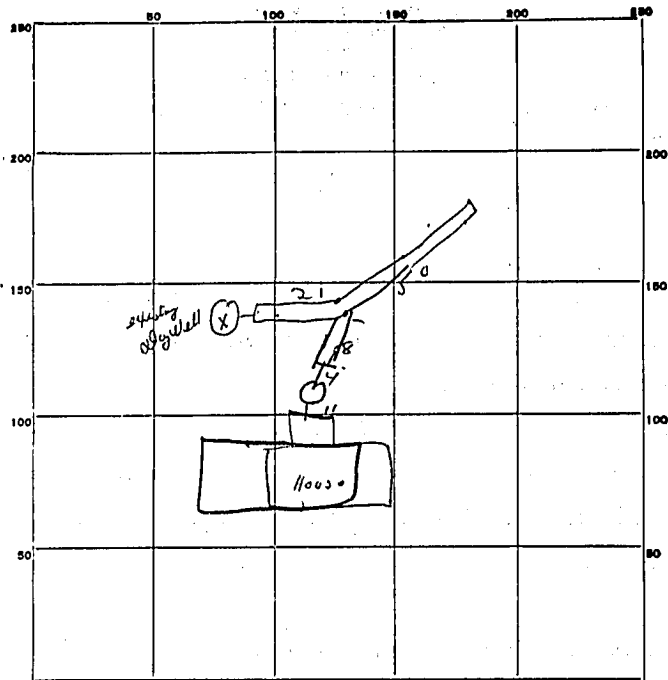

INDICATE NORTH. -- NAME ADJOINING ROADWAY AS BASE LINE.

PERMIT CARD 012

SEPTIC TANK, LEVEL _____ CLEANOUTS _____

DISTRIBUTION BOX, LEVEL _____

TILE FIELD, DEPTH _____ FT. TRENCH WIDTH _____ FT.

GRAVEL DEPTH _____ IN. TOTAL LENGTH _____ FT.

NUMBER OF TRENCHES _____ TOTAL BOTTOM AREA _____

SEEPAGE PITS, INSIDE DIAMETER _____ FT. DEPTH BELOW INLET _____ FT.

ABSORBENT AREA _____ SQ. FT.

REMARKS 5/16/76 - OK to gravel ~~field~~ ~~inlet~~

5/20/76 gravel 3'-4' from top OK Rm

DATE SYSTEM APPROVED 5/20/76 INSPECTOR Rm

**CROSS
LITTLE +**

ARCHITECTS

1422 Fenwick Lane
Silver Spring
Maryland 20910
301 588 8100

Returned original 7/2/85
F.S.

June 28, 1985

Mr. Frank Skinner
Howard County Health Department
P.O. Box 476
Ellicott City, MD 21043

RE: 6117 Thompson Drive
Clarksville, MD
Heritage Heights

Dear Mr. Skinner:

Thank you for your time yesterday checking on the status of the septic system for the above referenced property. As per our phone conversation; you indicated that there would be no problem with adding a bedroom and full bathroom, making a four bedroom house, in the existing basement with respect to the capacity of the existing septic system. Your signature of concurrence on a returned copy of this letter would be greatly appreciated. Thank you once again for your time.

Sincerely,



Dennis F. Cross, AIA
Cross & Little, Inc.


Mr. Frank Skinner

7/2/85
Date