

8/5/76
9-3

9/2/76 *appd. F. S.*
Ready

PERMIT

P 23658

SEWAGE DISPOSAL SYSTEM

A _____

MARYLAND STATE DEPARTMENT OF HEALTH

HOWARD COUNTY

ELLICOTT CITY

DISTRICT 4

INDEXED

DATE 8/4/76

04-313275

8/27/76
W. M.
[Signature]

Herman Sirk _____ IS PERMITTED TO INSTALL _____ ALTER

ADDRESS Jennings Chapel Road, Woodbine, Maryland _____ PHONE 489-4724

A SEWAGE DISPOSAL SYSTEM LOCATED AT _____

SUBDIVISION _____ ROAD 1238 Morgan Station _____ LOT _____

3 rd house on left off Rt. 144

PROPERTY OWNER Ray E. Digman _____

ADDRESS 1238 Morgan Station Road, Woodbine, Md. 21797 _____

SPECIFICATIONS

DRAIN FIELD _____ DEPTH _____ FEET, BOTTOM AREA _____ SQ. FT.

SEEPAGE PITS _____ ABSORBENT SIDE-WALL AREA _____ SQ. FT.

SEPTIC TANK CAPACITY _____ GALLONS

FOR GARBAGE GRINDER, INCREASE DISPOSAL AREA 22% & TANK CAPACITY 50%.

OTHER REPAIR - CALL FOR INSPECTION WHEN GROUND IS OPENED UP SO SANITARIAN CAN _____

RECOMMEND REPAIR SYSTEM. *System to be installed in back of house*

parallel to right lot line, 20-25' off right line, at least 75' away fr. existing wells. Length and depth to be determined when trench begun. Approx 600 sq area. Will have to be pumped. wht2.


PLANS APPROVED BY Palmer F. Wine _____ DATE 8/4/76

FILL SEPTIC TANK AND DISTRIBUTION BOX WITH WATER BEFORE CALLING FOR AN INSPECTION. COVER NO WORK UNTIL INSPECTED AND APPROVED.

NEITHER THE HOWARD COUNTY COMMISSIONERS NOR THE HEALTH DEPARTMENT IS RESPONSIBLE FOR THE SUCCESSFUL OPERATION OF ANY SYSTEM.

23658

A23058

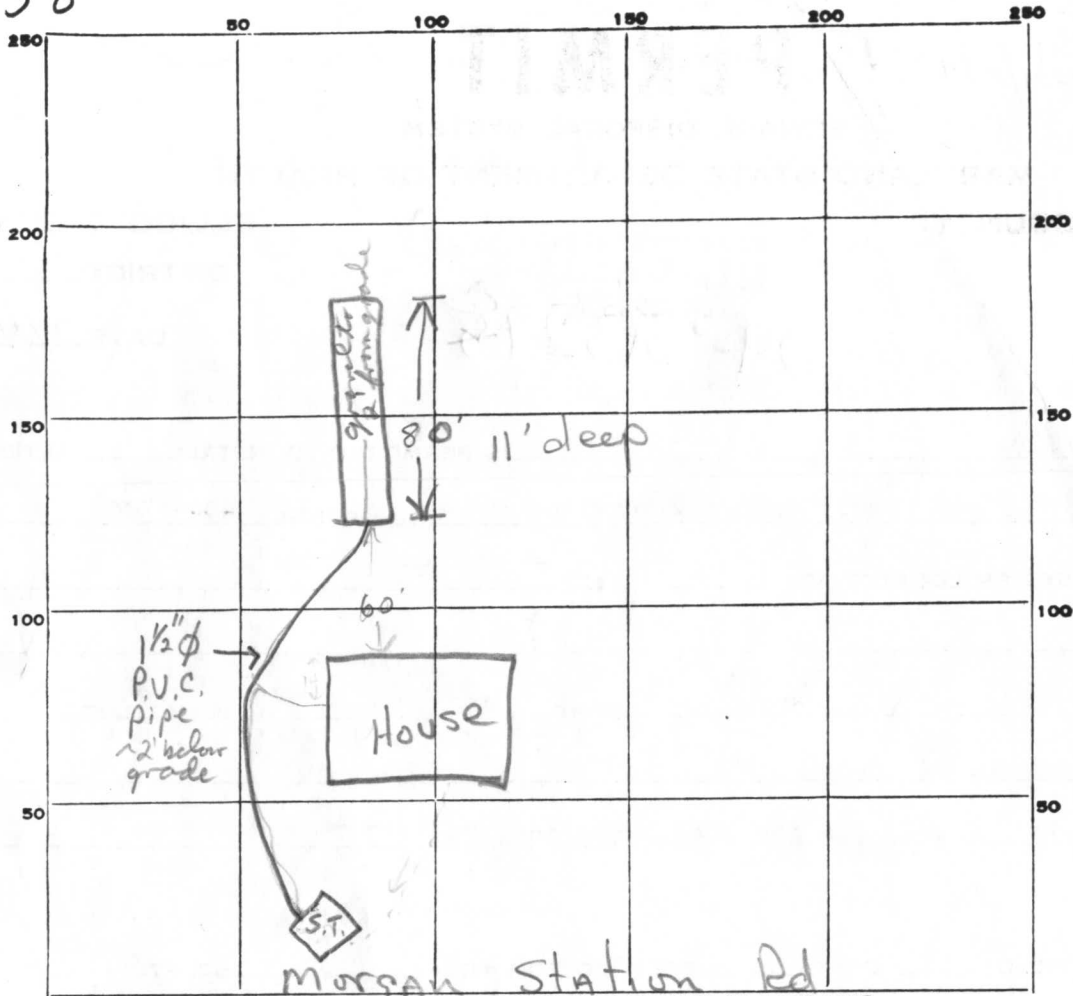

INDICATE NORTH. NAME ADJOINING ROADWAY AS BASE LINE.

PERMIT CARD Final O.K. F.S.

SEPTIC TANK, LEVEL ✓

CLEANOUTS n.a.

DISTRIBUTION BOX, LEVEL _____

TILE FIELD, DEPTH Aug 11 FT. TRENCH WIDTH 2 FT.

GRAVEL DEPTH ~9 FT. TOTAL LENGTH 80 FT.

NUMBER OF TRENCHES 1 TOTAL BOTTOM AREA ±700

SEEPAGE PITS, INSIDE DIAMETER _____ FT. DEPTH BELOW INLET _____ FT.

ABSORBENT AREA ±700 SQ. FT.

REMARKS 8/27/76 At 10:30 AM - HB - trench not completely excavated at this time - Mr Sirk will contact H.D. when ready; 9/2/76 Pump installed in septic tank & in operation O.K. to curvall work F.S.

DATE SYSTEM APPROVED 9/2/76

INSPECTOR F. Skinner

3/20/73

449 3-20-73
OK 7/3

PERMIT

SEWAGE DISPOSAL SYSTEM

MARYLAND STATE DEPARTMENT OF HEALTH

HOWARD COUNTY

INDEXED

P 10612 (26618)

A _____

ELLICOTT CITY

DISTRICT 4

DATE 12/14/72

Jack Fyock IS PERMITTED TO INSTALL ALTER

ADDRESS Ten Oaks Road, Glenalg, Maryland PHONE 286-7929

A SEWAGE DISPOSAL SYSTEM LOCATED AT _____

SUBDIVISION _____ ROAD 1238 Morgan Road LOT _____

(between Rt. 144 & Rt. 40)

PROPERTY OWNER Lee I. Day

ADDRESS 1238 Morgan Road, Woodbine, Maryland 21797

SPECIFICATIONS - 3 bedrooms

DRAIN FIELD _____ DEPTH _____ FEET. BOTTOM AREA _____ SQ. FT.

SEEPAGE PITS _____ ABSORBENT SIDE-WALL AREA _____ SQ. FT.

REPAIR SEPTIC TANK CAPACITY 1,000 GALLONS

FOR GARBAGE GRINDER, INCREASE DISPOSAL AREA 22% & TANK CAPACITY 50%.

OTHER REPAIR - Trench 40 ft. long - 2 ft. wide - 11 ft. deep - 6 ft. c' around

in trench. Call for inspection of trench before gravel is installed.

Abandoned septic tank and dry well are to be filled in.


NOTE: INSTALL STAND PIPE ON SEPTIC TANK.

PLANS APPROVED BY Donald W. Monaghan DATE 3-20-73

FILL SEPTIC TANK AND DISTRIBUTION BOX WITH WATER BEFORE CALLING FOR AN INSPECTION. COVER NO WORK UNTIL INSPECTED AND APPROVED.

NEITHER THE HOWARD COUNTY COMMISSIONERS NOR THE HEALTH DEPARTMENT IS RESPONSIBLE FOR THE SUCCESSFUL OPERATION OF ANY SYSTEM

1618

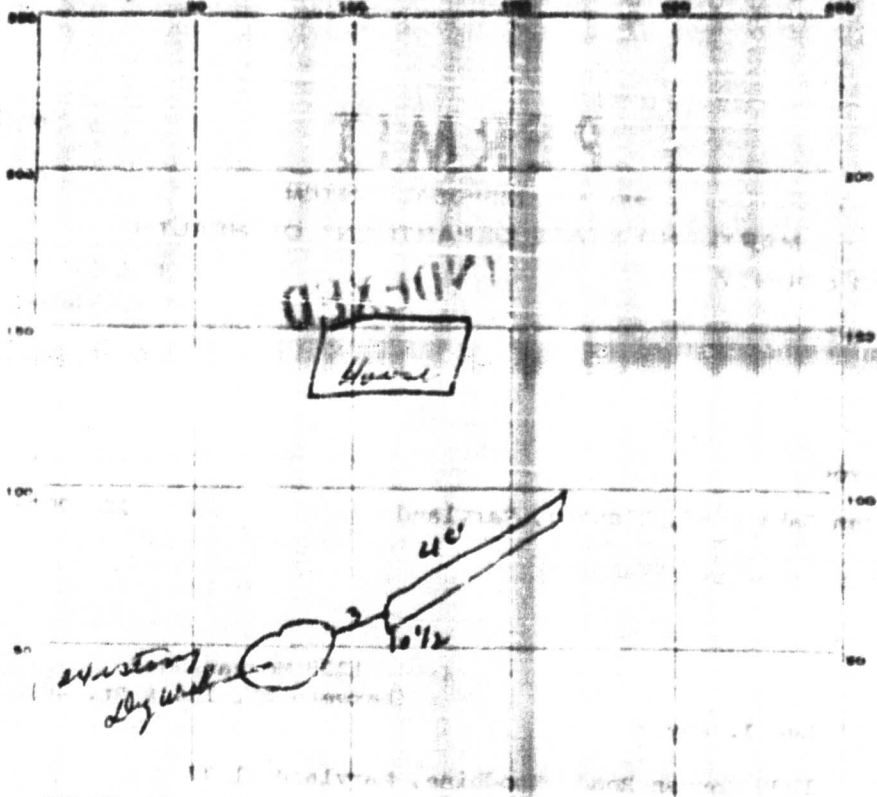

INDICATE NORTH - NAME ADJOINING ROADWAY AS BASE LINE

Morgan Station Rd

PERMIT CARD MP

SEPTIC TANK LEVEL _____ CLEANOUTS _____

DISTRIBUTION BOX LEVEL _____

TILE FIELD DEPTH 10 1/2 FT. TRENCH WIDTH 2 FT.

TRENCH TO GRAVEL DEPTH 24 " TOTAL LENGTH 114 FT.

NUMBER OF TRENCHES _____ TOTAL BOTTOM AREA 80 SQ. FT.

SPRINGS INSIDE DIAMETER _____ FT. DEPTH BELOW INLET _____ FT.

Trench ABSORBENT AREA 560 SQ. FT.

REMARKS 3/20/73 OK 1 pt gravel in trench

DATE SYSTEM APPROVED 2-20-73 INSPECTOR Dr. Morgan

11/27/71
3:31 pm

APPLICATION

A 116618
P _____

SEWAGE DISPOSAL TESTING

MARYLAND STATE DEPARTMENT OF HEALTH

HOWARD COUNTY

ELLICOTT CITY

Septic tank - 1000 gal.

DISTRICT 4

DATE 11/27/71

Trench - 48 ft long - 2 ft wide - 14 ft deep - 6 ft of gravel in trench
call for inspection of trench before gravel is installed.
Abandoned septic tank + dry well on to be filled in

TO: THE COUNTY HEALTH OFFICER
ELLICOTT CITY, MARYLAND

I, HEREBY, APPLY FOR THE NECESSARY TESTS IN ORDER TO CONSTRUCT (OR RECONSTRUCT) A SEWAGE DISPOSAL SYSTEM.

PROPERTY OWNER Lee May

ADDRESS 1238 Morgan Station Road PHONE _____
Woodhew, Md.

PROPERTY LOCATION:

SUBDIVISION _____ LOT NO. _____

ROAD AND DESCRIPTION Morgan Station Road - 2nd house from
Rt. 40 on right.

OCCUPANT _____ PHONE _____

PERSON TO CONSTRUCT SYSTEM _____

ADDRESS _____ PHONE _____

SIZE OF LOT _____ TYPE BLDG Existing house
NUMBER OF BEDROOMS _____

IF NOT SINGLE RESIDENCE DESCRIBE _____

SIGNATURE OF APPLICANT _____

APPROVED BY [Signature] FOR [Signature] DATE 12-16-71
(HEAD OF SYSTEM)

REJECTED BY _____ FOR _____ DATE _____
(HEAD OF SYSTEM)

HOLD PENDING FURTHER TESTS _____ DATE _____

REASONS FOR REJECTION OR HOLDING _____


THIS IS NOT A PERMIT

APPLICATION

SEWER DEPARTMENT
 MARYLAND STATE DEPARTMENT OF HEALTH

ELICOTT CITY

HOWARD COUNTY

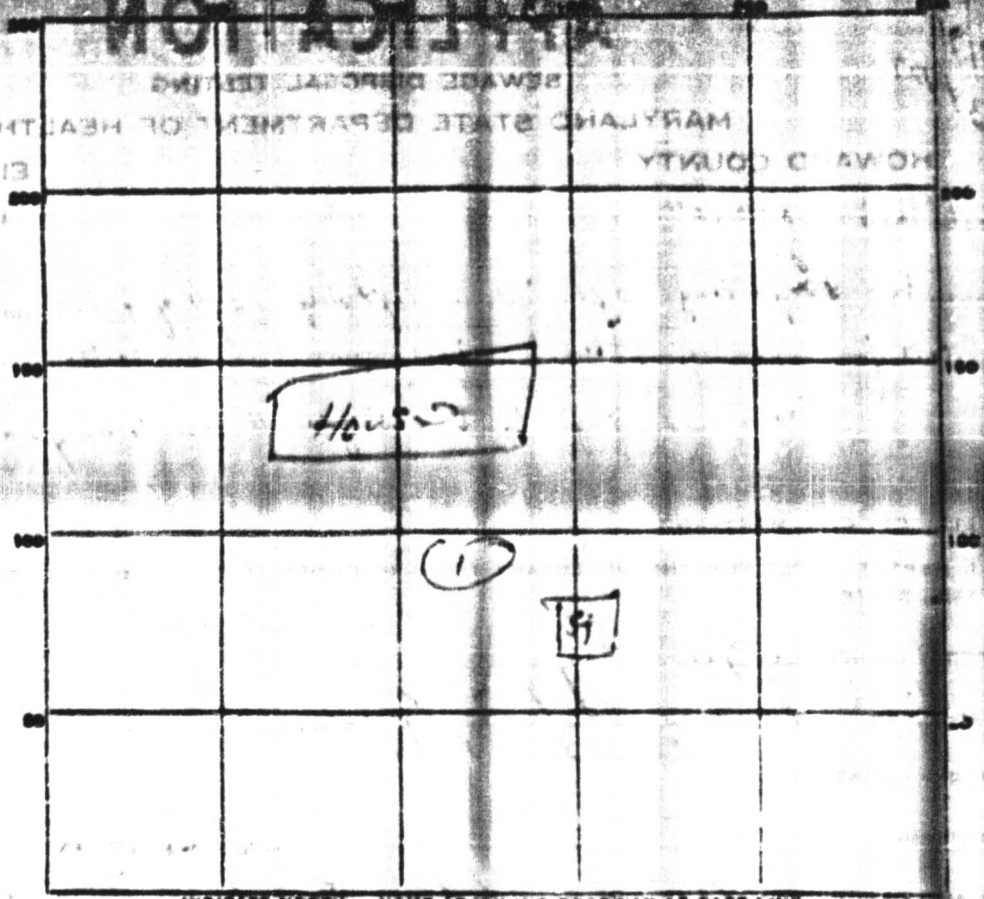

INDICATE NORTH - NAME ADJOINING ROADWAY AS BASE LINE

DATE	TEST NO.	DEPTH	PRE-WET		TEST - 1" DROP		TIME
			START	STOP	START	STOP	
4/27/77	1	11 1/2'	3:00	3:02	3:00	3:10	5 min

SOIL AUGER FINDING _____
 TESTED BY: J. G. M.
 REMARKS: _____

THIS IS NOT A PERMIT