

05-576864

7/23/76
around 3 PM

PERMIT

SEWAGE DISPOSAL SYSTEM

25726

25348

P

25166

A

MARYLAND STATE DEPARTMENT OF HEALTH

HOWARD COUNTY

ELLICOTT CITY

8th

DISTRICT

18x36 7'4" Lock

DATE 8/13/76

INDEXED

Sadler Plumbing and Heating

IS PERMITTED TO INSTALL ALTER

ADDRESS Maple Avenue, Hanover, Maryland

PHONE 796-8022

A SEWAGE DISPOSAL SYSTEM LOCATED AT

SUBDIVISION White Oak Estates

ROAD 13064 Deanmar Drive

LOT 3, Sec. 1

PROPERTY OWNER Thomas Comfort

Dr. Robert Parrott

ADDRESS

BLDG. PERMIT SIGNED

AND RETURNED

Serial # BM11954-412

SPECIFICATIONS 2 4 bedrooms

DRAIN FIELD DEPTH FEET, BOTTOM AREA SQ. FT.

SEEPAGE PITS ABSORBENT SIDE-WALL AREA SQ. FT.

SEPTIC TANK CAPACITY 1250 GALLONS

FOR GARBAGE GRINDER, INCREASE DISPOSAL AREA 25% & TANK CAPACITY 50%

OTHER DRY WELL - 400 sq. ft. sidewall area below top 5 ft. of clay. Dry well inlet to be 3 ft. deep and bottom of dry well to be 9 ft. deep. Place the dry well 112 ft. from the back lot line and 22 ft. from the right side of the lot as shown facing the lot from Deanmar Drive.

NOTE: ALL PIPE FROM HOUSE TO DISPOSAL AREA MUST BE CAST IRON.

PERMIT VOID AFTER THREE YEARS.

NOTE: INSTALL STAND PIPE ON SEPTIC TANK AND DRY WELL. STAND PIPE MUST BE 6 INCHES IN DIAMETER. CAST IRON, CONCRETE OR TERRA COTTA ACCEPTED.

PLANS APPROVED BY Raymond Hodges

DATE 5/6/76

FILL SEPTIC TANK AND DISTRIBUTION BOX WITH WATER BEFORE CALLING FOR AN INSPECTION. COVER NO WORK UNTIL INSPECTED AND APPROVED.


NEITHER THE HOWARD COUNTY COMMISSIONERS NOR THE HEALTH DEPARTMENT IS RESPONSIBLE FOR THE SUCCESSFUL OPERATION OF ANY SYSTEM.

BLDG. PERMIT SIGNED
AND RETURNED 9/28/81
for Pool #47873

BLDG. PERMIT SIGNED
AND RETURNED 1/16/82
Serial # 5757

13166

P 23726

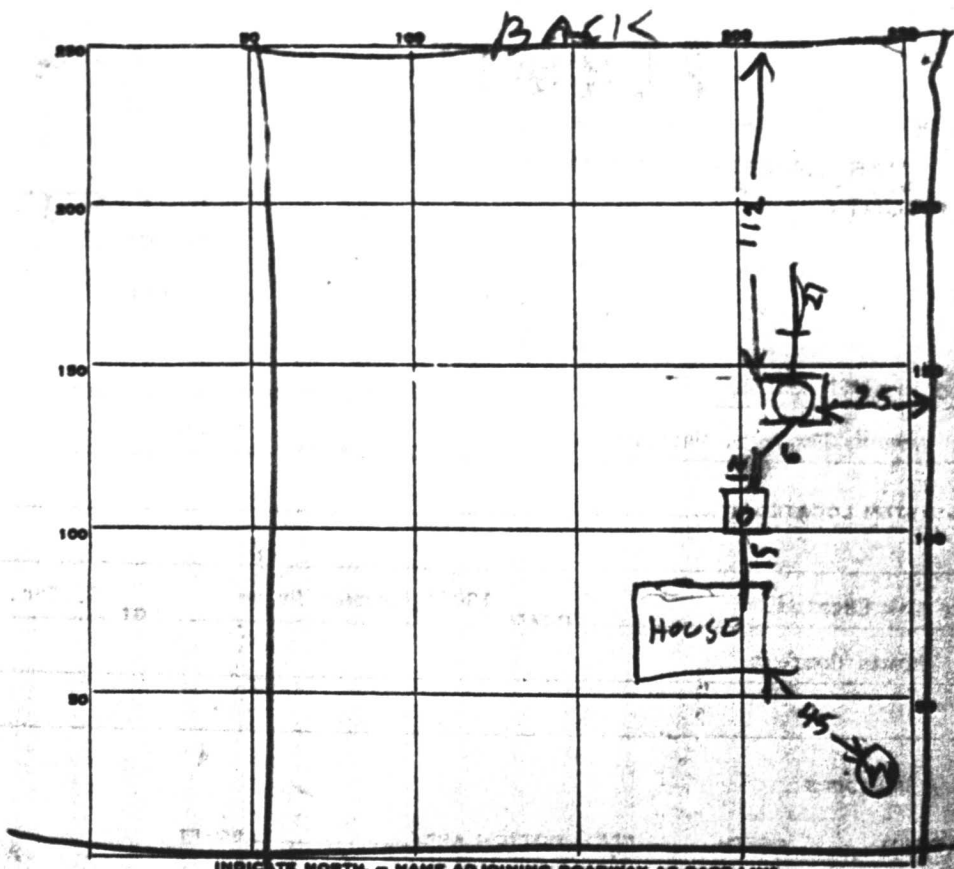

INDICATE NORTH - NAME ADJOINING ROADWAY AS BASE LINE

DEAN MAR DR

PERMIT CARD _____ 41

SEPTIC TANK, LEVEL 1250 CLEANOUTS OK

DISTRIBUTION BOX, LEVEL _____

DITCH DEPTH 9 FT. TRENCH WIDTH 2 FT.

GRAVEL DEPTH 6 IN. TOTAL LENGTH 27 FT.

NUMBER OF TRENCHES _____ TOTAL BOTTOM AREA 162

SEEPAGE PITS, INSIDE PERMITS 47 FT. DEPTH BELOW INLET 6 FT.

ABSORBENT AREA 342 SQ. FT.

REMARKS 9/22/76 - DW INLET 3 FT BELOW GRADE
342 + 162 = 506 sq ft total
for HBR

DATE SYSTEM APPROVED 9/22/76 INSPECTOR Raymond Hoelgen

B064 DEANMAR

TOPOGRAPHY
WHITE OAK EST LOT 34

DRAFTING SERVICE



Tri-State Surveys

FOR OUR RECORD

4117 THIRDFIFTH STREET
MT. RAIBER, MARYLAND
WASHINGTON 7-6395


PERMIT APPROVED
AT PERMITS DEPT
ON BASIS OF PLAN
JANUARY 4, 1977



CEDRIC B. SAMUEL
REGISTERED LAND SURVEYOR

HIGHLAND ROAD

S 64° 51' 18" E 140.49'
(130')

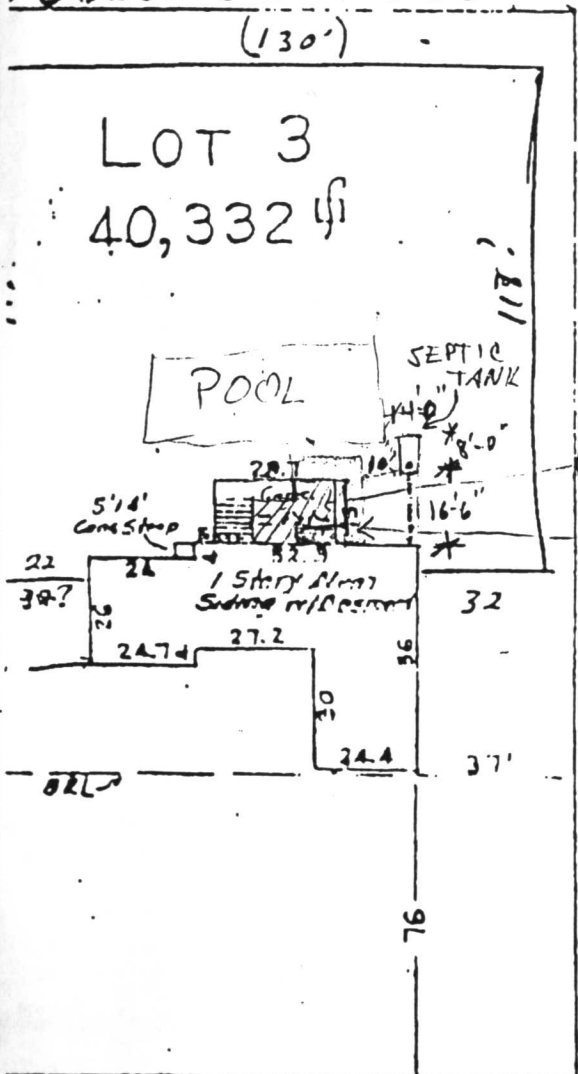

B00101954
REVIS 560 DECK
LOCATION OK,
WILL ACCEPT
DECK UP TO
8' FROM
EDGE OF SEPTIC
TANK

HOUSE LOCATION SURVEY

LOT 3

WHITE OAK ESTATES
HIGHLAND ROAD
CLARKSVILLE, MARYLAND
5th Election District
Howard County, Maryland

8/25/96
C. Will
HOW TO HEALTH

I herewith certify that all field survey work was performed under my personal direction during my presence on the property.

I hereby certify that the position of all the existing improvements on the above described property have been carefully established by a transit-tape survey, and unless otherwise shown, there are no encroachments.

Cedric B. Samuel
Cedric B. Samuel
Maryland 282

RECEIVED
AUG 27 1996

HOWARD COUNTY HEALTH DEPARTMENT
BUREAU OF ENVIRONMENTAL HEALTH

DEANMAR DRIVE

N 64° 51' 18" W 140.49'

130
117
117
32
32
424

110
+ 8.50
340

