

122

SEQUENCE NO. (OEP USE ONLY)

STATE OF MARYLAND WELL COMPLETION REPORT

THIS REPORT MUST BE SUBMITTED WITHIN 45 DAYS AFTER WELL IS COMPLETED.

COUNTY NUMBER A28417

Date Received (OEP use only)

DATE WELL COMPLETED

092681

Depth of Well

105

(TO NEAREST FOOT)

PERMIT NO.

FROM "PERMIT TO DRILL WELL"

HO-73-4128

OWNER Woodmark Inc. last name first name Farside Rd. TOWN Columbia SUBDIVISION Farside SECTION LOT 39

WELL LOG Not required for driven wells STATE THE KIND OF FORMATIONS PENETRATED, THEIR COLOR, DEPTH, THICKNESS AND IF WATER BEARING

Table with columns: DESCRIPTION (Use additional sheets if needed), FEET (FROM, TO), Check if water bearing. Rows include Top Soil, Brown Shale, Sand, Granite, Gravel, Granite.

GROUTING RECORD WELL HAS BEEN GROUTED (Circle Appropriate Box) TYPE OF GROUTING MATERIAL CEMENT CM BENTONITE CLAY BC NO. OF BAGS 10 NO. OF POUNDS 740 GALLONS OF WATER 60 DEPTH OF GROUT SEAL (to nearest foot) from 0 ft. to 28 ft.

CASING RECORD casing types insert appropriate code below MAIN CASING TYPE ST Nominal diameter top/main/casing (nearest inch) 6 Total depth of main casing (nearest foot) 30

OTHER CASING (if used) diameter inch depth (feet) from to

SCREEN RECORD screen type or open hole insert appropriate code below ST BR HO STEEL BRASS OPEN HOLE PL BRONZE HOLE PLASTIC OTHER

DEPTH (nearest ft.) HO 28 105

SLOT SIZE DIAMETER OF SCREEN (NEAREST INCH) from to

CIRCLE APPROPRIATE BOX A A WELL WAS ABANDONED AND SEALED WHEN THIS WELL WAS COMPLETED E ELECTRIC LOG OBTAINED P TEST WELL CONVERTED TO PRODUCTION WELL

I HEREBY CERTIFY THAT THIS WELL HAS BEEN CONSTRUCTED IN ACCORDANCE WITH COMAR 10.17.13 "WELL CONSTRUCTION" AND IN CONFORMANCE WITH ALL CONDITIONS STATED IN THE ABOVE CAPTIONED PERMIT...


DRILLERS IDENT. NO. 308 DRILLERS SIGNATURE (MUST MATCH SIGNATURE ON APPLICATION)

SITE SUPERVISOR (sign of driller or journeyman responsible for sitework if different from permittee)

GRAVEL PACK IF WELL DRILLED WAS FLOWING WELL CIRCLE BOX F OEP USE ONLY (NOT TO BE FILLED IN BY DRILLER) T TELESCOPE CASING (E.R.O.S.) LOG INDICATOR W O OTHER DATA

PUMPING TEST C 3 (seq no) HOURS PUMPED (nearest hour) 3 PUMPING RATE (gal. per min. to nearest gal.) 10.60 METHOD USED TO MEASURE PUMPING RATE Bucket WATER LEVEL (distance from land surface) BEFORE PUMPING 10 WHEN PUMPING 13 TYPE OF PUMP USED (for test) A air P piston T turbine C centrifugal R rotary O other (describe below) J jet S submersible

PUMP INSTALLED YES NO DRILLER WILL INSTALL PUMP (CIRCLE APPROPRIATE BOX) Y N IF DRILLER INSTALLS PUMP, THIS SECTION MUST BE COMPLETED FOR ALL WELLS EXCEPT HOME USE TYPE OF PUMP (WRITE APPROPRIATE LETTER IN BOX - SEE ABOVE: (A, C, J, P, R, S, T, O)) CAPACITY: GALLONS PER MINUTE (to nearest gallon) PUMP HORSE POWER PUMP COLUMN LENGTH (nearest ft.) CASING HEIGHT (circle appropriate box and enter casing height) above LAND SURFACE below (nearest foot)

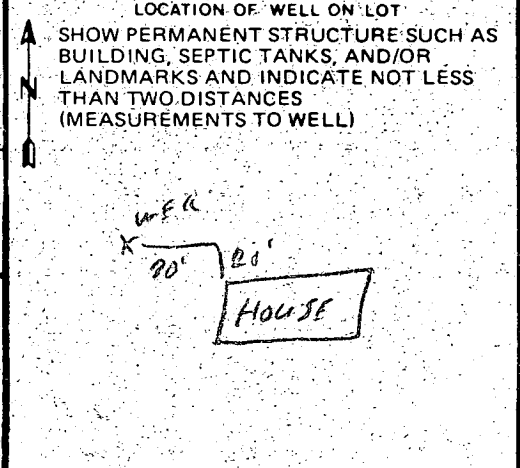

STATE OF MARYLAND
PERMIT TO DRILL WELL

OEP PERMIT NUMBER

H0-73-4128
fill in this form completely

5677 SEQUENCE NO. (OEP USE ONLY)

(THIS NUMBER IS TO BE PUNCHED IN COLS. 3-6 ON ALL CARDS)

please print or type

Date Received 3/26/82 1:30 P.M. (OEP Use Only)

OWNER INFORMATION

WLODMARK INC
Last Name 15 Owner 34 Name

121150 MT ALBERT CITI
36 Street or RFD 55

ELLICKHITI CITY MD 211043
Town 57 State 76 Zip

B 3 LOCATION OF WELL

COUNTY Howard 21

SUBDIVISION Farside

SECTION 23 44 LOT 39 48 50

NEAREST TOWN Columbia 52 71

MILES FROM TOWN (enter o if in town) 3 73 M I 76 77 78

B 1 Continued DRILLER INFORMATION

Stanley W. Bollinger Jr. 308
Driller's Name 77 License No. 80

Stan's Well Drilling Inc
Firm Name

PO Box 2035 Westminster
Address

Signature Stanley W. Bollinger Jr. Date 2-25-82

B 4

DIRECTION OF WELL FROM TOWN (CIRCLE BOX)

ON WHICH SIDE OF ROAD (CIRCLE APPROPRIATE BOX)

Farside Rd
NEAR WHAT ROAD 30

150
DISTANCE FROM ROAD 34 FEET 37 M I 38 39

B 2 WELL INFORMATION

APPROX. PUMPING RATE (GAL. PER MIN.) 5 12

AVERAGE DAILY QUANTITY NEEDED (GAL. PER DAY) 500 14 20

USE FOR WATER (CIRCLE APPROPRIATE BOX)

HOME (SINGLE OR DOUBLE HOUSEHOLD UNIT ONLY)

FARMING (LIVESTOCK WATERING & AGRICULTURAL IRRIGATION)

INDUSTRIAL, COMMERCIAL, STATE AND FEDERAL GOV. OTHER (REQUIRES APPROPRIATION PERMIT)

PUBLIC OR PRIVATE WATER COMPANY (REQUIRES APPROPRIATION PERMIT AND STATE HEALTH DEPARTMENT APPROVAL)

TEST, OBSERVATION, MONITORING (MAY REQUIRE APPROPRIATION PERMIT)

SHOW MAJOR FEATURES OF BOX & LOCATE WELL WITH AN X

SOURCES OF DRILLING WATER

1.
2.
3.

WRITE THE BOX NUMBER FROM THE MAP HERE

E 820 3
N 510 7

APPROXIMATE DEPTH OF WELL 165 24 FEET 28

APPROXIMATE DIAMETER OF WELL 6 30 NEAREST INCH 28

METHOD OF DRILLING (circle one)

BORED (OR AUGERED) JETTED JETTED & DRIVEN

30 AIR ROTARY AIR PERCUSSION ROTARY (HYDRAULIC ROTARY)

37 CABLE REVERSE ROTARY DRIVE POINT

other

REPLACEMENT OR DEEPEINED WELLS (CIRCLE APPROPRIATE BOX)

THIS WELL WILL NOT REPLACE AN EXISTING WELL THIS WELL WILL REPLACE A WELL THAT WILL BE ABANDONED AND SEALED

THIS WELL WILL REPLACE A WELL THAT WILL BE USED AS A STANDBY

THIS WELL WILL DEEPEIN AN EXISTING WELL PERMIT NUMBER OF WELL TO BE REPLACED OR DEEPEINED (IF AVAILABLE) 41 52

Not to be filled in by driller (OEP USE ONLY)

APPROP. PERMIT NUMBER 54 GAP 63

FORCE FS WRITE INITIALS IN BOX PERMIT No. H0-73-4128 70 71 72 73 74 75 76 77 78 79

DRAW A SKETCH BELOW SHOWING LOCATION OF WELL IN RELATION TO NEARBY TOWNS AND ROADS AND GIVE DISTANCE FROM WELL TO NEAREST ROAD JUNCTION

B 4 NOT TO BE FILLED IN BY DRILLER HEALTH DEPARTMENT APPROVAL

Howard COUNTY NAME 728117 COUNTY NO.

OEP SIGNATURE STATE HEALTH CIRCLE BOX 41


DATE ISSUED 030982 528117

CO SIGNATURE Frank Shinn

NORTH GRID 517 50 EAST GRID 0823 55 63 EXPIRES 090982 57 63

B 5 SPECIAL CONDITIONS 8-63

1 2 3 6

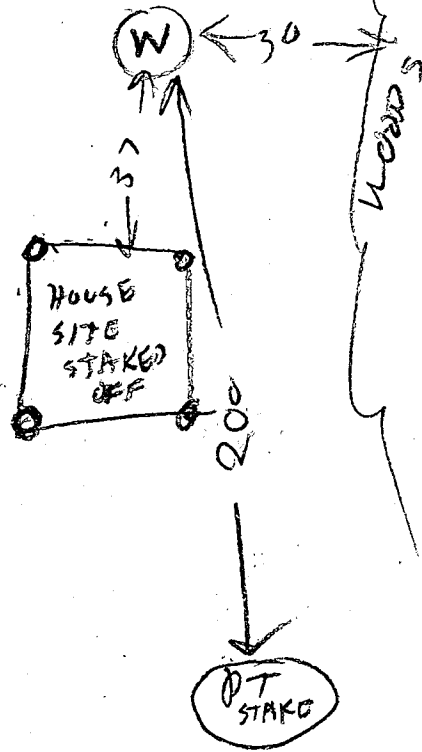

LOCATION OK

RD

- ① 30 ft casing 1 FT OUT OF GROUND
- ② 22 FT OPEN HOLE
- ③ 60 GAL/MIN
- ④ PIPE JETTED DOWN WELL 29 FT
- ⑤ 10 BAGS USED
- ⑥ WELL OK

3/26/82

SAMPLE TAKEN &
YIELD TEST RUN TODAY SEE
OTHER SHEET