

4/18/01
11-12 layout
4/18/01 - PM
4/20/01
10:00
5/7/01
House
Connection
Anytime

PERMIT 03-332292

P 515024-C

SEWAGE DISPOSAL SYSTEM
HOWARD COUNTY HEALTH DEPARTMENT
BUREAU OF ENVIRONMENTAL HEALTH
410-313-2640

A 513199-S

ISSUE DATE 4/5/2001

APPROVAL DATE 5/8/01

INDEXED

South Carroll Backhoe, Inc. IS PERMITTED TO INSTALL ALTER

ADDRESS 4410 Salem Bottom Road, Westminster, MD 21157 PHONE 410-875-4197

SUBDIVISION Brantwood II LOT NUMBER 16 ADDRESS 3108 Argent Path

PROPERTY OWNER NV Homes PROPERTY OWNER'S ADDRESS 2200 Defense Hwy

SEPTIC TANK CAPACITY 1250 GALLONS ** TOP SEAMED SEPTIC TANK REQUIRED ** Crofton, MD 21114

PUMP CHAMBER CAPACITY N/A GALLONS

NUMBER OF BEDROOMS 4

SQUARE FEET PER BEDROOM 180

LINEAR FEET OF TRENCH REQUIRED 240

TRENCHES: Trenches to be 3 feet wide. Inlet 24 feet below original grade. Bottom maximum depth

46 feet below original grade. 2 feet of stone below distribution box. drain pipe.

LOCATION: Begin trenches 45 feet off the front lot line and 105 feet off the left lot line as seen when facing the lot from Argent Path. Run trenches on contour toward the left front property corner.

OK 11/17/00

SPECS CHANGED ON 4/18/01 - (SRK)

PLANS APPROVED Amy McMillen, R.S. DATE 11/16/2000

PERMIT VOID AFTER 2 YEARS

NOTE: CONTRACTOR RESPONSIBLE FOR SCHEDULING A PRE-CONSTRUCTION INSPECTION FOR ALL INSTALLATIONS

NOTE: TOP OF SEPTIC TANKS ARE TO BE NO DEEPER THAN 3.0 FEET BELOW FINISH GRADE

NOTE: WATERTIGHT SEPTIC TANKS REQUIRED

NOTE: CLEANOUT REQUIRED EVERY 70 FEET OF SEWER LINE AND/OR AT 90° SWEEPS IN LINES FROM HOUSE TO DRAIN FIELDS, 90° ELBOWS ARE NOT ACCEPTABLE

NOTE: ALL PARTS OF SEPTIC SYSTEMS (I.E. TANK, DISTRIBUTION BOX, DRAINFIELDS) TO BE 100 FEET FROM ANY WATER WELL UNLESS OTHERWISE SPECIFICALLY AUTHORIZED

NOTE: NO ABSORPTION TRENCH TO EXCEED 100 FEET IN LENGTH UNLESS SPECIFICALLY AUTHORIZED

NOTE: ALL PIPE FROM HOUSE TO SEPTIC TANK MUST BE CAST IRON OR SCHEDULE 35/40 PVC OR ABS

NOTE: MANHOLE RISERS REQUIRED ON ALL SEPTIC TANKS AND PUMP CHAMBERS

NOTE: DISTRIBUTION BOXES MUST HAVE BAFFLES


NOTE: IF PUMPED SEPTIC SYSTEM REQUIRED, (1) SEPTIC PUMP DETAIL TO BE PROVIDED BY INSTALLER PRIOR TO ISSUANCE OF SEPTIC PERMIT (2) PUMP PERFORMANCE TEST IS NECESSARY PRIOR TO HEALTH DEPARTMENT APPROVAL OF SEPTIC PERMIT

ALL SEWER LINES
TO BE RETURNED 12/20/01
B00133553
DECK W/STEPS 22x14

NEITHER THE HOWARD COUNTY COUNCIL NOR THE HEALTH DEPARTMENT IS RESPONSIBLE FOR THE SUCCESSFUL OPERATION OF ANY SYSTEM
PERMITTEE RESPONSIBLE FOR OBTAINING FINAL APPROVAL ON THIS PERMIT
CALL 410-313-2640 FOR INSPECTION OF SEPTIC SYSTEM

P515024-C

NOT TO SCALE

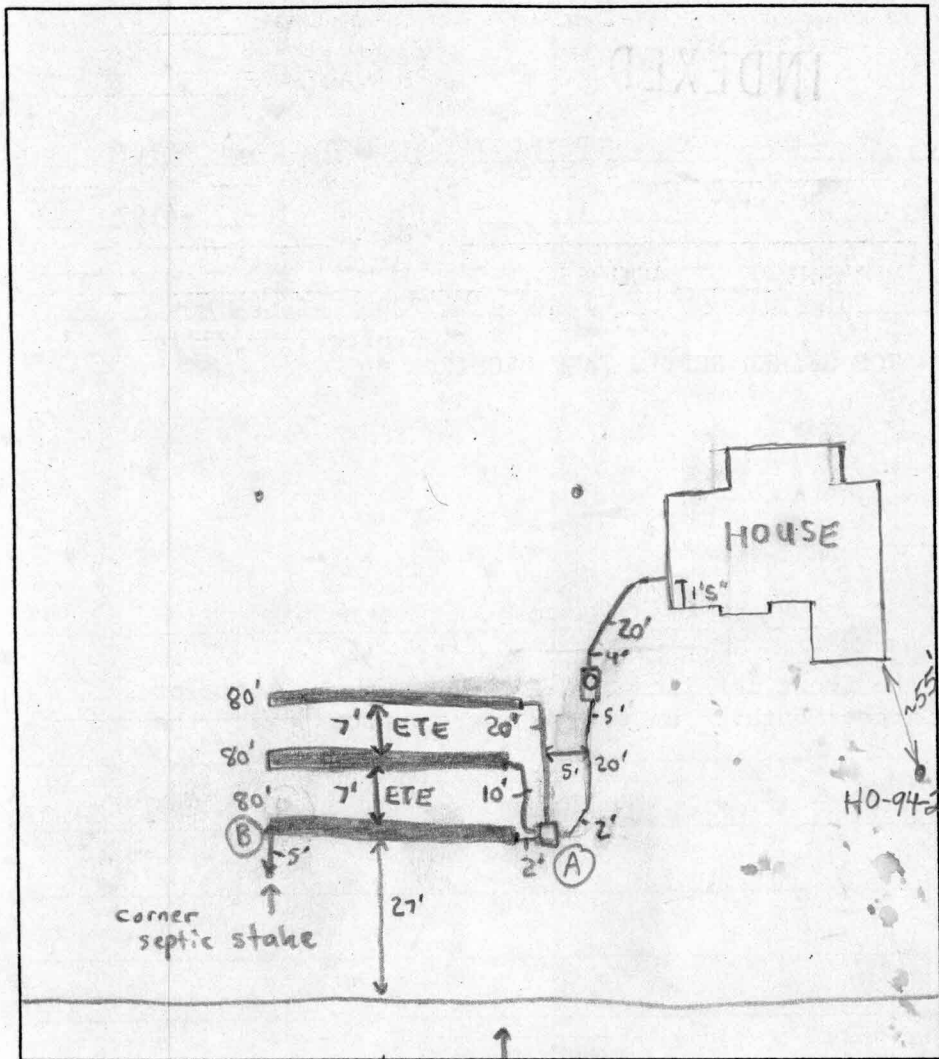

TRENCH DATA	
TRENCH WIDTH	3'
TRENCH INLET DEPTH	4'
TRENCH BOTTOM DEPTH	6'
DEPTH OF STONE	2'
NUMBER OF TRENCHES	3
TOTAL TRENCH LENGTH	240'
ABSORBENT AREA	720ft ²
DISTRIBUTION BOX LEVEL	<input checked="" type="checkbox"/>
BAFFLE IN DISTRIBUTION BOX	<input checked="" type="checkbox"/>

SEPTIC TANK DATA	
SEPTIC TANK	1500 TS GALLONS
BAFFLES IN	<input checked="" type="checkbox"/>
MANHOLE RISER	on front
6 INCH INSPECTION PORT	NA

PUMP CHAMBER DATA	
PUMP CHAMBER GALLONS	NA
MANHOLE RISER	NA
ALARM	NA
PUMP PERFORMANCE TEST	NA

PRE-CONSTRUCTION INSPECTION: Argent Path 4/16/01 System to be installed as per BP plan. Septic tank to be outside of well radius. (BB)

INSPECTION COMMENTS: 4/18/01 - CONTOUR ALTERED DUE TO (1-2') OF FILL & GRADING - SO INSTALL DBOX IN LOCATION (A) AND RUN 3-80' TRENCHES TOWARDS LEFT LOT LINE, (INLET ON AT 4' BOTTOM AT 6') TOWARDS (B) (SRW) 4/20/01 - SYSTEM COMPLETE PENDING HOUSE CONN (SRW)

5/8/01 FINAL INSP - OC TO COVER ALL WORK, HOUSE CONNECTION CONFIRMED. DIC

INSPECTOR Donna K. Clark DATE SYSTEM APPROVED 5/8/01