

12/4/01
-00
house Conn

PERMIT

SEWAGE DISPOSAL SYSTEM

DEPARTMENT OF HEALTH AND MENTAL HYGIENE

WARD COUNTY HEALTH DEPARTMENT
BUREAU OF ENVIRONMENTAL HEALTH
461-9933

P 515302-C

A 513199-A

DISTRICT _____

DATE 6/22/2001

CONN.
DATE SYSTEM APPROVED 8/9/01

INSPECTOR S.R.K.

INDEXED
03-333027

South Carroll Backhoe, Inc _____ IS PERMITTED TO INSTALL ALTER _____

ADDRESS 4410 Salem Bottom Road, Westminster, MD 21157 PHONE 410-875-4197

WATER DIVISION Brantwood 2/2 LOT 1 ROAD 3109 Argent Path

PROPERTY OWNER NV Homes

ADDRESS 2200 Defense Hwy, Crofton, MD 21114 410-721-4703

NUMBER OF BEDROOMS: 4

- House is served by a shared community septic system. As part of the general permit for the community system, items previously installed or under construction include grinder pump installation, connection from grinder pump to common effluent line and house and shared disposal fields.


- This permit is limited to installation of the individual house sewer line and grinder pump installation only as per the signed building permit site plan. Copy Attached. *OK All*

4/19/01 OK (BB)

**CLASS. PERMIT SYSTEM
AND RETURNED 1/16/02**

608133948-20X12 DECK

DATE 4/2/2001

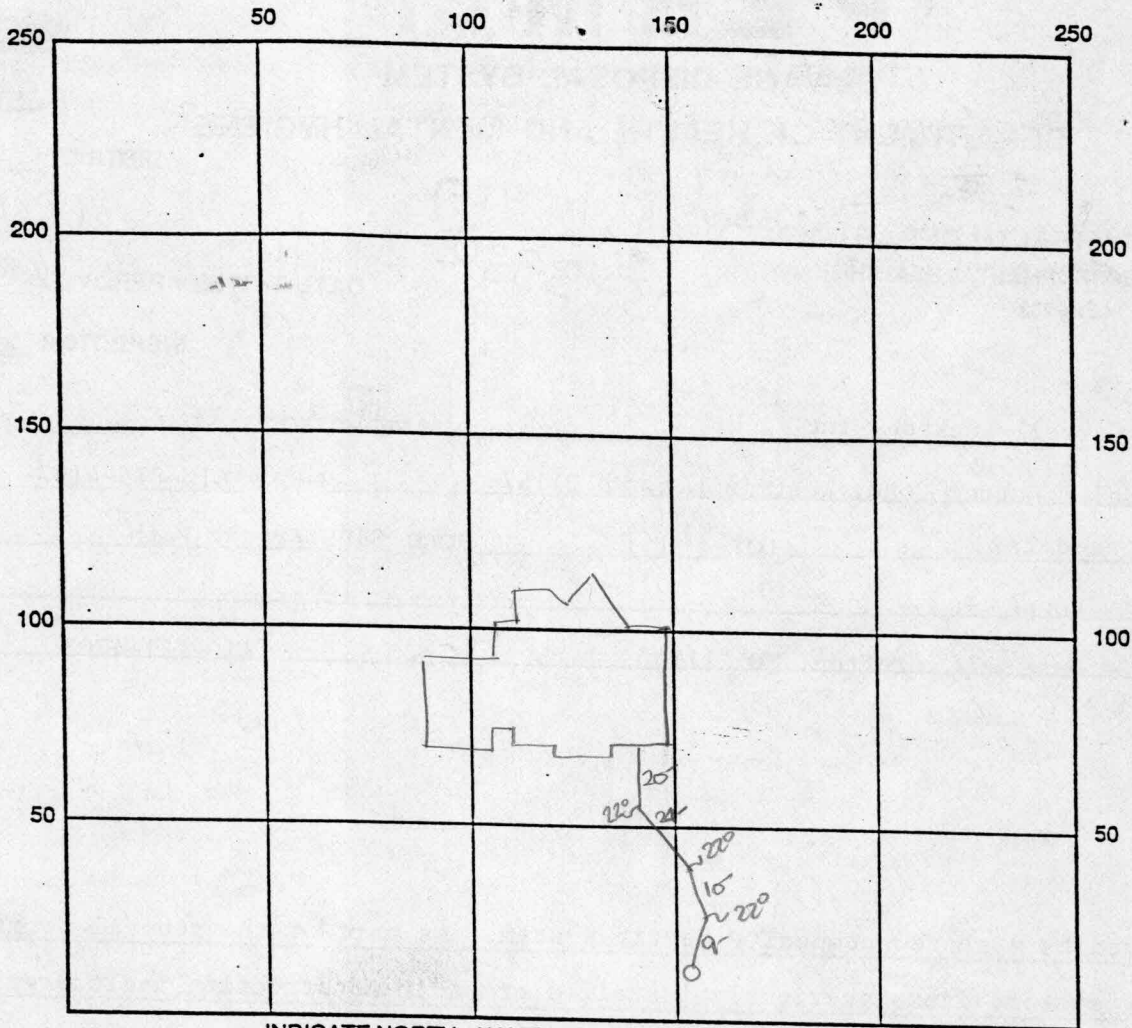

INDICATE NORTH - NAME ADJOINING ROADWAY AS BASE LINE

Argent Path

SEPTIC TANK LEVEL _____ CLEANOUTS _____

REMARKS: House connection OK - OK to cover all septic work. DKC

8/9/01 - RECEIVED FAX FROM MATT TUDER REGARDING PUBLIC WORKS APPROVAL - (SRK)

DATE SYSTEM APPROVED 8/9/01 INSPECTOR Steven R. Krieg

CONN.

FAX
cover sheet



Bureau of Utilities
8270 Old Montgomery Rd.
Columbia, Md. 21045
Tel. : 410 313 4900
Fax : 410 313 4989

To: Water & Sewer Program

Date: 8/9/01 Number of pages including this one one

Fax Number: 2648

From: Matt Tudor

Comments: Brantwood Shared Septic

Rob of NV Hanes has contacted our office to
confirm septic tank hauling arrangements. Hatfield's
Equipment has been contracted to pump out the tanks
every two weeks. All of the isolation valves are
closed at the distribution box.

Lot # 1 is released for U.S.O.

3109 ~~343~~ Argent Path

Contract # 3816