

SEEDING NOTES


AREAS NOT SUBJECT TO IMMEDIATE PERMANENT LONG-LIVED VEGETATIVE

21.0 STANDARDS AND SPECIFICATION

Definition

Placement of topsoil over a prepared subsoil prior to

III. For 9

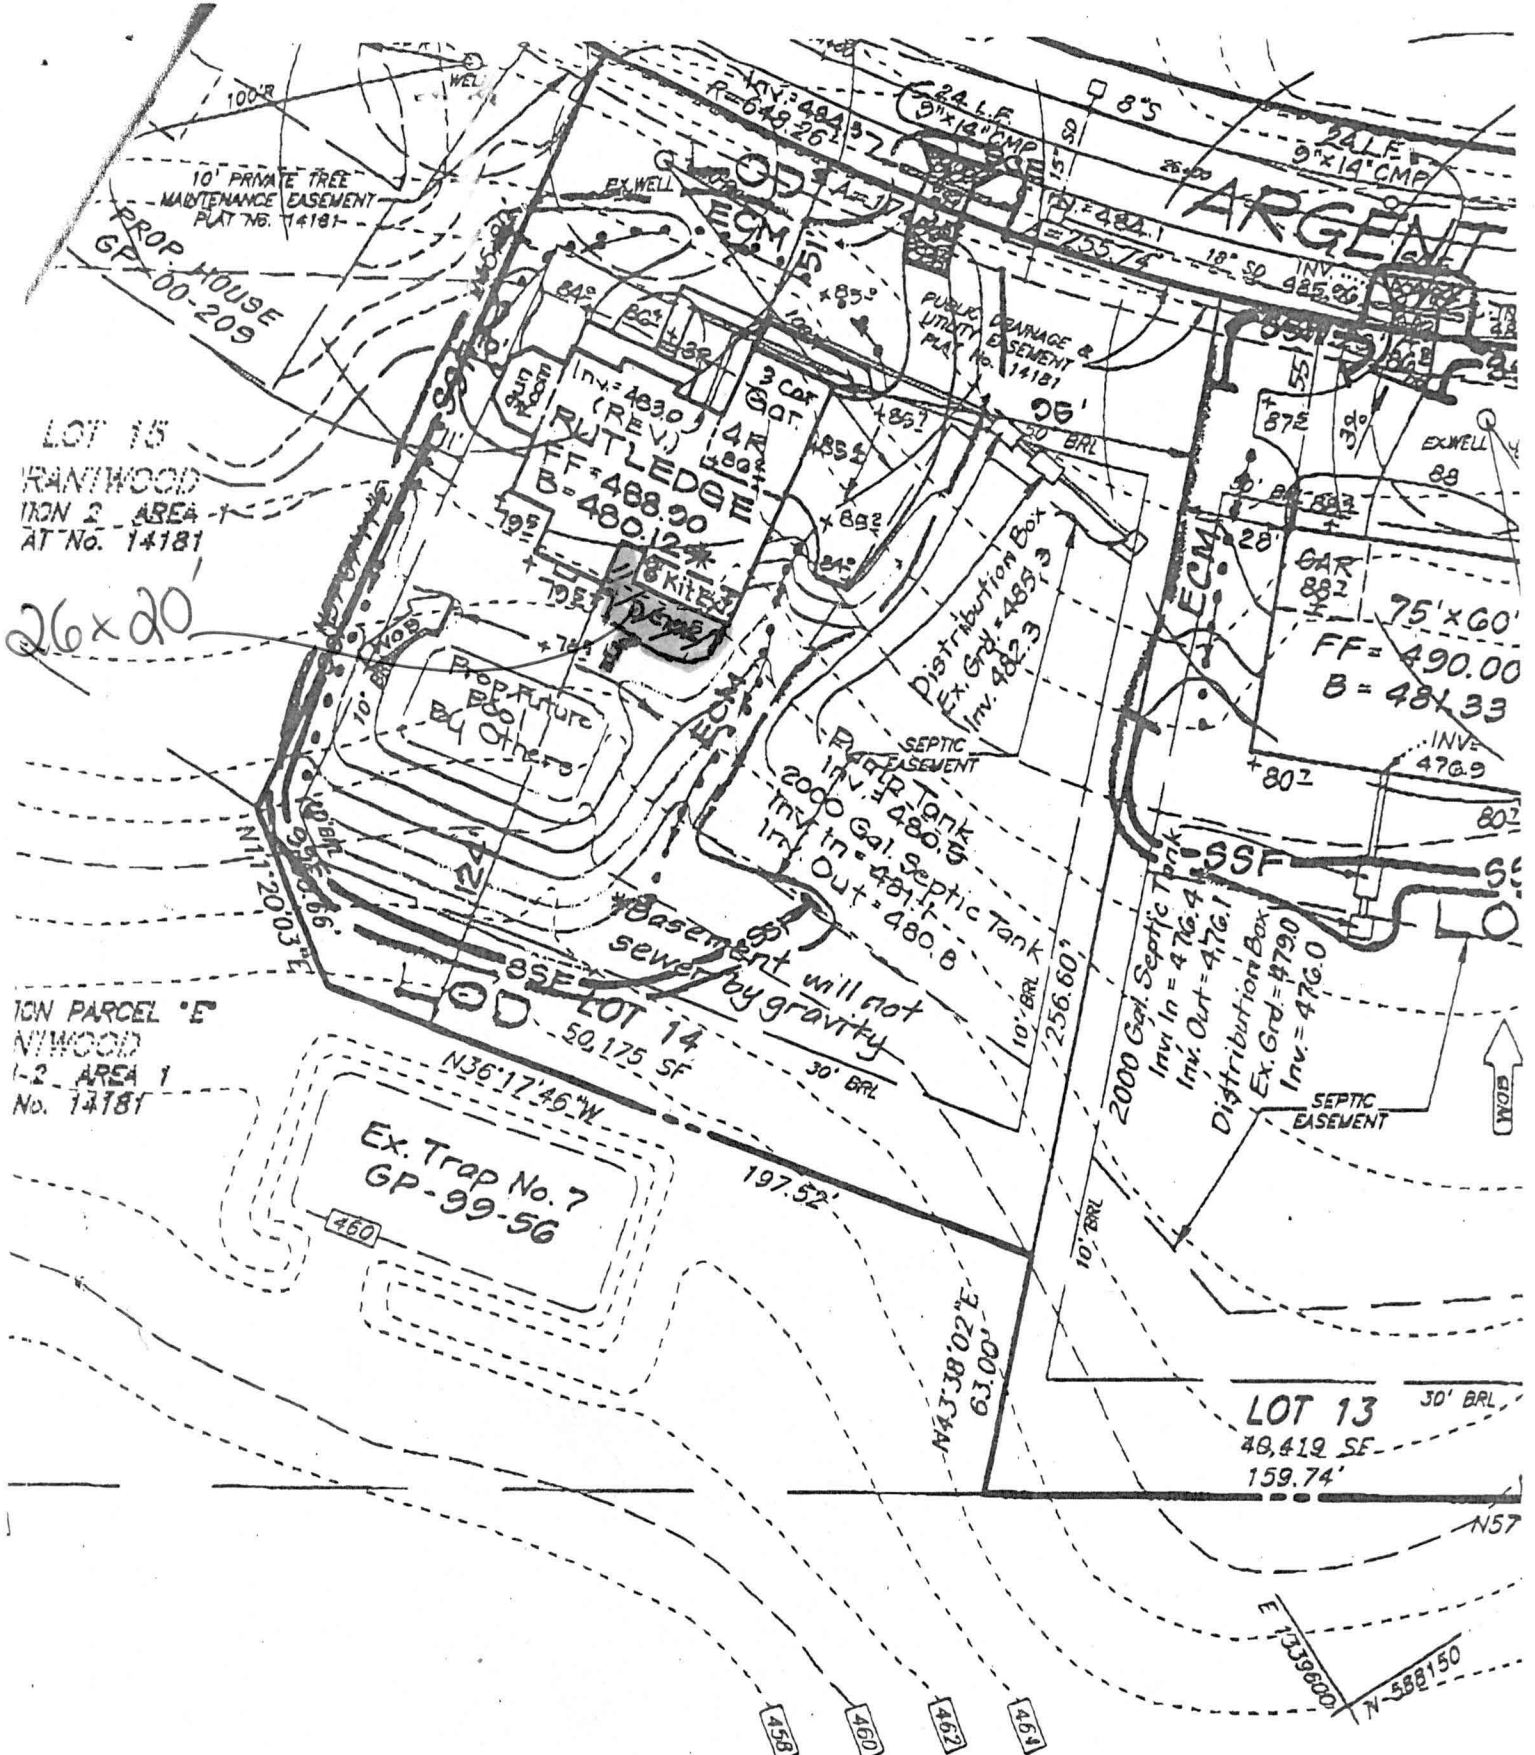

SEEDING NOTES

AREAS NOT SUBJECT TO IMMEDIATE PERMANENT LONG-LIVED VEGETATIVE


21.0 STANDARDS AND SPECIFICATION:

Definition

Placement of topsoil over a prepared subsoil prior to establishment of permanent vegetation

III. For site

1. Pl.

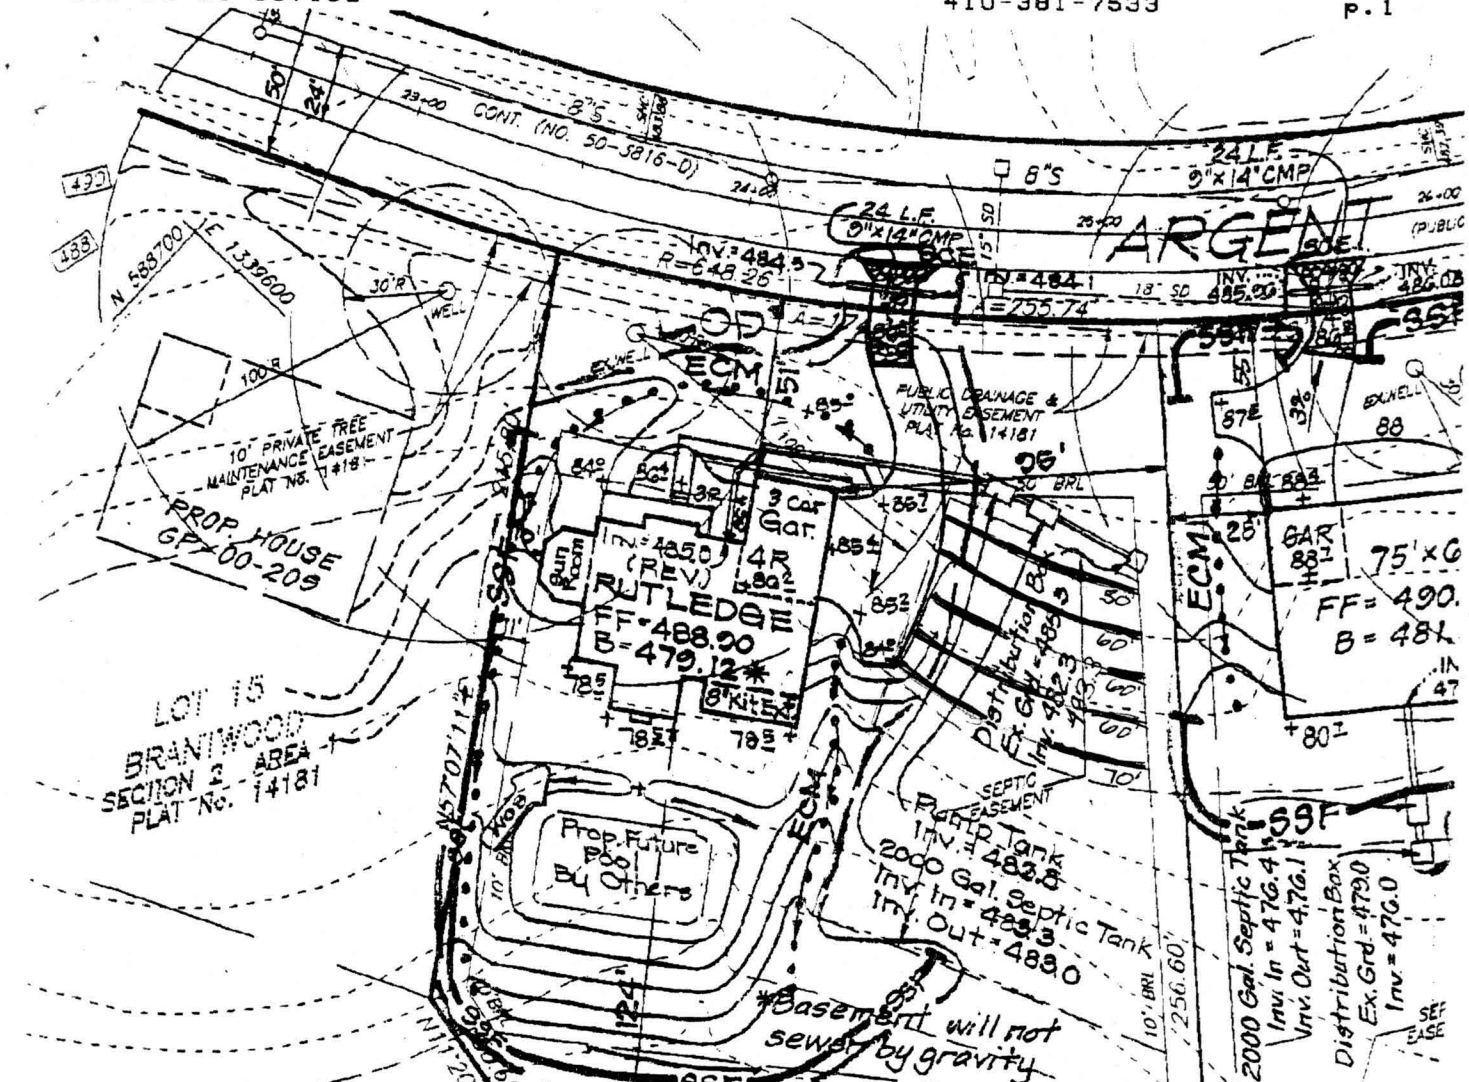

Total linear feet of trench required 300 feet

Width of trench parcel 30 feet

Depth of trench parcel 4.0 feet

Depth of stone required below distribution pipe 2.0 feet

Approved Septic System Plan
Howard County Health Department

BRANTWOOD 2/2
ATTN Amy McMillen
Ho Co Health 12-6-00

Amy McMillen
Signature _____ Date 12/6/00

21.0 STANT

Definition
over a prepared s
station.