


28-2003

EXISTING SUPER SILT FENCE TO BE REMOVED

Approved ~~_____~~
Howard County Health Department

PRESERVATION PARCEL "C"
BRANTWOOD SECTION 1

Amelia Mill
Signature Date 6/28/01

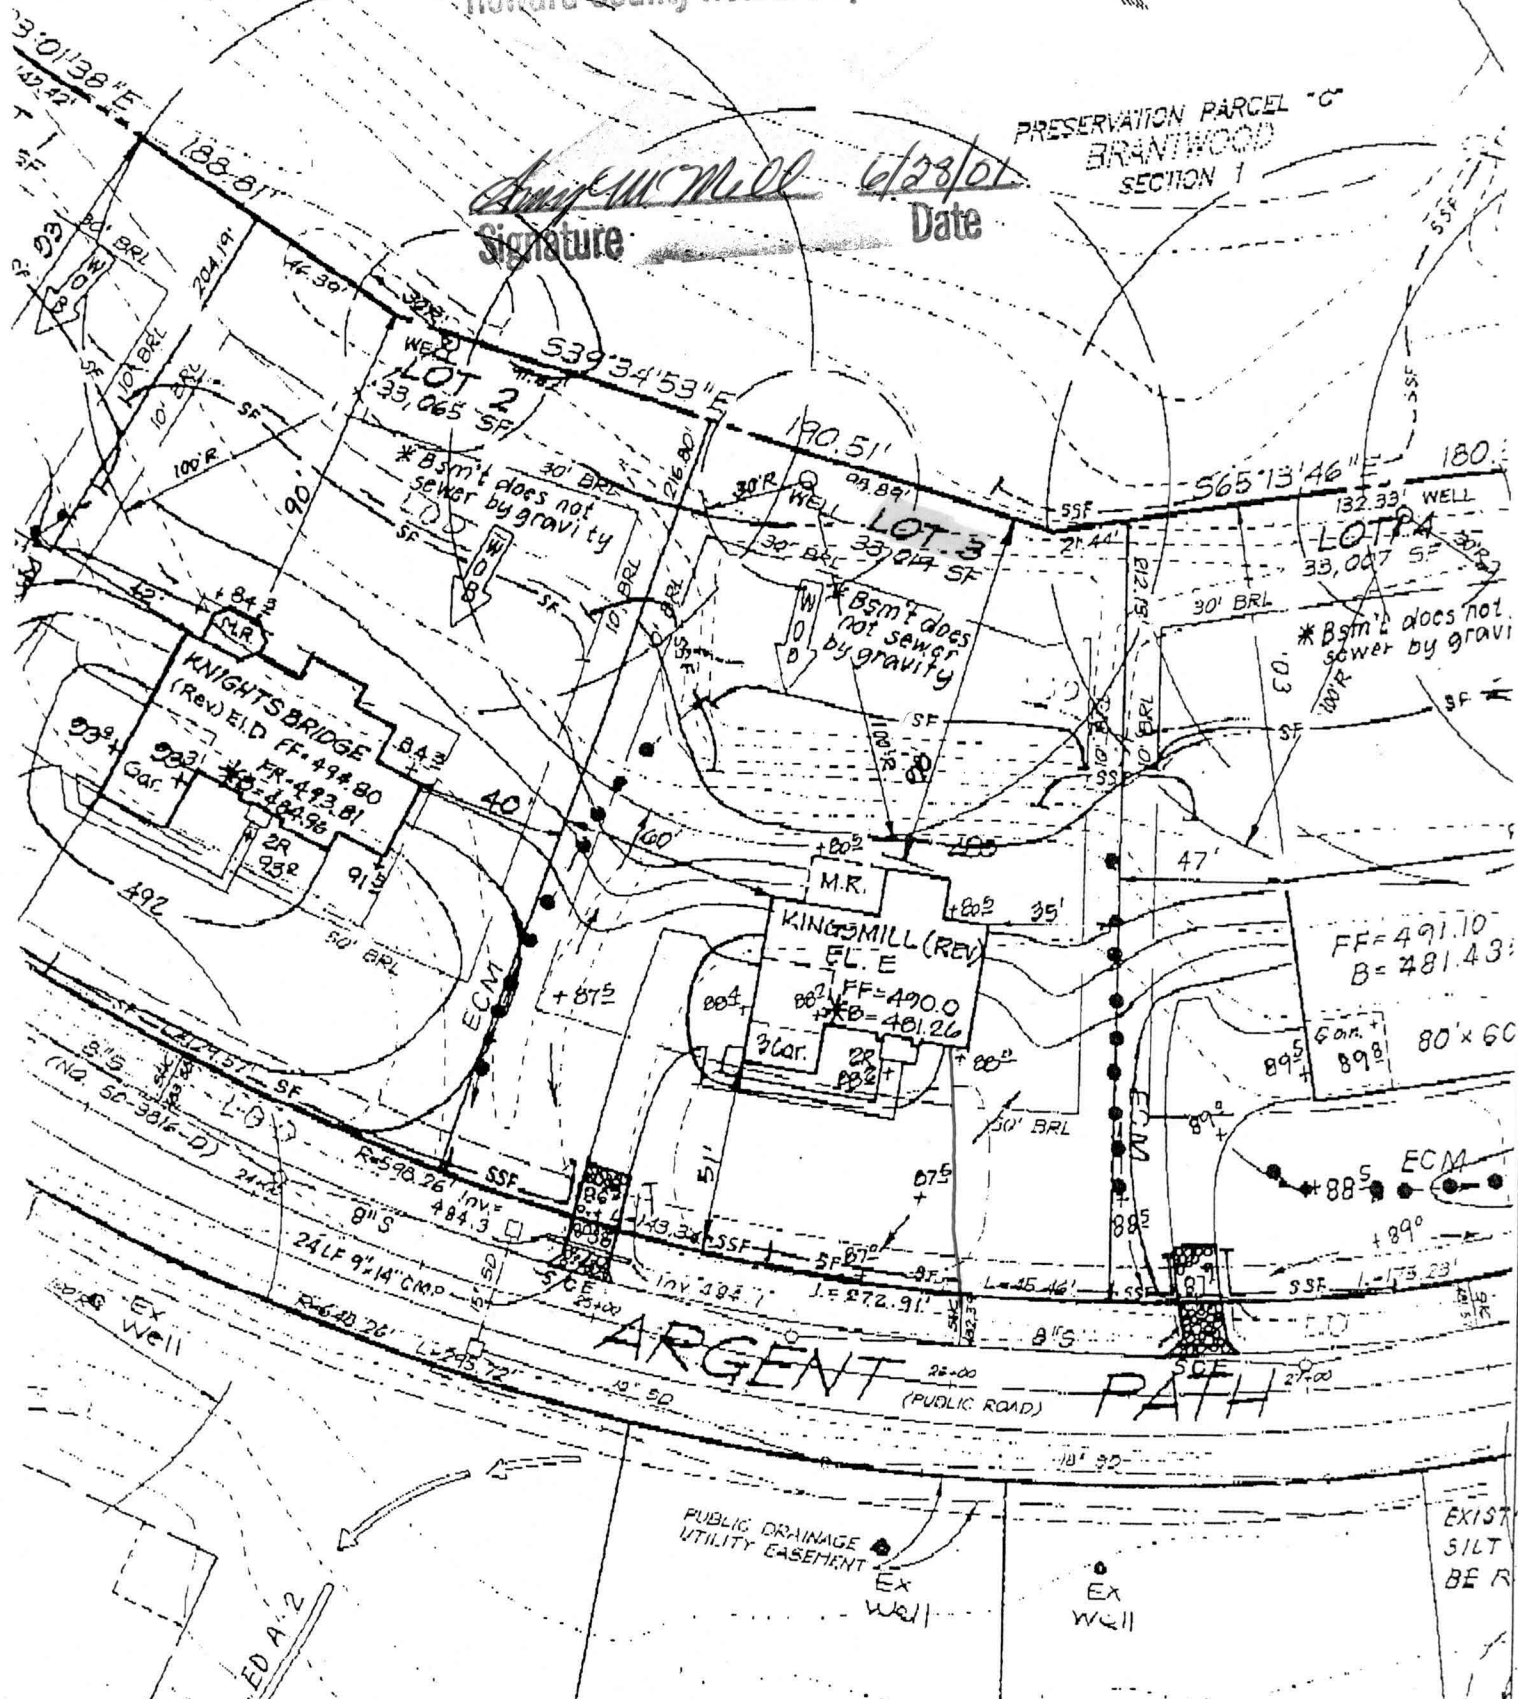


BRANTWOOD
SECTION I
PRESERVATION
PARCEL "C"
PLAT No. 13729

2/13/02

Proposed Deck
and Gazebo O.K.

LOT 4 **BB**

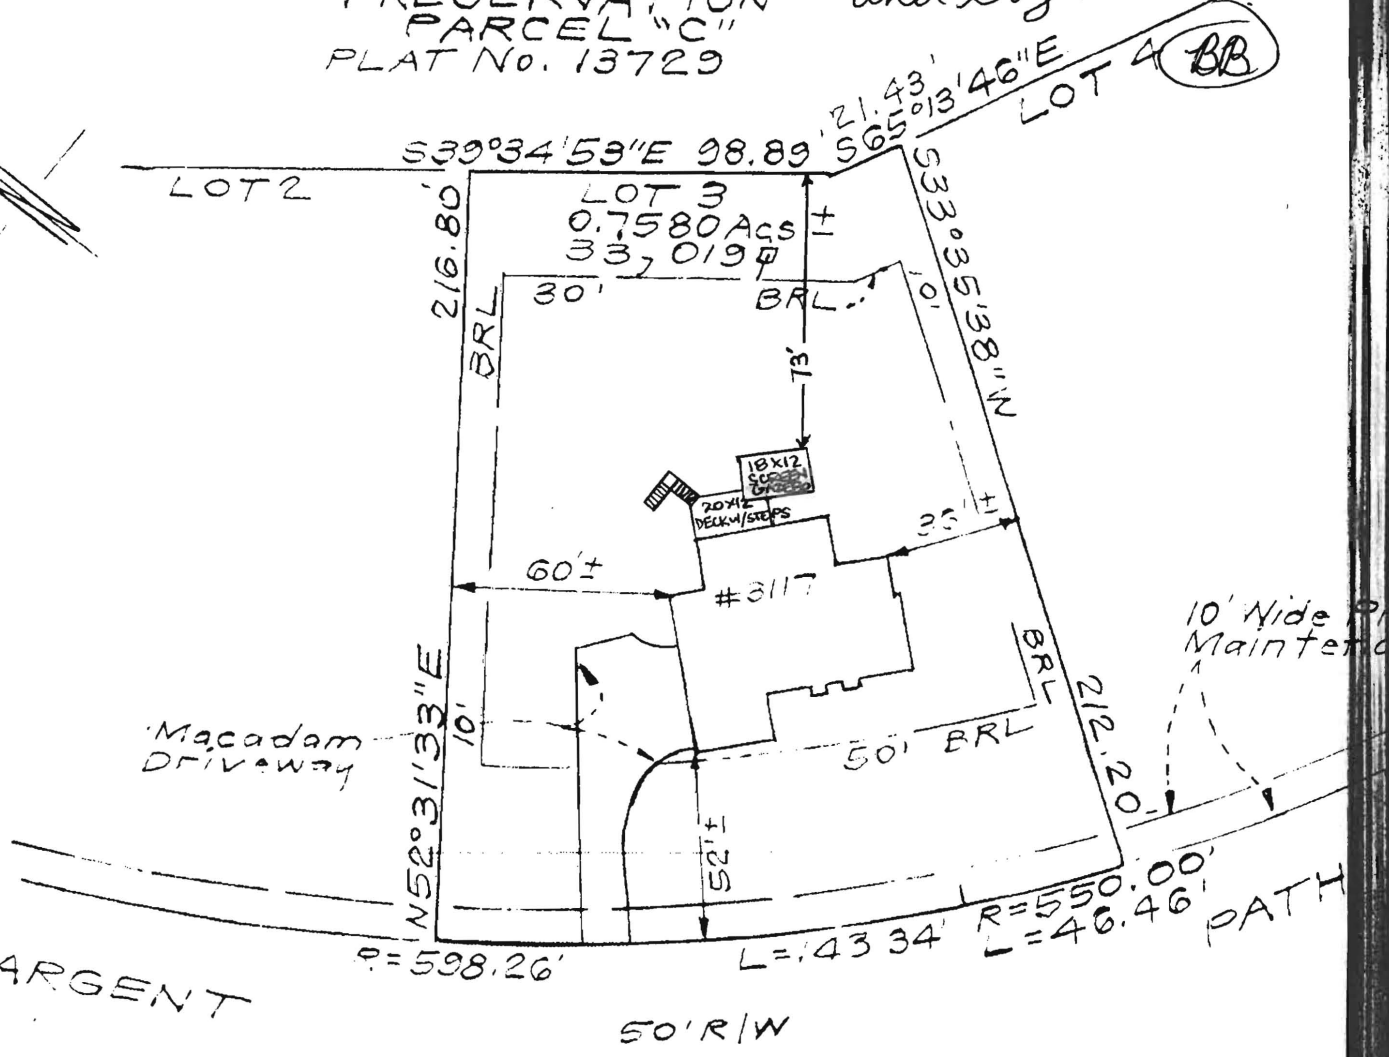

ARGENT

50' R/W