

1" = 60'

**APPROVED**  
**WALK-THRU BUILDING PERMIT**  
 BP# Bc015075 A# 576085  
 APP. SAN JB DATE: 9/21/09  
 DESC. OF WORK: Deck w/ steps

**ADDRESS:** 3140 ARGENT PATH  
 ELLICOTT CITY, MARYLAND 21042

**NOTES:**

1. THIS IMPROVEMENT LOCATION DRAWING:
  - A. IS OF BENEFIT TO A CONSUMER ONLY INsofar AS IT IS REQUIRED BY A LENDER OR A TITLE INSURANCE COMPANY OR ITS AGENT IN CONNECTION WITH CONTEMPLATED TRANSFER, FINANCING OR REFINANCING;
  - B. IS NOT TO BE RELIED UPON FOR THE ESTABLISHMENT OR LOCATION OF FENCES, GARAGES, BUILDINGS, OR OTHER EXISTING OR FUTURE IMPROVEMENTS; AND
- C. DOES NOT PROVIDE FOR THE ACCURATE IDENTIFICATION OF PROPERTY BOUNDARY LINES, BUT SUCH IDENTIFICATION MAY NOT BE REQUIRED FOR THE TRANSFER OF TITLE OR SECURING FINANCING OR REFINANCING.
2. THE LEVEL OF ACCURACY OF APPARENT SETBACK DISTANCES IS ONE FOOT, MORE OR LESS.
3. THIS PLAT WAS PREPARED WITHOUT BENEFIT OF A TITLE REPORT.




41201 Maintain 15' from well to driveway - All

Approved Septic System Plan  
Howard County Health Department

2/2  
17

*Ann M. Hill*  
Signature  
4/2/01  
Date

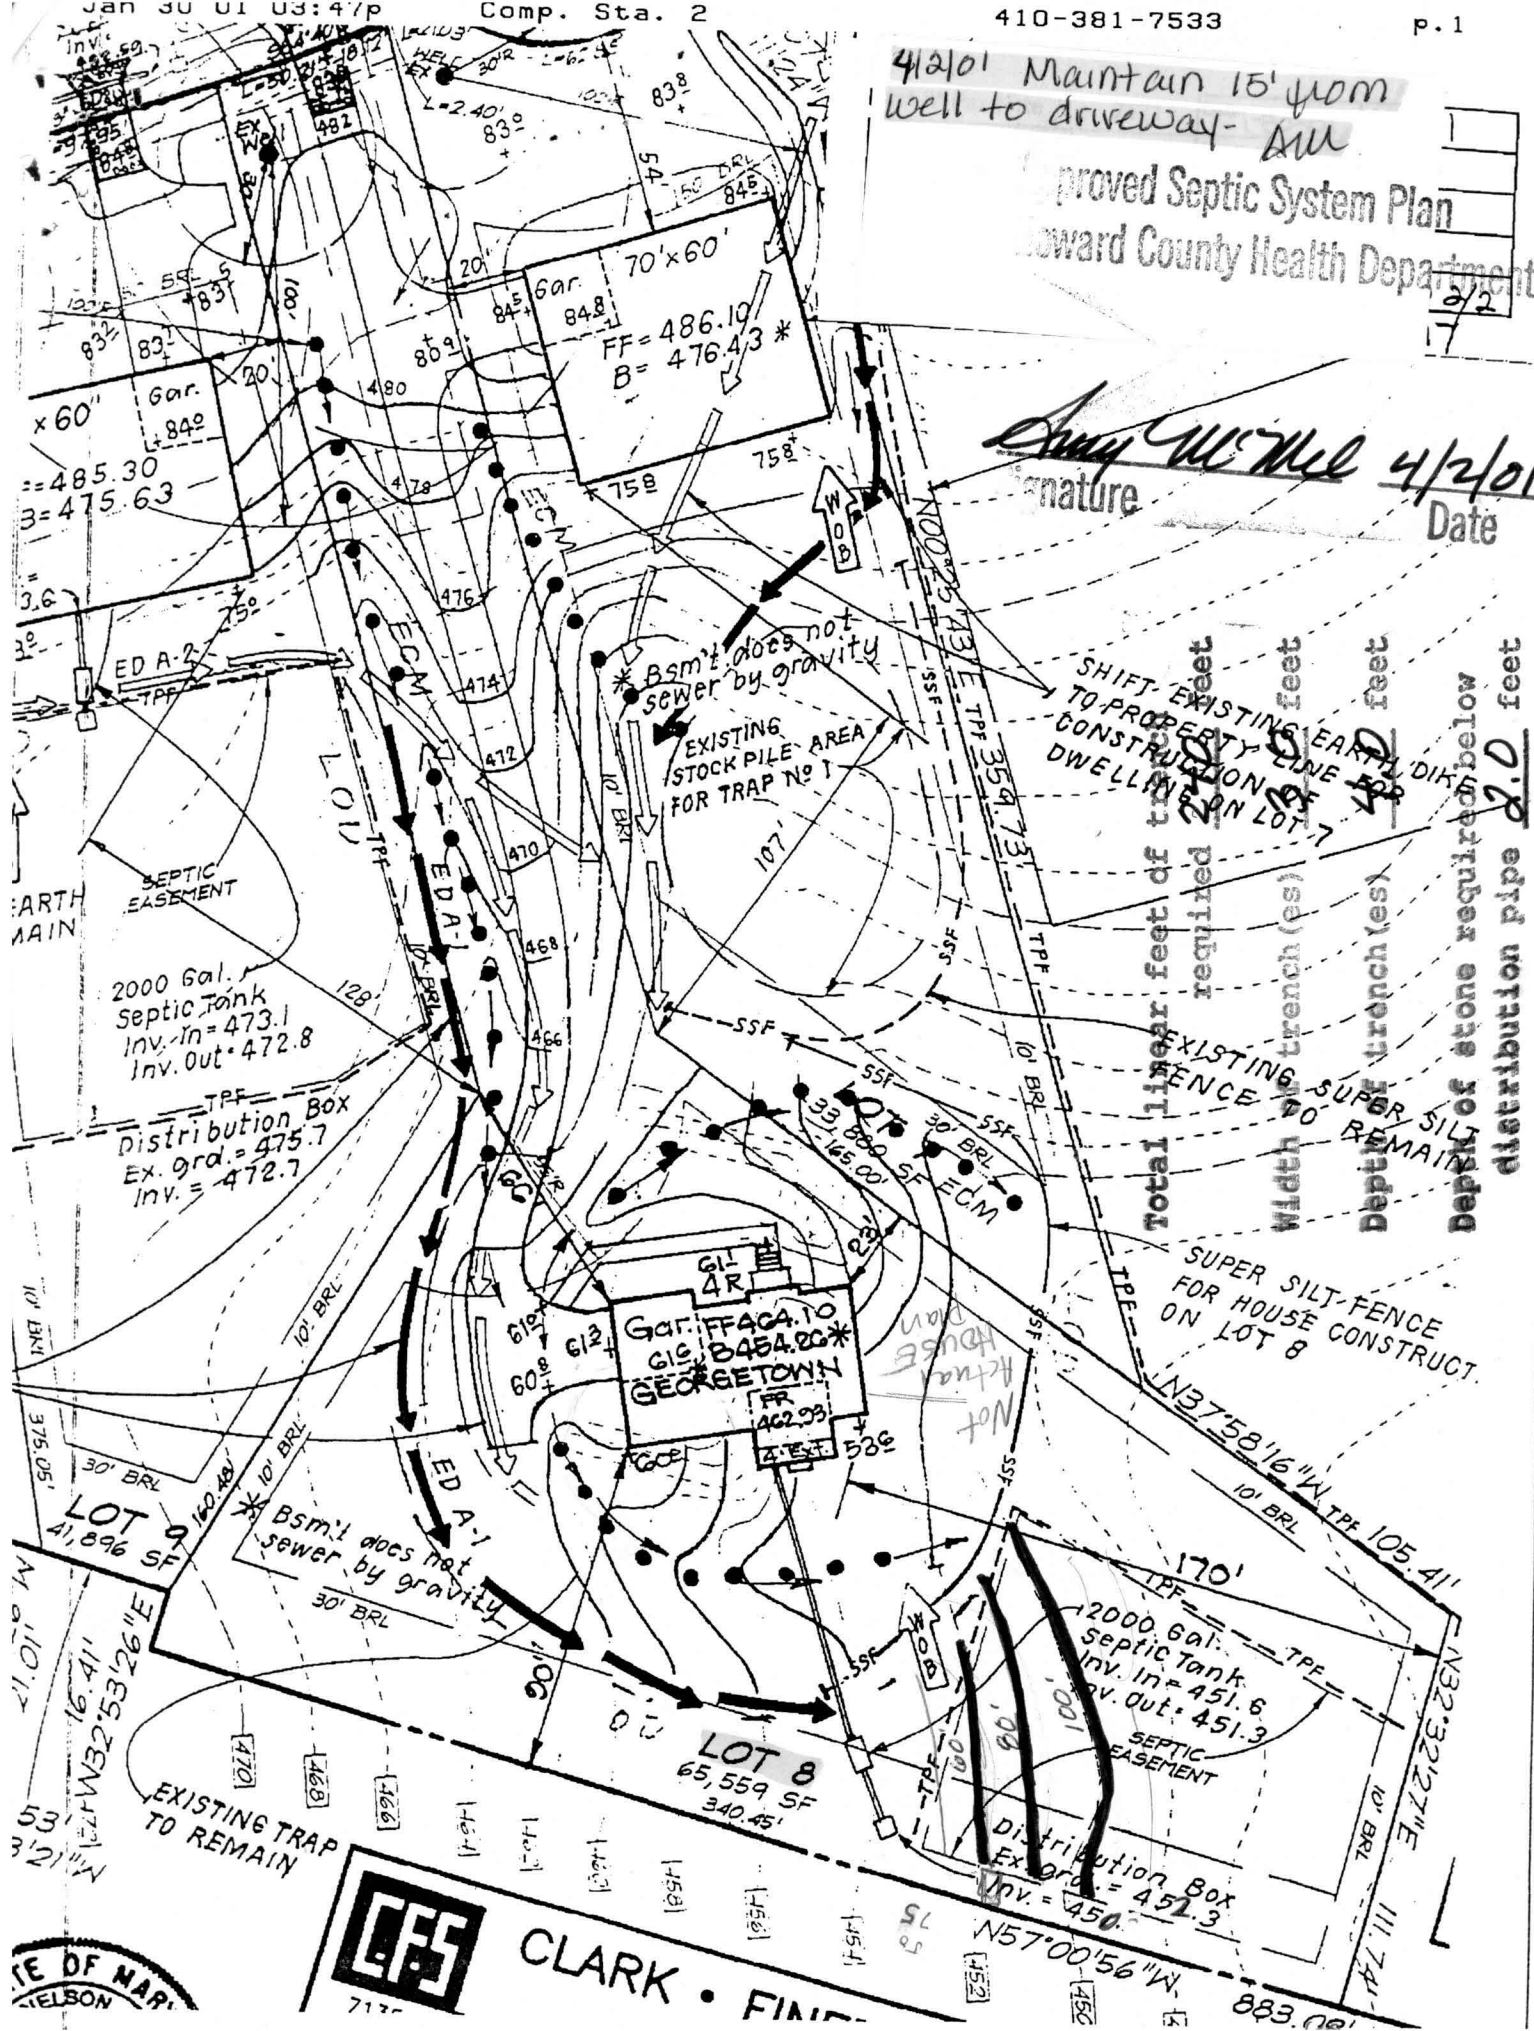

CLARK • FIN...