

LAYOUT _____ INSP 4 _____
INSP 2 _____ INSP 5 _____
INSP 3 _____ INSP 6 _____

ISSUE DATE: 6/27/74
APPROVAL DATE: 6/28/74

P 20267
A 514943

PERMIT

TAX ID #04-325680

ON-SITE SEWAGE DISPOSAL SYSTEM HOWARD COUNTY HEALTH DEPARTMENT BUREAU OF ENVIRONMENTAL HEALTH

Herman Sirk IS PERMITTED TO INSTALL ALTER

ADDRESS: _____ PHONE NUMBER: _____

SUBDIVISION: Lisbon Meadows LOT NUMBER: 1

ADDRESS: 15801 Bellis Drive PROPERTY OWNER: ~~John Setz~~ William Loveless

SEPTIC TANK CAPACITY (GALLONS): _____ OUTLET BAFFLE FILTER REQUIRED

PUMP CHAMBER CAPACITY (GALLONS): _____ COMPARTMENTED TANK REQUIRED

NUMBER OF BEDROOMS: _____

SQUARE FEET PER BEDROOM: _____

LINEAR FEET OF TRENCH REQUIRED: _____

TRENCHES:	Trench to be _____ feet wide. Inlet _____ feet below original grade. Bottom maximum depth _____ feet below original grade. Effective area begins at _____ feet below original grade. _____ feet of stone below distribution pipe.
LOCATION:	
NOTES:	

PLANS APPROVED: _____ DATE: _____

- NOTE: PERMIT VOID AFTER 2 YEARS
- NOTE: CONTRACTOR RESPONSIBLE FOR SCHEDULING A PRE-CONSTRUCTION INSPECTION FOR ALL INSTALLATIONS
- NOTE: WATERTIGHT SEPTIC TANKS REQUIRED
- NOTE: ALL PARTS OF SEPTIC SYSTEM SHALL BE 100 FEET FROM ANY WATER WELL
- NOTE: MANHOLE RISERS REQUIRED ON ALL SEPTIC TANKS AND PUMP CHAMBERS UNLESS SPECIFICALLY AUTHORIZED

NEITHER THE HOWARD COUNTY COUNCIL NOR THE HEALTH DEPARTMENT IS RESPONSIBLE FOR THE SUCCESSFUL OPERATION OF ANY SYSTEM PERMITTEE RESPONSIBLE FOR OBTAINING FINAL APPROVAL ON THIS PERMIT CALL 410-313-2640 FOR INSPECTION OF SEPTIC SYSTEM

4514742

6/28/74

off-6-28-74

PERMIT

SEWAGE DISPOSAL SYSTEM

MARYLAND STATE DEPARTMENT OF HEALTH

HOWARD COUNTY

ELLICOTT CITY

DISTRICT 4

DATE 6/27/74

INDEXED

P 20267
A 14943

Herman Sirk IS PERMITTED TO INSTALL ALTER

ADDRESS Jennings Chapel Road, Woodbine, Md. PHONE 489-4724

A SEWAGE DISPOSAL SYSTEM LOCATED AT _____

SUBDIVISION Lisbon Meadows ROAD 15801 Bellis Drive off Daisy Rd. LOT 1

PROPERTY OWNER A. Cecil Poole John W. Seitz William Loveless

ADDRESS _____

SPECIFICATIONS - 3 bedrooms

DRAIN FIELD _____ DEPTH _____ FEET, BOTTOM AREA _____ SQ. FT.

SEEPAGE PITS _____ ABSORBENT SIDE-WALL AREA _____ SQ. FT.

SEPTIC TANK CAPACITY 1,000 GALLONS

FOR GARBAGE GRINDER, INCREASE DISPOSAL AREA 22% & TANK CAPACITY 50%.

OTHER Dry well to be 100 sq. ft. of absorbent sidewall area per bedroom, below the first

6 ft. of non-absorbent ground. Max. depth of dry well to be 12 1/2 ft. below original

grade. Place dry well 52 ft. from rear lot line and 75 ft. from left side line as

seen when facing lot from Daisy Road. Septic tank cleanout must be manhole type to

grade level.

NOTE: ALL PIPE FROM HOUSE TO DRY WELL MUST BE CAST IRON.

PERMIT VOID AFTER THREE YEARS.

PLANS APPROVED BY James T. Wright DATE 4/21/71


NOTE: INSTALL STAND PIPE ON SEPTIC TANK AND DRY WELL.

FILL SEPTIC TANK AND DISTRIBUTION BOX WITH WATER BEFORE CALLING FOR AN INSPECTION. COVER NO WORK UNTIL INSPECTED AND APPROVED.

NEITHER THE HOWARD COUNTY COMMISSIONERS NOR THE HEALTH DEPARTMENT IS RESPONSIBLE FOR THE SUCCESSFUL OPERATION OF ANY SYSTEM.

BLDG. PERMIT SIGNED
AND RETURNED 4/22/72
Serial # 42296 -
addition

14943

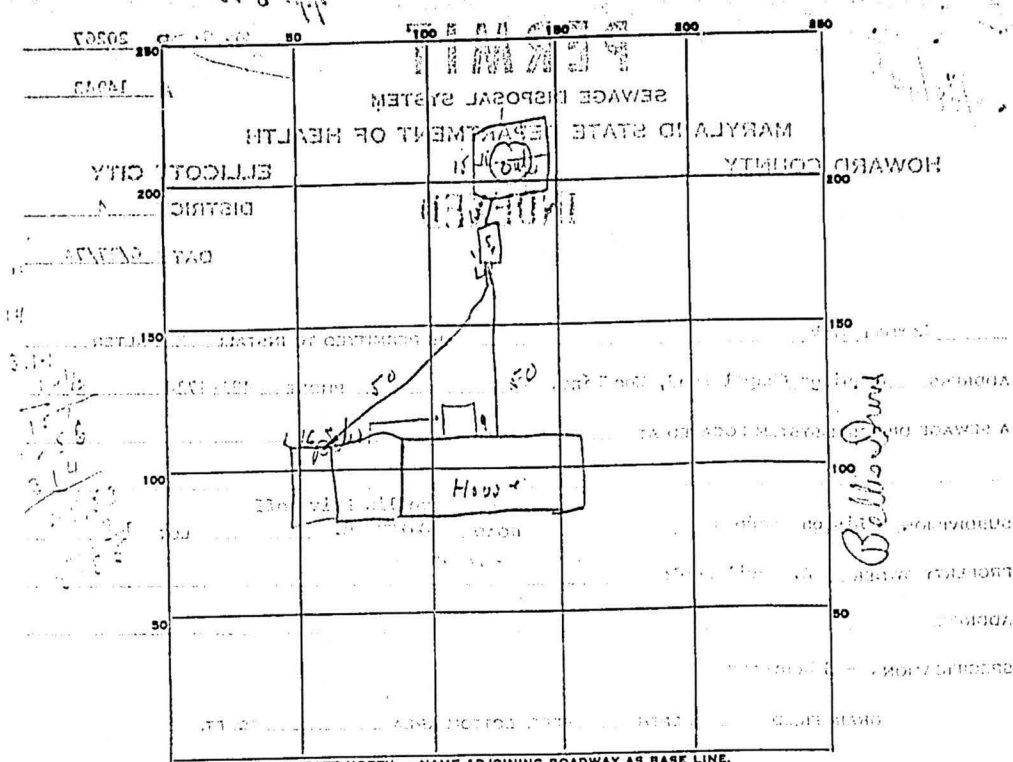

INDICATE NORTH - NAME ADJOINING ROADWAY AS BASE LINE.
 DAVIS CROSS

PERMIT CARD 62

SEPTIC TANK, LEVEL 12.0 CLEANOUTS 16.0

DISTRIBUTION BOX, LEVEL 10.0

TILE FIELD, DEPTH 18 FT. TRENCH WIDTH 18 FT.

GRAVEL DEPTH 18 IN. TOTAL LENGTH 18 FT.

NUMBER OF TRENCHES 2 TOTAL BOTTOM AREA 648

SEEPAGE PITS, INSIDE-DIAMETER 4 1/2 FT. DEPTH BELOW INLET 7 FT.

ABSORBENT AREA 608 1/8 SQ. FT.

REMARKS

UNTIL RIGHTED AND APPROVED

NEITHER THE HOWARD COUNTY DEPARTMENT OF HEALTH NOR THE DEPARTMENT OF HEALTH IS RESPONSIBLE FOR THE

DATE SYSTEM APPROVED 1/28/74 INSPECTOR W. M. Morgan