

PUB. SEWER STATUS VERIFIED BY _____

ISSUE DATE: 3/21/73

P 18108

APPROVAL DATE: _____

A 514945

PERMIT
INDEXED

TAX ID# 04-308948

ON-SITE SEWAGE DISPOSAL SYSTEM
HOWARD COUNTY HEALTH DEPARTMENT
BUREAU OF ENVIRONMENTAL HEALTH

_____ IS PERMITTED TO INSTALL ALTER

ADDRESS: _____ PHONE NUMBER: _____

SUBDIVISION: Lisbon Meadows LOT NUMBER: 3

ADDRESS: 15809 Bellis Drive PROPERTY OWNER: R LANTZ PRIEST

SEPTIC TANK CAPACITY (GALLONS): _____

PUMP CHAMBER CAPACITY (GALLONS): _____

NUMBER OF BEDROOMS: _____

SQUARE FEET PER BEDROOM: _____

LINEAR FEET OF TRENCH REQUIRED: _____

TRENCHES:	Trench to be _____ feet wide. Inlet _____ feet below original grade. Bottom maximum depth _____ feet below original grade. Effective area begins at _____ feet below original grade. _____ feet of stone below distribution pipe.
LOCATION:	
PURPOSE:	Existing septic system has failed. Call for inspection when ground is opened so sanitarian can recommend repair.

PLANS APPROVED: _____ DATE: _____

- NOTE: PERMIT VOID AFTER 2 YEARS
- NOTE: CONTRACTOR RESPONSIBLE FOR SCHEDULING A PRE-CONSTRUCTION INSPECTION FOR ALL INSTALLATIONS
- NOTE: WATERTIGHT SEPTIC TANKS REQUIRED
- NOTE: ALL PARTS OF SEPTIC SYSTEM SHALL BE 100 FEET FROM ANY WATER WELL
- NOTE: MANHOLE RISERS REQUIRED ON ALL SEPTIC TANKS AND PUMP CHAMBERS

NEITHER THE HOWARD COUNTY COUNCIL OR THE HEALTH DEPARTMENT IS RESPONSIBLE FOR THE SUCCESSFUL OPERATION OF ANY SYSTEM PERMITTEE RESPONSIBLE FOR OBTAINING FINAL APPROVAL ON THIS PERMIT CALL 410-313-2640 FOR INSPECTION OF SEPTIC SYSTEM

A514945

4/30/73

PERMIT

04-70-77 P 18108
A 14945

SEWAGE DISPOSAL SYSTEM

MARYLAND STATE DEPARTMENT OF HEALTH

HOWARD COUNTY

ELLICOTT CITY

DISTRICT 4

DATE 3/21/73

04-308948
INDEXED

William Hopkins IS PERMITTED TO INSTALL ALTER

ADDRESS Jennings Chapel Road, Woodbine, Md. PHONE 489-4711

A SEWAGE DISPOSAL SYSTEM LOCATED AT _____

SUBDIVISION Lisbon Meadows ROAD 15809 Bellis Drive LOT 3
Bellis Drive

PROPERTY OWNER Universal Builders Mr. + Mrs. Priest

ADDRESS _____

SPECIFICATIONS - 3 bedrooms

DRAIN FIELD _____ DEPTH _____ FEET, BOTTOM AREA _____ SQ. FT.

SEEPAGE PITS _____ ABSORBENT SIDE-WALL AREA _____ SQ. FT.

SEPTIC TANK CAPACITY 1,000 GALLONS

FOR GARBAGE GRINDER, INCREASE DISPOSAL AREA 22% & TANK CAPACITY 50%.

OTHER Dry well - 300 sq. ft. absorbent sidewall area to begin below the first 4 ft. of

original grade. Max. depth/dry well is to be 12-ft. below original grade. Come off dry well
with 5 ft. of solid pipe begin trench. Trench to be 15 ft. long - 11 ft. deep with 7 ft.
of gravel under pipe. Call for inspection of trench before gravel is installed.

Put dry well 125 ft. from front line and 110 ft. from left side as seen when facing from
Bellis Drive. Run trench toward left side line.

NOTE: ALL PIPE FROM HOUSE TO SEPTIC TANK MUST BE CAST IRON.
PERMIT VOID AFTER THREE YEARS.

NOTE: INSTALL STAND PIPE ON SEPTIC TANK AND DRY WELL.

PLANS APPROVED BY Donald W. Monaghan DATE 3/21/73


FILL SEPTIC TANK AND DISTRIBUTION BOX WITH WATER BEFORE CALLING FOR AN INSPECTION. COVER NO WORK UNTIL INSPECTED AND APPROVED.

NEITHER THE HOWARD COUNTY COMMISSIONERS NOR THE HEALTH DEPARTMENT IS RESPONSIBLE FOR THE SUCCESSFUL OPERATION OF ANY SYSTEM.

BLDG. PERMIT SIGNED
AND RETURNED 4/10/73
Serial # 49214
unread

INSPECTOR _____ DATE SYSTEM APPROVED _____

1155
-575-

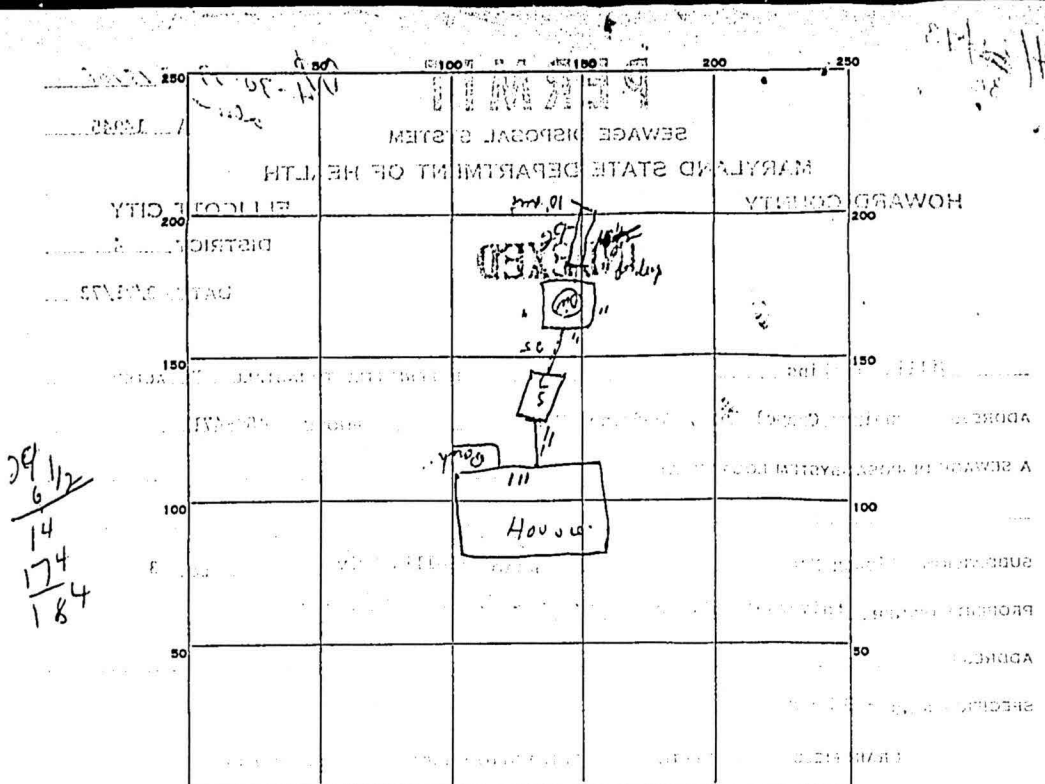

INDICATE NORTH. - NAME ADJOINING ROADWAY AS BASE LINE.

Ballis

PERMIT CARD OK
 SEPTIC TANK, LEVEL OK CLEANOUTS OK
 DISTRIBUTION BOX, LEVEL OK

II. TILE FIELD, DEPTH 10 FT. TRENCH WIDTH 3 1/2 FT.
 GRAVEL DEPTH 78 IN. TOTAL LENGTH 29 FT.
 NUMBER OF TRENCHES 1 TOTAL BOTTOM AREA 38.4 SQ. FT.
 SEEPAGE PITS, INSIDE DIAMETER 44 FT. DEPTH BELOW INLET 7 FT.
 ABSORBENT AREA 308 SQ. FT. $+ 1841 \text{ sq ft trench} = 4.92 + 99 \%$

REMARKS: permit calls for trench to be 15' long + by in 5' from dry well - trench only 18' long from edge of dry well - trench not deep enough to get 7' of gravel as per permit section number 10.
 2 replace plastic pipe in line from tank to dry well - measure first joint
 3 materials in and as per set dry well in the yard as per plan

DATE SYSTEM APPROVED 4/30/73 INSPECTOR Durmaney