


COUNTY #

SOIL PROFILE

0' 43
 DL Brown Loam
 2'
 Brown Silom
 3/2'
 Yellow Clay loam
 6'
 Red Silom
 Silom
 1590 Rock
 13 1/2'

44a
 DL Brown Loam
 2 1/2'
 Yellow Brown Sil Clay Loam
 5'
 Red Silom
 Silom
 1590
 Rock
 14'

45'
 Brown Loam
 1'
 Yellow Clay Loam
 4'
 Red Silom
 Silom
 1590
 Rock
 14'

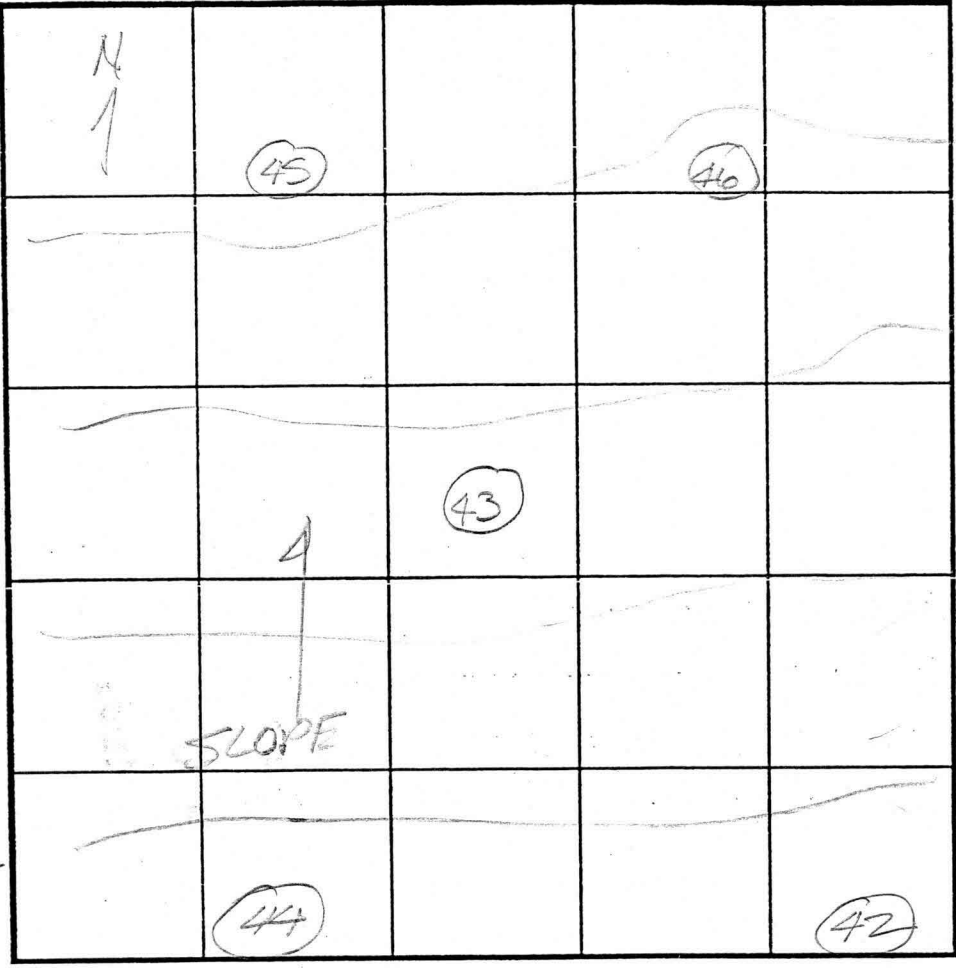

SOIL PROFILE

0' 42
 DL Brown Loam
 1'
 Yellow Brown Clay loam
 2 1/2'
 Yellow Red Silom
 1590 Rock
 13'
 44
 DL Brown Loam
 1'
 Yellow Brown Clay loam
 2 1/2'
 Grayish Sil Loam
 3'
 Red Silom
 Silom
 14'

INDICATE NORTH - NAME ADJOINING ROADWAY AS BASE LINE.

DATE	TEST NO.	DEPTH	PRE-WET		TEST - 1" DROP		TIME
			START	STOP	START	STOP	
7/11/03	43	6' / 13 1/2'	1:20	1:24	1:24	1:30	6min
	45	6 1/2' / 14'	1:36	1:48	1:48	2:01	13min
	46	6' / 13 1/2'	1:48	1:53	1:53	1:58	5min
	44	6' / 14'	12:41	12:54	12:54	1:09	15min
	42	6 1/2' / 13'	1:09	1:14	1:14	1:18	4min

REMARKS _____
 TYPE OF SOIL _____
 TESTED BY FA ALSO PRESENT Bob Siersky
M. K. Johnson
 TRENCH DESIGN DATA: AVERAGE PERCOLATION TIME _____ TRENCH WIDTH _____
 INLET DEPTH _____ MAXIMUM BOTTOM DEPTH _____ SQ. FT./BEDROOM _____

