

7/24/01
1:00
Layout
7/30/01
PM

7/31/01
Late PM
C.O.
8/1/01
Co. Follow up PH

8/17/01 - 2:00 Pump Test
PERMIT
INDEXED
8/2/01 -
follow up on
8/6/01
to find
anytime

25-431891

P 515325-A

A 56564-C

SEWAGE DISPOSAL SYSTEM
HOWARD COUNTY HEALTH DEPARTMENT
BUREAU OF ENVIRONMENTAL HEALTH
410-313-2640

ISSUE DATE 7/9/2001

APPROVAL DATE 8-17-01

Fogles Septic Clean, Inc IS PERMITTED TO INSTALL X ALTER

ADDRESS 580 Obrecht Road, Sykesville, MD 21784 PHONE 410-795-5670

SUBDIVISION Big Branch Overlook LOT NUMBER 3 ADDRESS 14013 Big Branch Drive

PROPERTY OWNER Big Branch Overlook LLC PROPERTY OWNER'S ADDRESS 7164 Columbia Gateway Dr #230, Columbia, MD 21046

SEPTIC TANK CAPACITY 1500 GALLONS *** ***TOP SEAMED, COMPARTMENTED SEPTIC TANK REQUIRED***

PUMP CHAMBER CAPACITY 1500 GALLONS ****TOP SEAMED (NOT COMPARTMENTED) PUMP CHAMBER REQUIRED****

NUMBER OF BEDROOMS 4 **** COMPARTMENTED TANK REQUIRED WITH MANHOLE ACCESS**

SQUARE FEET PER BEDROOM 210 **AND OUTLET BAFFLE FILTER ****

LINEAR FEET OF TRENCH REQUIRED 280

TRENCHES: Trenches to be 3 feet wide. Inlet 3 feet below original grade. Bottom maximum depth 5 feet below original grade. 2 feet of stone below distribution ~~man~~ pipe.

LOCATION: Begin trenches 165 feet up the right lot line and 10 feet off that same lot line as seen when facing the lot from Big Branch Drive. Run trenches on contour ~~to~~ toward the left lot line. 2/1/01 OK BB

80', 100', 100' AS DISCUSSED W/INSTALLER 8/2 MR/RG

*** Septic tank specifications apply to all lots in subdivision as agreed by builder. ***
PLANS APPROVED Amy McMillen DATE 1/31/2001

PERMIT VOID AFTER 2 YEARS

NOTE: CONTRACTOR RESPONSIBLE FOR SCHEDULING A PRE-CONSTRUCTION INSPECTION FOR ALL INSTALLATIONS

NOTE: TOP OF SEPTIC TANKS ARE TO BE NO DEEPER THAN 3.0 FEET BELOW FINISH GRADE

NOTE: WATERTIGHT SEPTIC TANKS REQUIRED

NOTE: CLEANOUT REQUIRED EVERY 70 FEET OF SEWER LINE AND/OR AT 90° SWEEPS IN LINES FROM HOUSE TO DRAIN FIELDS, 90° ELBOWS ARE NOT ACCEPTABLE

NOTE: ALL PARTS OF SEPTIC SYSTEMS (I.E. TANK, DISTRIBUTION BOX, DRAINFIELDS) TO BE 100 FEET FROM ANY WATER BODIES UNLESS OTHERWISE SPECIFICALLY AUTHORIZED

BUILDING PERMITS SIGNED AND RETURNED

NOTE: NO ABSORPTION TRENCH TO EXCEED 100 FEET IN LENGTH UNLESS SPECIFICALLY AUTHORIZED

NOTE: ALL PIPE FROM HOUSE TO SEPTIC TANK MUST BE CAST IRON OR SCHEDULE 35/40 PVC OR ABS

1/22/03 800140059 DECK
10/30/03 800144852-IG POOL

NOTE: MANHOLE RISERS REQUIRED ON ALL SEPTIC TANKS AND PUMP CHAMBERS

NOTE: DISTRIBUTION BOXES MUST HAVE BAFFLES

NOTE: IF PUMPED SEPTIC SYSTEM REQUIRED, (1) SEPTIC PUMP DETAIL TO BE PROVIDED BY INSTALLER PRIOR TO ISSUANCE OF SEPTIC PERMIT (2) PUMP PERFORMANCE TEST IS NECESSARY PRIOR TO HEALTH DEPARTMENT APPROVAL OF SEPTIC PERMIT


NEITHER THE HOWARD COUNTY COUNCIL NOR THE HEALTH DEPARTMENT IS RESPONSIBLE FOR THE SUCCESSFUL OPERATION OF ANY SYSTEM
PERMITTEE RESPONSIBLE FOR OBTAINING FINAL APPROVAL ON THIS PERMIT
CALL 410-313-2640 FOR INSPECTION OF SEPTIC SYSTEM

515325-A

NOT TO SCALE

HO-94-2659

INDEXED

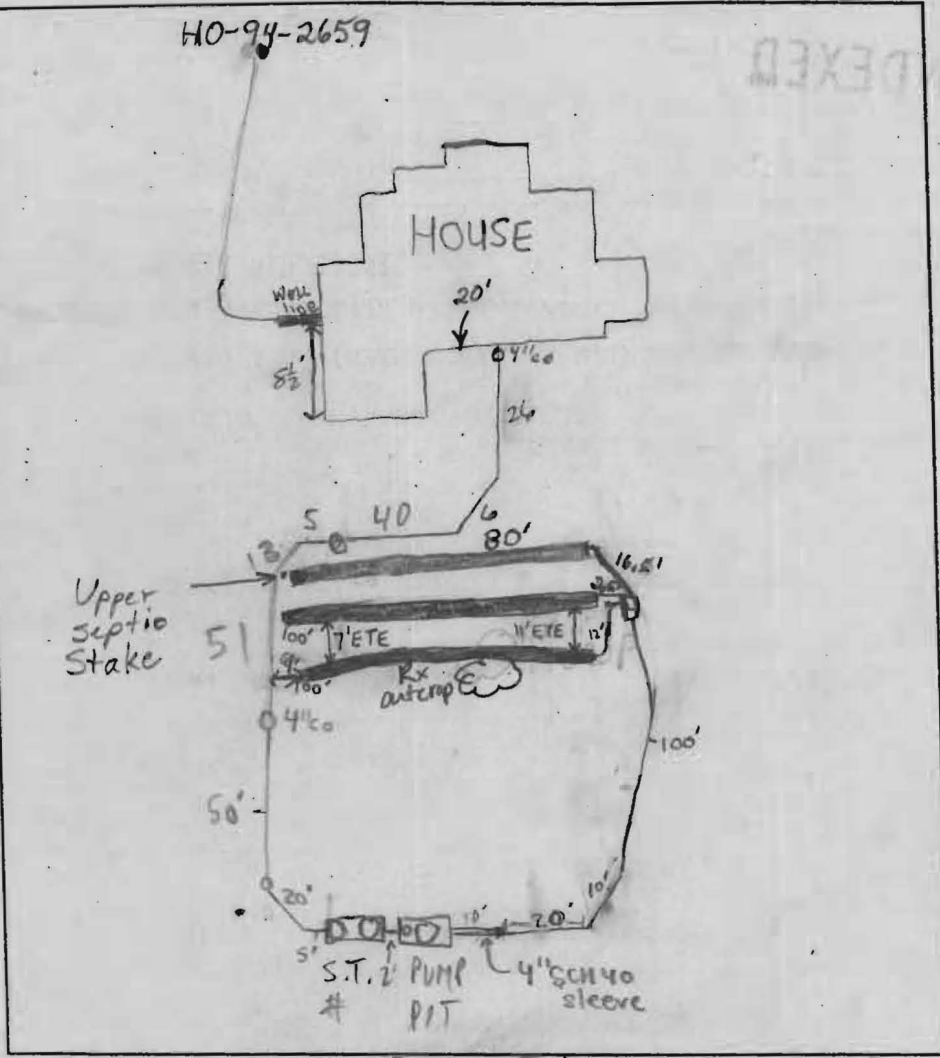

TRENCH DATA	
TRENCH WIDTH	3'
TRENCH INLET DEPTH	3'
TRENCH BOTTOM DEPTH	5'
DEPTH OF STONE	2'
NUMBER OF TRENCHES	3
TOTAL TRENCH LENGTH	280'
ABSORBENT AREA	840 sq. ft.
DISTRIBUTION BOX LEVEL	Yes
BAFFLE IN DISTRIBUTION BOX	Yes

SEPTIC TANK DATA ^{2 compartment}	
SEPTIC TANK	1500TS GALLONS
MANHOLE RISER	on front on rear
6 INCH INSPECTION PORT	No
PUMP CHAMBER DATA	
PUMP CHAMBER GALLONS	1500 T.S. ^{NOT COMPARTMENTED}
MANHOLE RISER	on center
ALARM	
PUMP PERFORMANCE TEST	

Big Branch Drive

PRE-CONSTRUCTION INSPECTION: 7/27/01 Pre Const. layout - OK to proceed ALL

INSPECTION COMMENTS: 7/30/01 No significant work done. BB 7/31/01 S.T. #1 SET, Rx @ SITE #2 LG. Rx OUTCROP IN MIDDLE OF SRA CONTINUE MR

8/1/01 - SECOND SEPTIC TANK SET, OK TO CONTINUE, CALL DURING TRENCH INSTALLATION TO "WORK" AROUND ROCK IF ENCOUNTERED (SRK) 8/2/01 Rx OUTCROP NOT A PROBLEM, OK TO START TRENCHES, 10' HIGHER THAN RIGHT REAR SEPTIC STAKE MR/KG

8/3/01 - OK TO COVER & CONTINUE WORK, TOP TRENCH REMAINS TO BE INSTALLED

(SRK/KG) 8/6/01 O.K. to cover everything. Need pump and alarm test. BB

8-17-01 SEWER PUMP TEST, OK (KG)

INSPECTOR Hoedley DATE SYSTEM APPROVED 8-17-01