

B00143823

8/27/03

JB

Dock loc.
O.K. No
impact of
split level



PUBLIC STORM WATER
MANAGEMENT, ACCESS,
DRAINAGE & UTILITY
EASEMENT

LOT 46

LOT 45

LOT 44

LOT 43

SEE
DETAIL

15' PUBLIC DRAINAGE
& UTILITY EASEMENT

BIG BRANCH DRIVE
50' R/W


2-STORY
DWELLING

SURVEYOR'S CERTIFICATE


I HEREBY CERTIFY TO THE BEST OF MY KNOWLEDGE AND BELIEF THE DWELLING(S) SHOWN ON THIS DRAWING LIES WITHIN THE LOT LINES SHOWN AS COMPILED FROM TITLE OR OTHER SOURCES. OTHER IMPROVEMENTS ARE FOR PICTORIAL PURPOSES ONLY. THIS DRAWING IS NOT A BOUNDARY SURVEY AND HAS BEEN PREPARED EXCLUSIVELY FOR TITLE PURPOSES ONLY. PREPARED WITHOUT THE BENEFIT OF A TITLE REPORT.

[Handwritten Signature]
REG. No. 10978

DETAIL
SCALE: 1"=30'

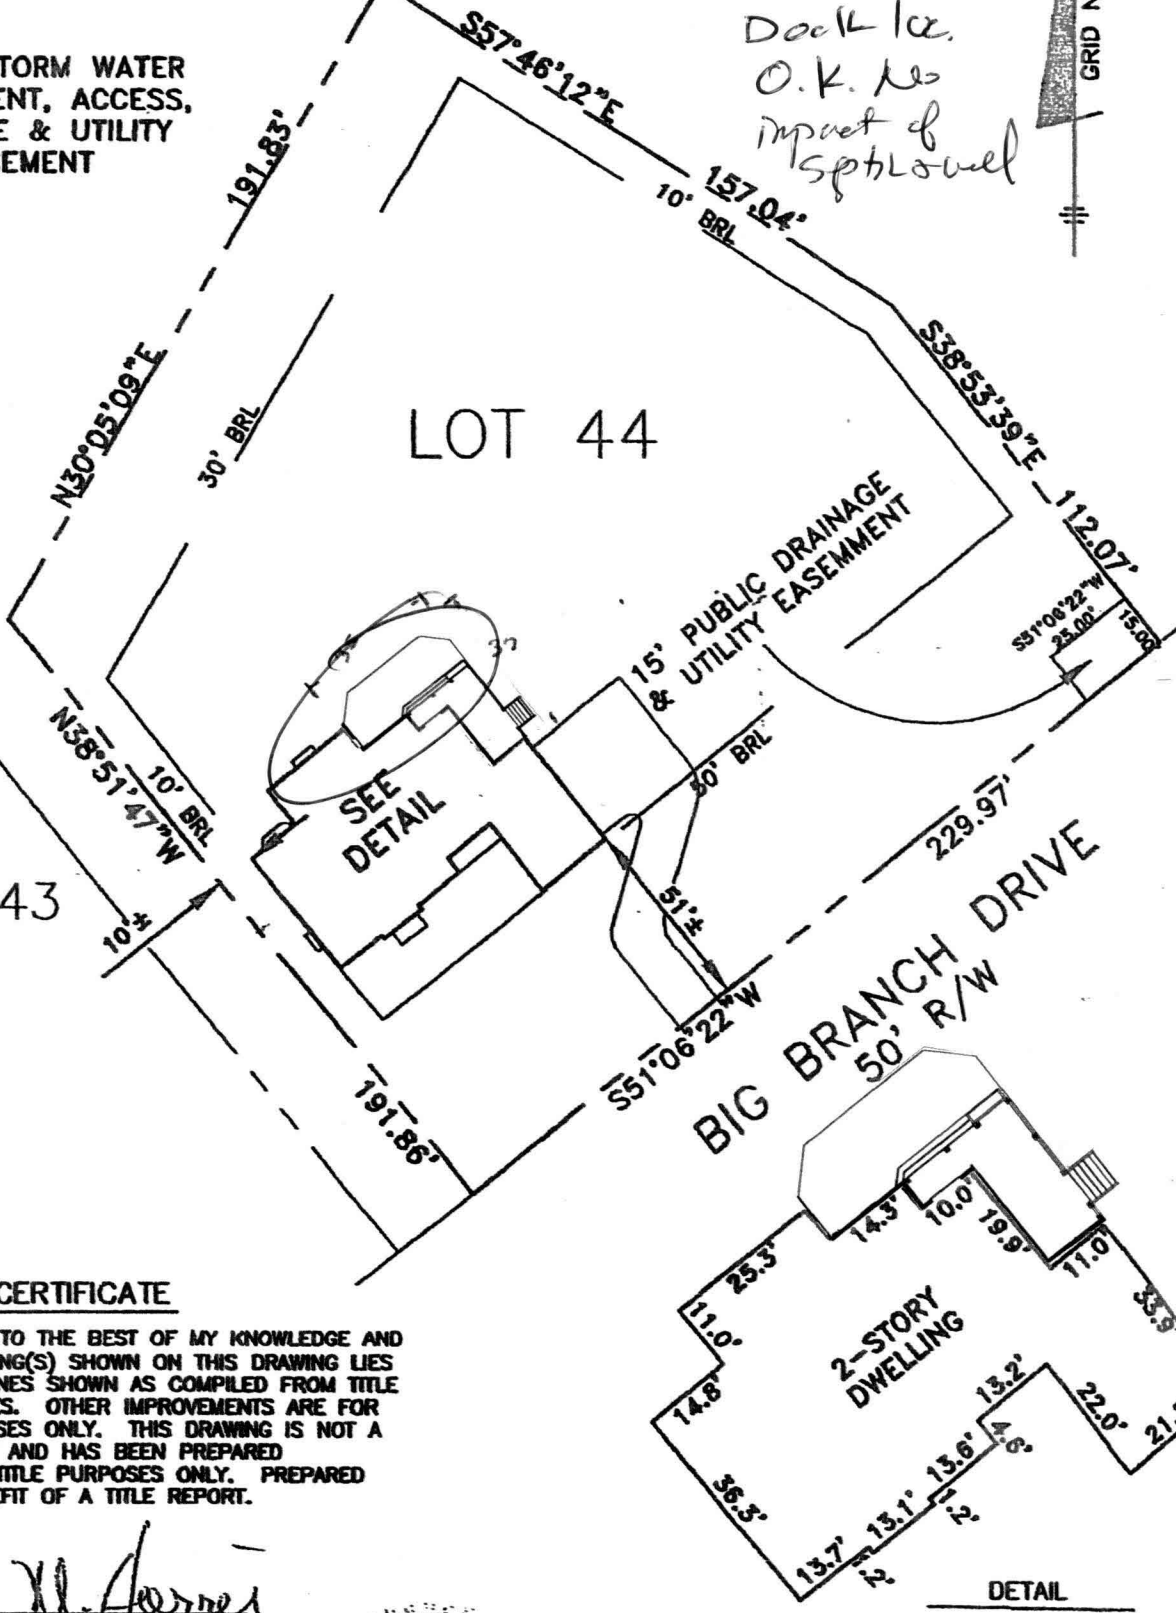

PROJECT:
BIG BRANCH OVERLOOK
LOT 44

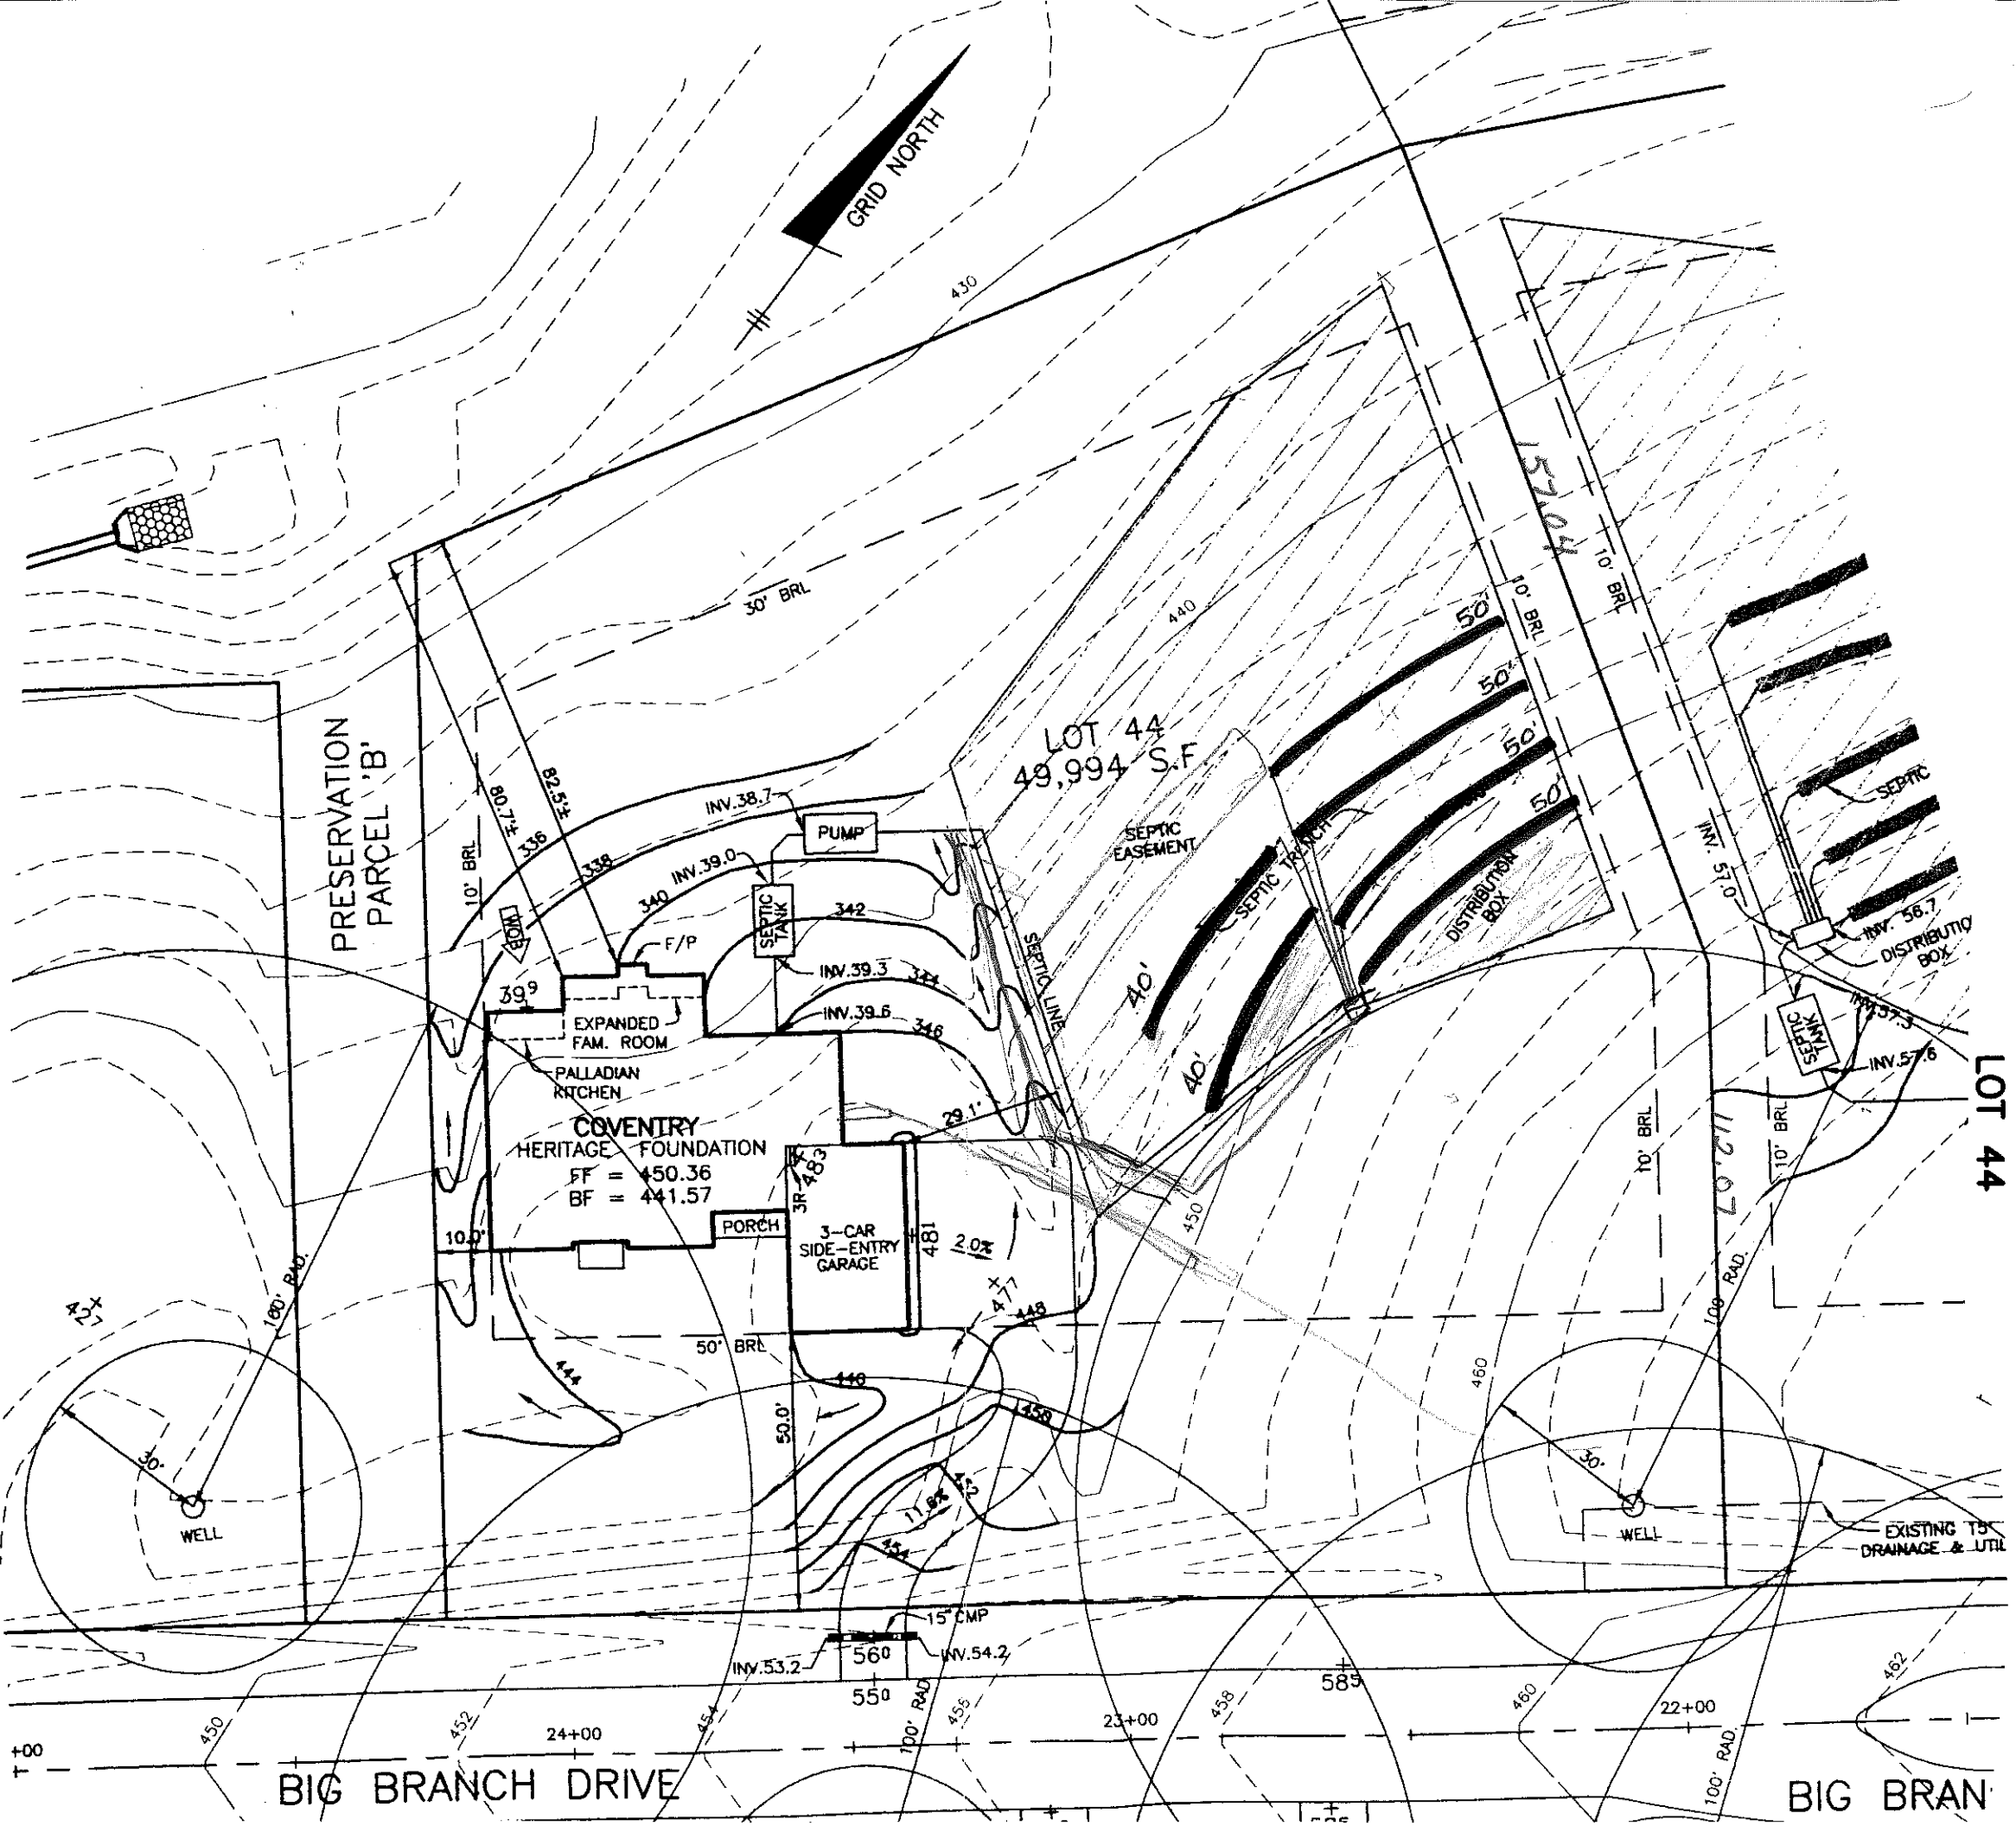

Total linear feet of trench required 280 feet

Width of trench(es) 30 feet

Depth of trench(es) 40 feet

Depth of stone required below distribution pipe 20 feet

Approved Septic System Plan
 Howard County Health Department

Signature [Signature] Date 3/26/01