

APPLICATION

PERCOLATION TESTING

A 57577

P _____

HOWARD COUNTY HEALTH DEPARTMENT
BUREAU OF ENVIRONMENTAL HEALTH
3525-H ELLICOTT MILLS DRIVE/ELLICOTT CITY, MARYLAND 21043
TELEPHONE: 313-2640

DISTRICT _____

DATE _____

TO: THE COUNTY HEALTH OFFICER
ELLICOTT CITY, MARYLAND

I HEREBY APPLY FOR THE NECESSARY TEST PRIOR TO APPLICATION FOR PERMIT TO CONSTRUCT (OR RECONSTRUCT) A SEWAGE DISPOSAL SYSTEM.

PROPERTY OWNER C.M.C. CONSTRUCTION, INC.

ADDRESS _____ PHONE _____

AGENT OR PROSPECTIVE BUYER CHARLES A. SHARP

ADDRESS 3779 SHARP ROAD PHONE 410-989-4630

PROPERTY LOCATION: Big Branch Overlook Big Branch Drive

SUBDIVISION ~~PROSPECTIVE BUYER~~ LOT NO. 72 37

ROAD AND DESCRIPTION HOWARD ROAD 3,000'± FROM INTERSECTION
TRIDELPHIA ROAD (SOUTH)

TAX MAP 27 PARCEL # 19

SIZE OF LOT 40,000 - 50,000 SQ. FT. TYPE BLDG. SINGLE FAMILY DWELLING
(SINGLE FAMILY DWELLING OR COMMERCIAL)

THE SYSTEM INSTALLED UNDER THIS APPLICATION IS ACCEPTABLE ONLY UNTIL PUBLIC FACILITIES BECOME AVAILABLE. I FULLY UNDERSTAND THE FEE CONNECTED WITH THE FILING OF THIS PERC TEST APPLICATION IS NON-REFUNDABLE UNDER ANY CIRCUMSTANCES. I ALSO AGREE TO COMPLY WITH ALL M.O.S.H.A. REQUIREMENTS IN TESTING THIS LOT.

Charles A Sharp
(SIGNATURE OF APPLICANT)

APPROVED BY _____ FOR _____ DATE _____

DISAPPROVED BY _____ FOR _____ DATE _____

HOLD PENDING FURTHER TESTS _____

REASONS FOR REJECTION OR HOLDING _____

PERCOLATION TEST PLAT/PRELIMINARY PLAT - TITLE OR I.D. # _____ DATE _____



SITE DEVELOPMENT PLAN/FINAL PLAT - TITLE OR I.D. # _____ DATE _____

THIS IS NOT A PERMIT


A 57577

COUNTY #

SOIL PROFILE

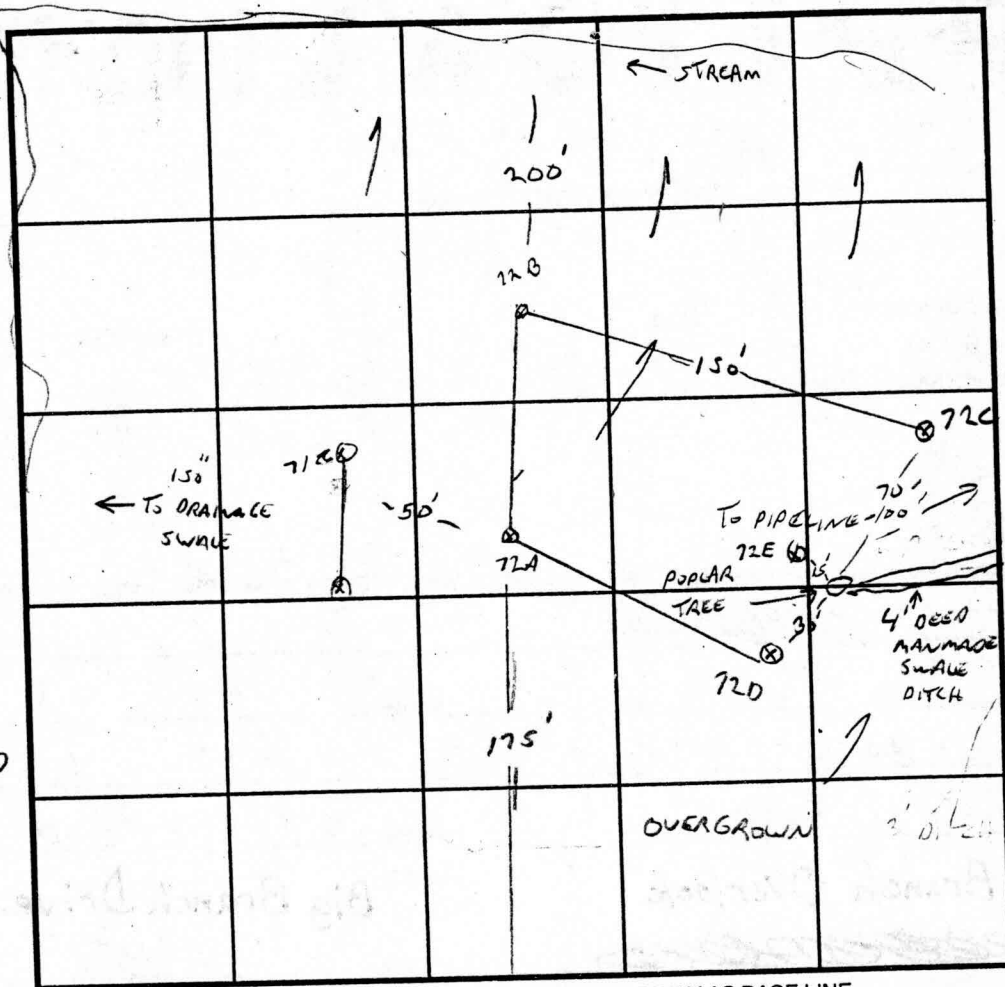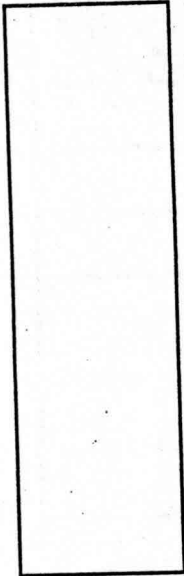

SOIL PROFILE

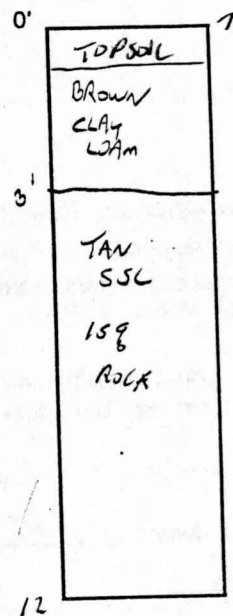

72D

INDICATE NORTH - NAME ADJOINING ROADWAY AS BASE LINE.
FARM ROAD

DATE	TEST NO.	DEPTH	PRE-WET		TEST - 1" DROP		TIME
			START	STOP	START	STOP	
11/15/96	72A	4' / 12	138	139	1:39	1:42	3 min
		8 v ok					
	72B	4' / 12 v	1:43	1:46	1:46	1:53	7 min
		8 ok v					
	72C	3' / 12 v	1:55	1:56	1:56	1:58	2 min
	72C	6'	1:55	1:56	1:56	1:58	2 min
	72D	4' / 12	2:04	2:05	2:05	2:07	2 min
	72E	11.5' u ok					

REMARKS LOT 37

TYPE OF SOIL _____

TESTED BY G. SAUSAGE

ALSO PRESENT C. SHARD

TRENCH DESIGN DATA: AVERAGE PERCOLATION TIME _____


TRENCH WIDTH _____

INLET DEPTH _____

MAXIMUM BOTTOM DEPTH _____

SQ. FT./BEDROOM _____

N →

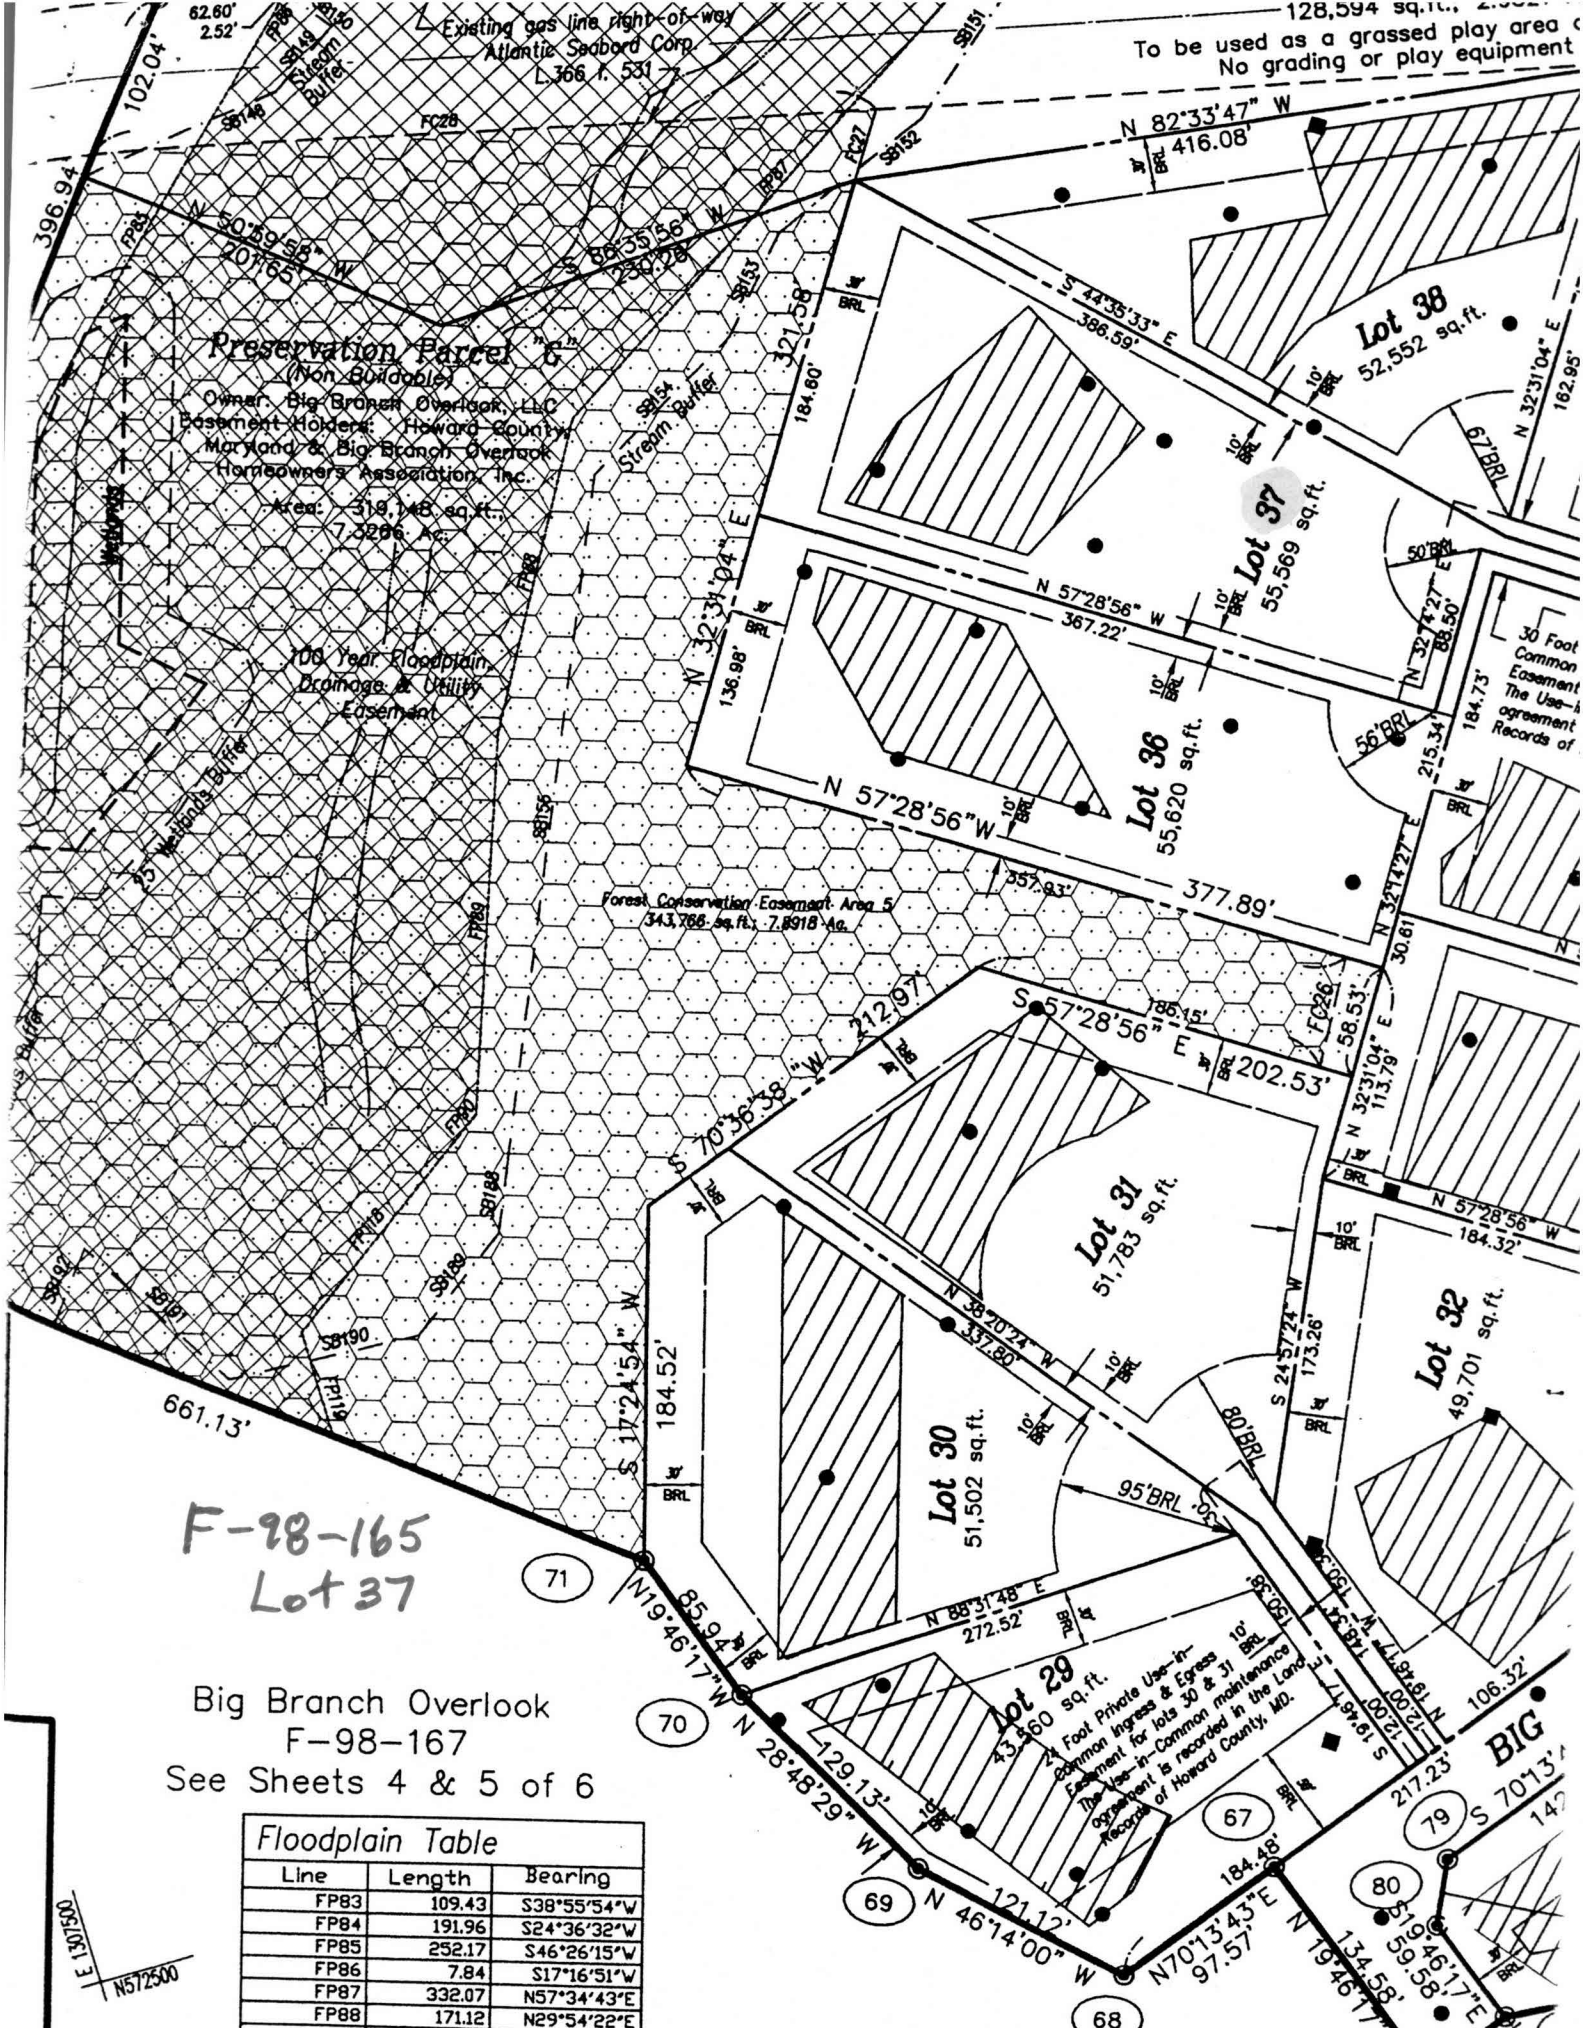

Floodplain Table

Line	Length	Bearing
FP83	109.43	S38°55'54"W
FP84	191.96	S24°36'32"W
FP85	252.17	S46°26'15"W
FP86	7.84	S17°16'51"W
FP87	332.07	N57°34'43"E
FP88	171.12	N29°54'22"E
FP89	103.77	N103°54'22"E

0005301.00
 E
 N57°25'00"

(Not Billed)
Mr. Charles A. Sharp
(F-98-165)



P-99-01
Lot 37

