


10/8/03  
proposed deck  
OK (SRK)

B00144473



TOTAL  
644#  
ON 2 LEVELS

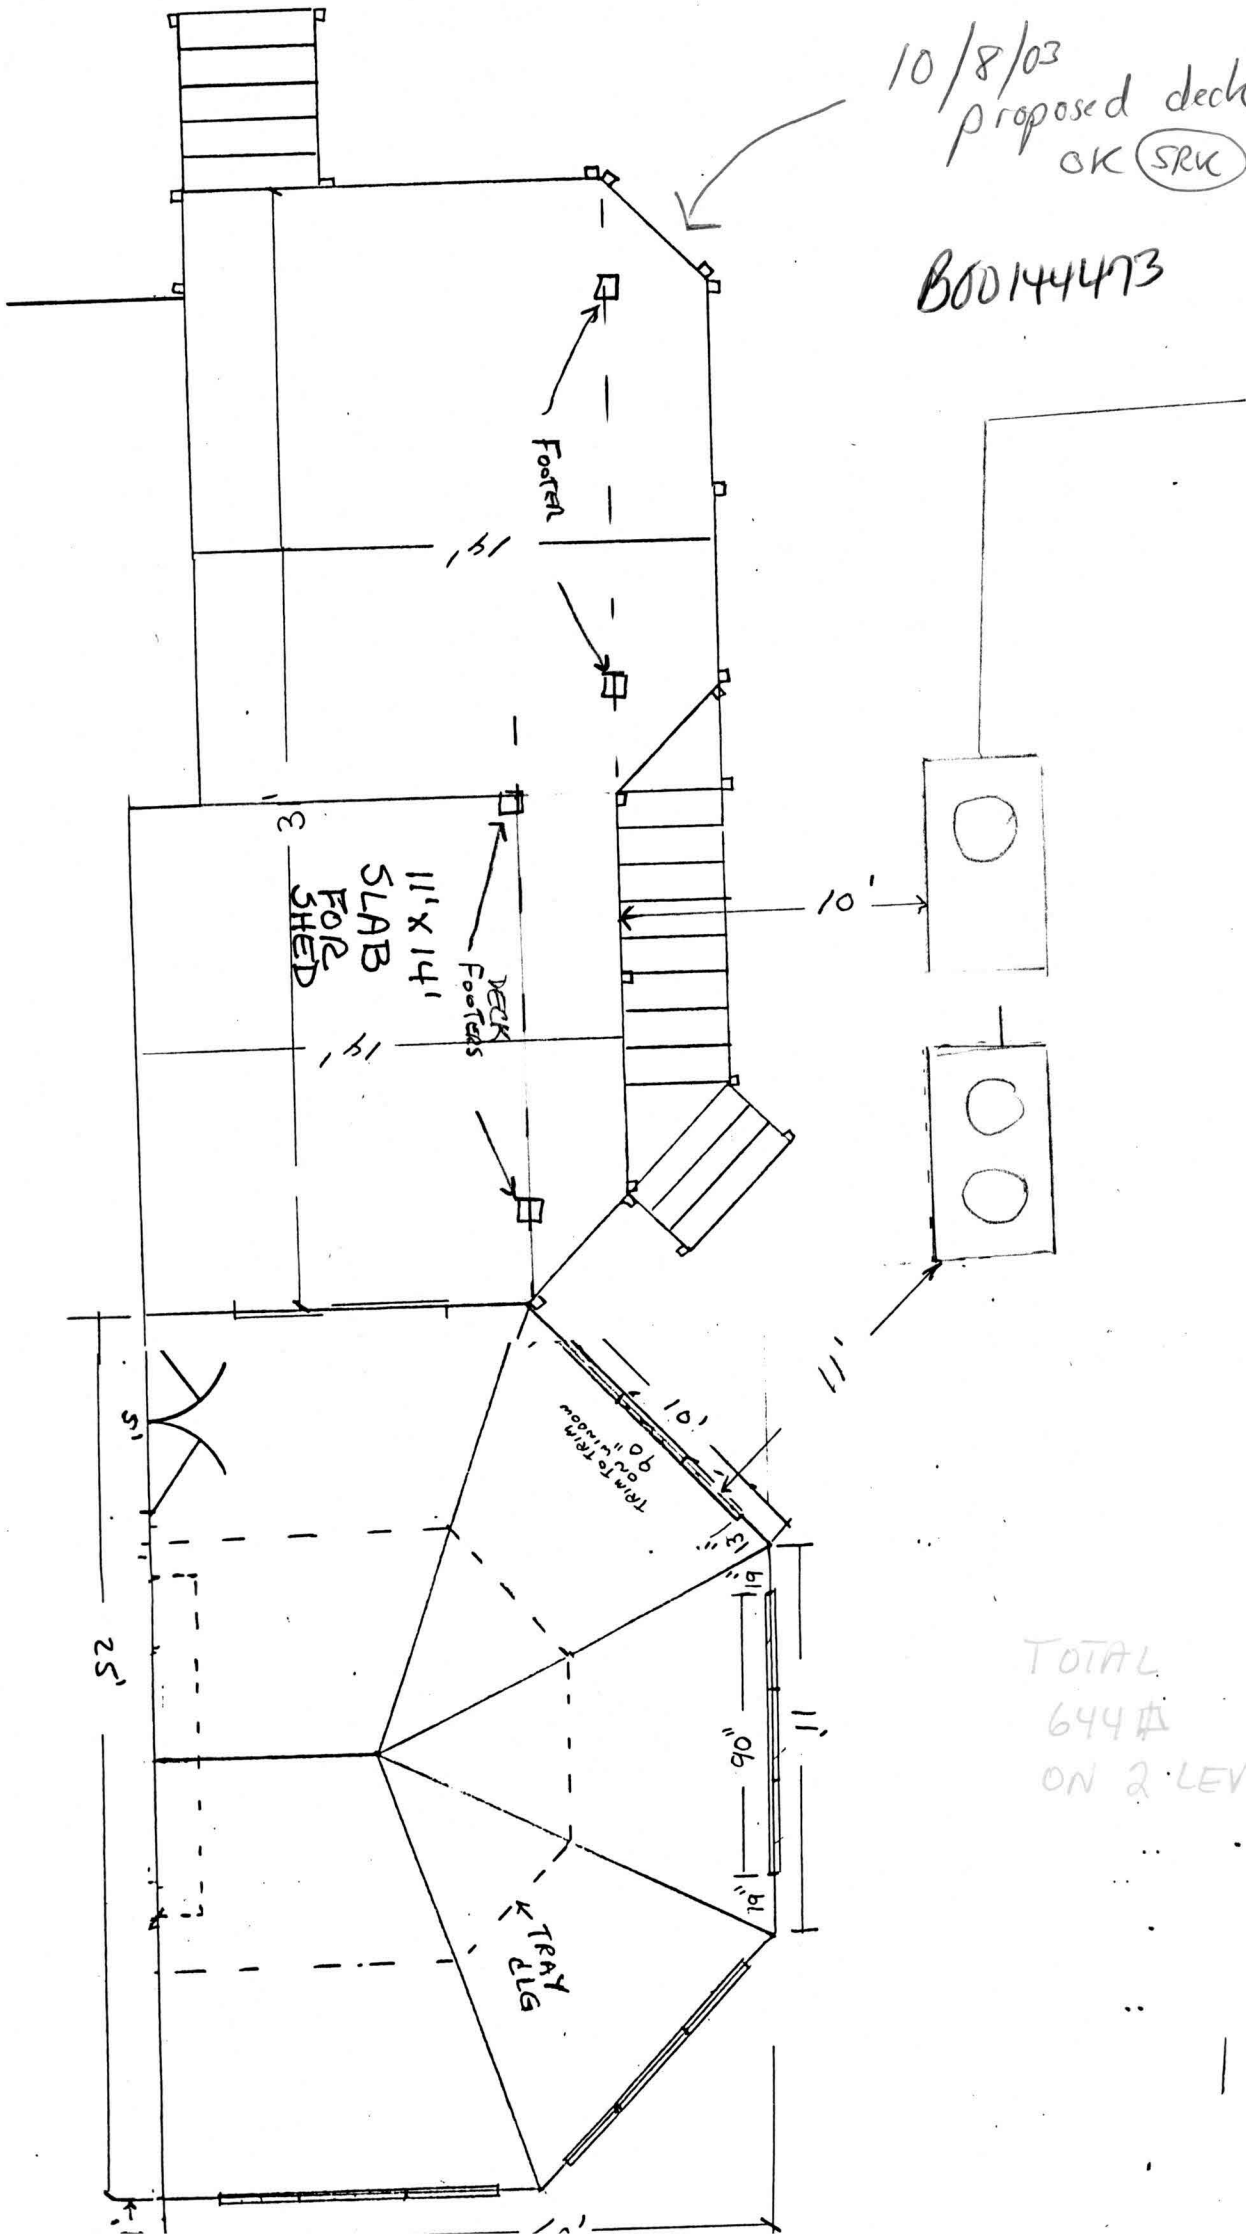