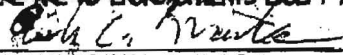


RECORD REFERENCES LIBER/FOLIO PLAT BOOK PLAT NO./FOLIO 1969	WALL CHECK SINGLE FAMILY DWELLING	MARKS & ASSOCIATES L.L.C. CONSULTING SURVEYORS-LAND PLANNERS 4081 COLLEGE AVENUE ELLICOTT CITY, MARYLAND TELEPHONE (410)747-8788 FAX (410)747-8789
SCALE 1"=50' DATE 12/06/00	LOT 16 PATERNAL GIFT FARM HOWARD COUNTY, MARYLAND	I HEREBY CERTIFY THAT THE IMPROVEMENTS ARE LOCATED AS SHOWN HEREON AND TO THE BEST OF MY KNOWLEDGE AND BELIEF, THERE ARE NO ENCROACHMENTS EXCEPT AS SHOWN.  ERIK C. MARKS R.P., S. #607

GENERAL NOTES

I. ELEVATIONS

- A. BASEMENT: 526.0
- B. FIRST FLOOR 535.0
- C. INVERT OUT OF HOUSE: 530.5
- D. INVERT INTO SEPTIC TANK: 530.3
- E. INVERT OUT OF SEPTIC TANK: 530.1
- F. INVERT INTO DISTRIBUTION BOX: 530.0
- G. INVERT INTO TRENCH: 530.0
- H. EXISTING GRADE AT SEPTIC TANK: 533.0
- I. EXISTING GRADE AT DISTRIBUTION BOX: ~~533.0~~ 534.5
- J. EXISTING GRADE AT TRENCH: ~~492.8~~ 534.5
- K. ELEVATION AT WELL AT GRADE: 534.5


Total linear feet of trench
required 240 feet

Width of trench(es) 3 feet

Depth of trench(es) 7' feet

Depth of stone required below
distribution box

*ADD'L 2 FT.
60' TRENCH FOR 5TH
BEDRM
MR
3/5/02*

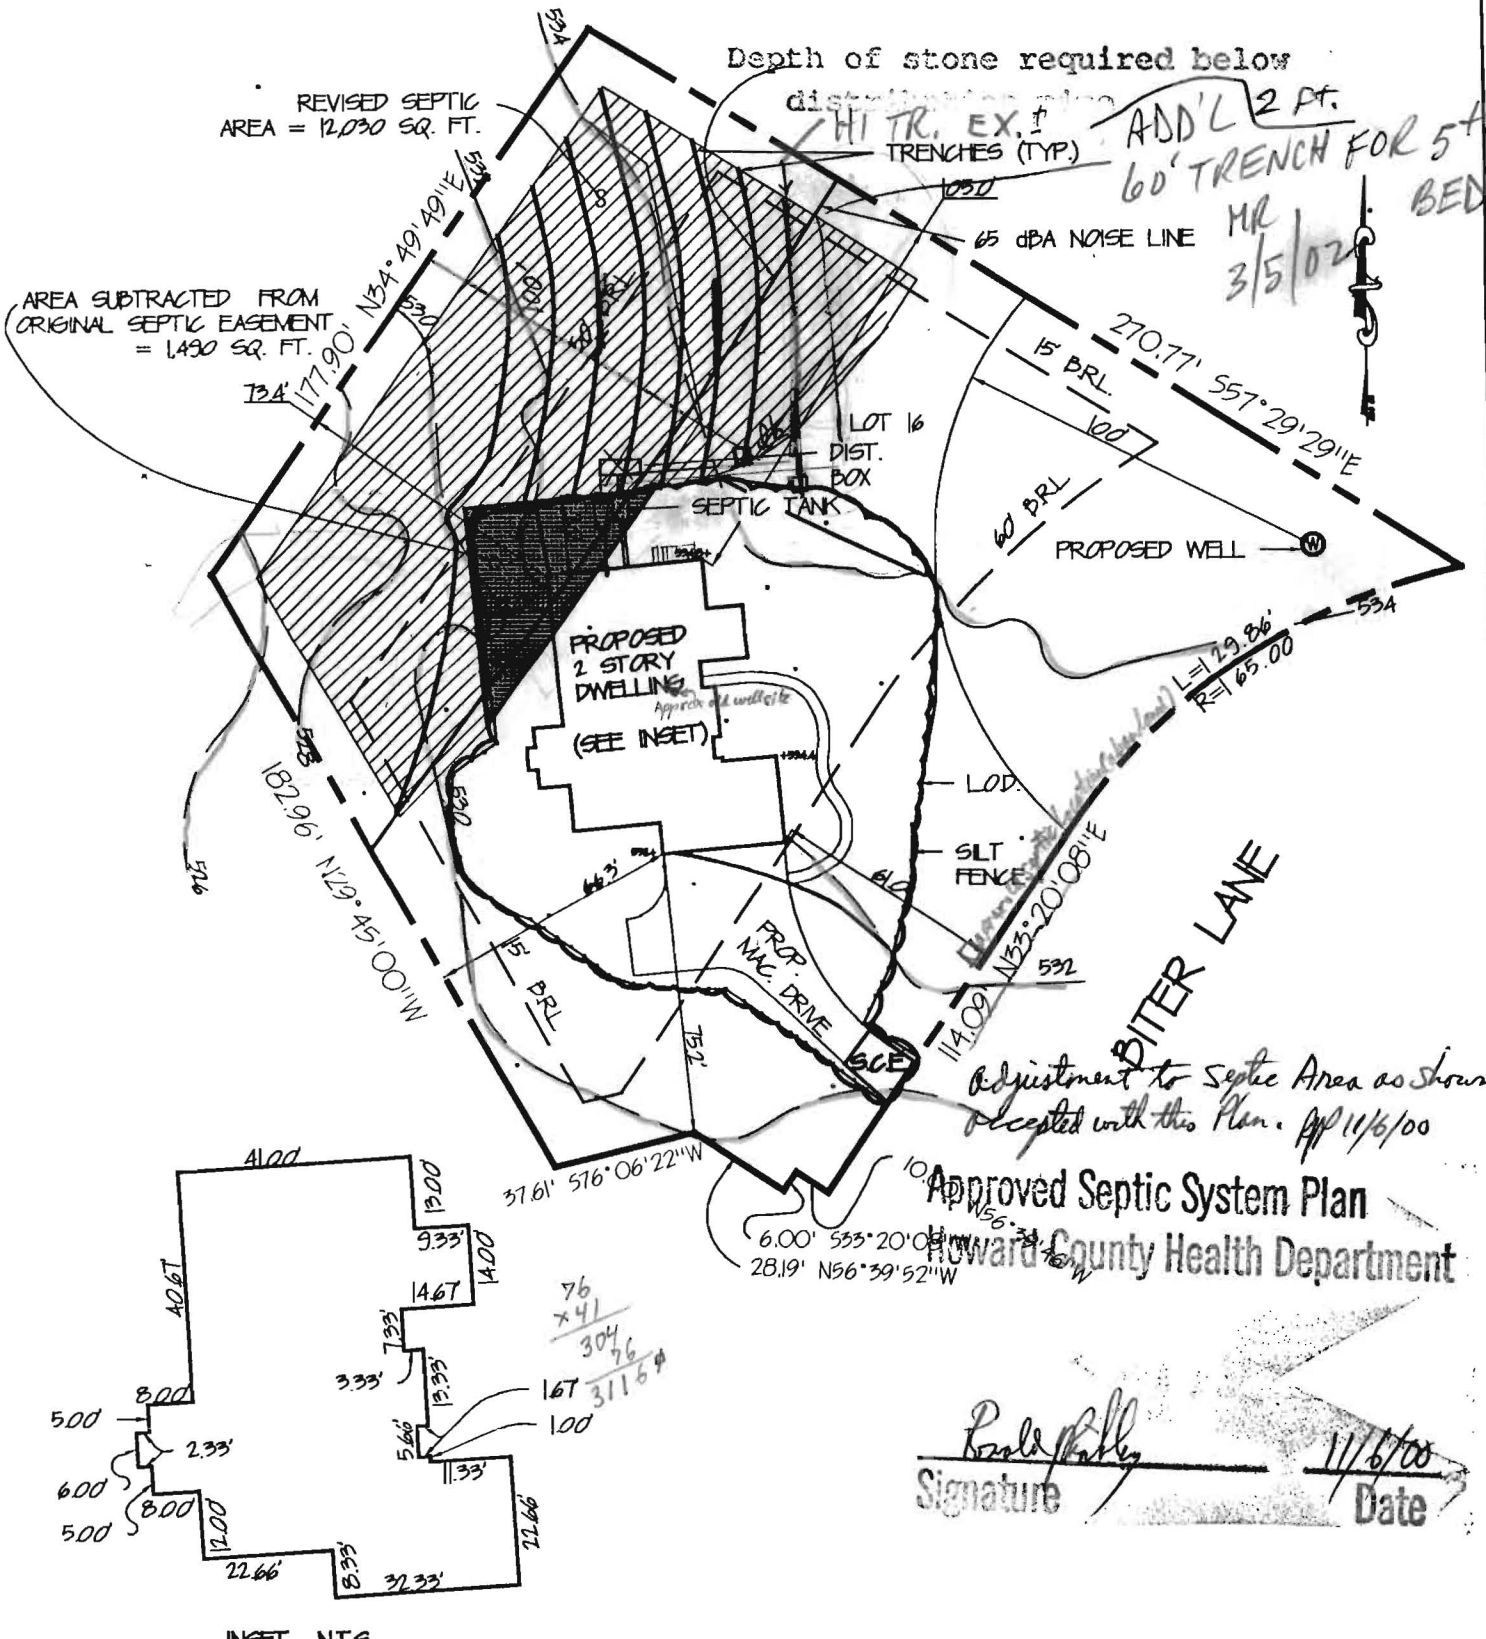

*Adjustment to Septic Area as shown
Accepted with this Plan. 11/6/00*

Approved Septic System Plan
Howard County Health Department

Paul Kelly
Signature _____ Date 11/6/00

INSET N.T.S.

RECORD REFERENCES LIBER/FOLIO PLAT BOOK PLAT NO./FOLIO <u>11369</u>	PLOT PLAN FOR PROPOSED SINGLE FAMILY DWELLING LOT 16 PATERNAL GIFT FARM HOWARD COUNTY, MARYLAND	MARKS & ASSOCIATES L.L.C. CONSULTING SURVEYORS-LAND PLANNERS 4531 COLLEGE AVENUE ELLICOTT CITY, MARYLAND TELEPHONE (410)747-8738 FAX (410)747-8739
SCALE <u>1"=50'</u> DATE <u>10/05/00</u>		BUILDER: TRADITION HOME BUILDERS INC. 4540 TEN OAKS ROAD DAYTON, MARYLAND, 21036 (410) 531-9203

6051.02

TRADITION HOME BUILDERS, INC.

PK

March 19, 2001

RECEIVED

check # 5661
CK # 37359
850
3-19-01

MAR 19 2001

LICENSIS & PERMITS
DIVISION

Avis L. Corbin, Chief
Department of Inspections, Licenses & Permits
3430 Court House Drive
Ellicott City, MD 21043

7104 Biter Lane

Dear Avis,

We would like to file for a change on building permit number B00126990. We would like to add a guestroom in the existing unfinished attic space as shown on the plan. This space would add 261 square feet to the finished space. Footprint will not change, Guestroom with bath + closet.

If there are any problems please contact us.

Sincerely,

Ann M. Leaf

REVIEWED FOR CODE COMPLIANCE	
DEPARTMENT OF INSPECTIONS, LICENSIS AND PERMITS HOWARD COUNTY	
DATE:	3/29/01
BY:	[Signature]
<input type="checkbox"/> SUBJ. C. TO COMMENTS OF LETTER	
<input checked="" type="checkbox"/> SUBJ. C. TO FIELD INSPECTION	
<input type="checkbox"/> SUBJ. C. TO COMMENTS ON PLANS	
<input type="checkbox"/> AMENDMENT	<input checked="" type="checkbox"/> FINAL

3/5/02

Returned call to Anne @ Tradition 917-4588. Mark gave her 60 ft add'l trench info + we'll need a no fee inspection. 2/26/02

cc: Health Dept
attention - Frank Skene

Hi Frank;
As per our phone discussion today, the above ref. amendment was not routed to Health Dept in error. Should you please review + forward status ASAP
Thank you, Ann