

7/11/01
7/18/01
Sept 10:00
7/25/01
12:00
C.O. & WPI
24/01
ATE
FINAL

05-421855

PERMIT

P 515348

SEWAGE DISPOSAL SYSTEM

A 49417

HOWARD COUNTY HEALTH DEPARTMENT

BUREAU OF ENVIRONMENTAL HEALTH
410-313-2640

ISSUE DATE 7/18/2001

APPROVAL DATE 7/25/01

INDEXED

Jack Fyock Septic Service

IS PERMITTED TO INSTALL ALTER

ADDRESS PO Box 89, Glenelg, MD 21737 PHONE 410-988-9270

UBDIVISION Paternal Gift Farm LOT NUMBER 19 ADDRESS 7109 Biter Lane

PROPERTY OWNER Charlie & Claudia Mercan PROPERTY OWNER'S ADDRESS 10306 Citation Way

LAUREL, MD 20723
SEPTIC TANK CAPACITY 1250 GALLONS *WATERTIGHT SEPTIC TANK REQUIRED*

PUMP CHAMBER CAPACITY N/A GALLONS

NUMBER OF BEDROOMS 4

SQUARE FEET PER BEDROOM 210

LINEAR FEET OF TRENCH REQUIRED 280

TRENCHES: Trenches to be 3 feet wide. Inlet 6 feet below original grade. Bottom maximum depth 8 feet below original grade. 2 feet of stone below distribution pipe.

LOCATION: Starting at the intersection of the 54.90' and 150.23' lot lines, place the distribution box 20 feet down the 150.23' lot line and 60 feet off this same lot line. Run (4) trenches on contour toward the 150.23' lot line. 3/23/01 OK (BA)

PLANS APPROVED Mark Rifkin, R.S. DATE 3/19/2001

PERMIT VOID AFTER 2 YEARS

NOTE: CONTRACTOR RESPONSIBLE FOR SCHEDULING A PRE-CONSTRUCTION INSPECTION FOR ALL INSTALLATIONS

NOTE: TOP OF SEPTIC TANKS ARE TO BE NO DEEPER THAN 3.0 FEET BELOW FINISH GRADE

NOTE: WATERTIGHT SEPTIC TANKS REQUIRED

NOTE: CLEANOUT REQUIRED EVERY 70 FEET OF SEWER LINE AND/OR AT 90° SWEEPS IN LINES FROM HOUSE TO DRAIN FIELDS, 90° ELBOWS ARE NOT ACCEPTABLE

NOTE: ALL PARTS OF SEPTIC SYSTEMS (I.E. TANK, DISTRIBUTION BOX, DRAINFIELDS) TO BE 100 FEET FROM ANY WATER WELL UNLESS OTHERWISE SPECIFICALLY AUTHORIZED

NOTE: NO ABSORPTION TRENCH TO EXCEED 100 FEET IN LENGTH UNLESS SPECIFICALLY AUTHORIZED

NOTE: ALL PIPE FROM HOUSE TO SEPTIC TANK MUST BE CAST IRON OR SCHEDULE 35/40 PVC OR ABS

NOTE: MANHOLE RISERS REQUIRED ON ALL SEPTIC TANKS AND PUMP CHAMBERS


NOTE: DISTRIBUTION BOXES MUST HAVE BAFFLES

NOTE: IF PUMPED SEPTIC SYSTEM REQUIRED, (1) SEPTIC PUMP DETAIL TO BE PROVIDED BY INSTALLER PRIOR TO ISSUANCE OF SEPTIC PERMIT (2) PUMP PERFORMANCE TEST IS NECESSARY PRIOR TO HEALTH DEPARTMENT APPROVAL OF SEPTIC PERMIT

NEITHER THE HOWARD COUNTY COUNCIL NOR THE HEALTH DEPARTMENT IS RESPONSIBLE FOR THE SUCCESSFUL OPERATION OF ANY SYSTEM
PERMITTEE RESPONSIBLE FOR OBTAINING FINAL APPROVAL ON THIS PERMIT
CALL 410-313-2640 FOR INSPECTION OF SEPTIC SYSTEM

P515348

NOT TO SCALE

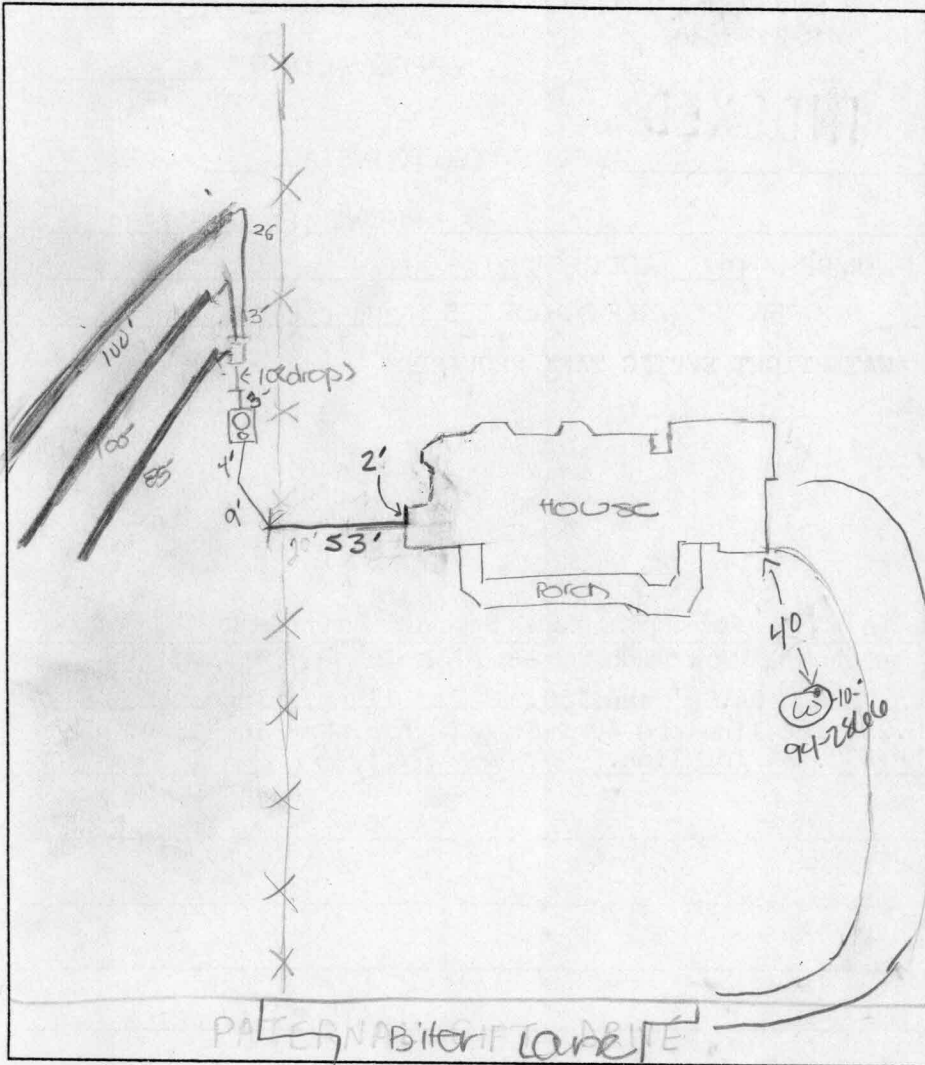

TRENCH DATA

TRENCH WIDTH 3
 TRENCH INLET DEPTH 6
 TRENCH BOTTOM DEPTH 8
 DEPTH OF STONE 2
 NUMBER OF TRENCHES 3
 TOTAL TRENCH LENGTH 285'
 ABSORBENT AREA 655
 DISTRIBUTION BOX LEVEL
 BAFFLE IN DISTRIBUTION BOX

SEPTIC TANK DATA

SEPTIC TANK 1250 GALLONS
 MANHOLE RISER
 6 INCH INSPECTION PORT

PUMP CHAMBER DATA

PUMP CHAMBER GALLONS NA
 MANHOLE RISER NA
 ALARM NA
 PUMP PERFORMANCE TEST NA

PRE-CONSTRUCTION INSPECTION: 7/19/01-OK TO INSTALL PER PLAN (SRK)

INSPECTION COMMENTS: 7/23/01 OK to cover septic tank and first two trenches, OK to continue. DCC 7/25/01 trench 100' ready to fill. Hold for house connection - p.m. connection made 7-25-01 K& MR

INSPECTOR Geedey Kovic DATE SYSTEM APPROVED 7/25/01