

APPLICATION

PERCOLATION TESTING

A 59868
P _____

HOWARD COUNTY HEALTH DEPARTMENT
BUREAU OF ENVIRONMENTAL HEALTH
3525-H ELLICOTT MILLS DRIVE/ELLICOTT CITY, MARYLAND 21043
TELEPHONE: 313-2640

DISTRICT _____
DATE 3/9/98

TO: THE COUNTY HEALTH OFFICER
ELLICOTT CITY, MARYLAND

I HEREBY APPLY FOR THE NECESSARY TEST PRIOR TO APPLICATION FOR PERMIT TO CONSTRUCT (OR RECONSTRUCT) A SEWAGE DISPOSAL SYSTEM.

PROPERTY OWNER _____

ADDRESS _____ PHONE _____

AGENT OR PROSPECTIVE BUYER WINCHESTER HOMES INC. c/o MR. KEITH KUBISTA

ADDRESS 6305 IVY LANE SUITE 800 PHONE (301) 489-1120
GREENBELT MD. 20770

PROPERTY LOCATION:

SUBDIVISION MOBBERLY PROPERTY LOT NO. 32

ROAD AND DESCRIPTION BURNT WOODS ROAD

TAX MAP 22 PARCEL # 141, 2, 234 & 530

SIZE OF LOT 1 AC. CLUSTER TYPE BLDG. S.F.D.
(SINGLE FAMILY DWELLING OR COMMERCIAL)

THE SYSTEM INSTALLED UNDER THIS APPLICATION IS ACCEPTABLE ONLY UNTIL PUBLIC FACILITIES BECOME AVAILABLE. I FULLY UNDERSTAND THE FEE CONNECTED WITH THE FILING OF THIS PERC TEST APPLICATION IS NON-REFUNDABLE UNDER ANY CIRCUMSTANCES. I ALSO AGREE TO COMPLY WITH ALL M.O.S.H.A. REQUIREMENTS IN TESTING THIS LOT.

Zacharia Y. Fisch
(SIGNATURE OF APPLICANT)

APPROVED BY _____ FOR _____ DATE _____

DISAPPROVED BY _____ FOR _____ DATE _____

HOLD PENDING FURTHER TESTS _____

REASONS FOR REJECTION OR HOLDING _____

PERCOLATION TEST PLAT/PRELIMINARY PLAT - TITLE OR I.D. # _____ DATE _____


SITE DEVELOPMENT PLAN/FINAL PLAT - TITLE OR I.D. # _____ DATE _____

THIS IS NOT A PERMIT

COUNTY #



SOIL PROFILE

9516

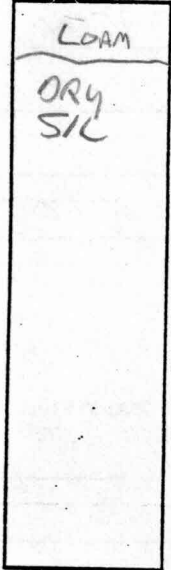


SOIL PROFILE

9512

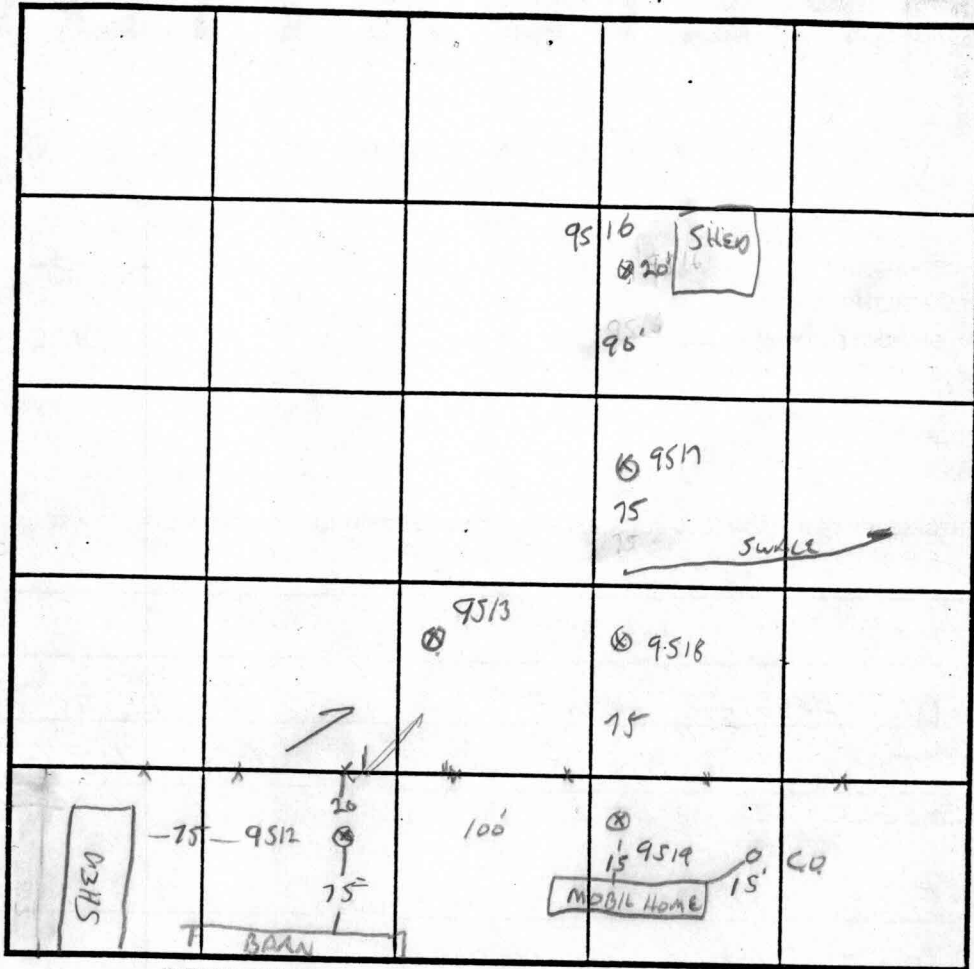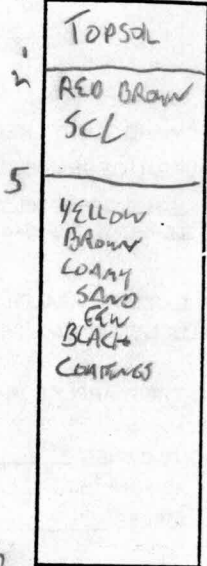

INDICATE NORTH - NAME ADJOINING ROADWAY AS BASE LINE.

LOT 32

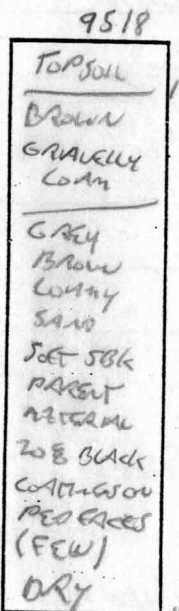

DATE	TEST NO.	DEPTH	PRE-WET		TEST - 1" DROP		TIME
			START	STOP	START	STOP	
4/16/99	9512	5/12 v	11:24	11:27	→	11:32	5AW
	9513	4/13	12:22	12:23	→	12:25	2MW
	9519	5/8" / 13	11:35	≤ 1mm	→	11:37	2MW
	9518	5/8" / 12	11:44	11:47	→	11:52	5AW
LOT 30	9517	4/13	11:50	11:55	→	12:11	16MW
	9516	3/12' 6"	12:00	12:01	→	12:02	1mm

REMARKS MOBIL HOME HAS H₂O Hookup + SEPTIC, LOT 32

TYPE OF SOIL 13 4-1315 DRY SC

TESTED BY G. SAUSAGE

ALSO PRESENT KEITH GACK'S

TRENCH DESIGN DATA: AVERAGE PERCOLATION TIME _____ TRENCH WIDTH _____

INLET DEPTH _____ MAXIMUM BOTTOM DEPTH _____ SQ. FT./BEDROOM _____

APPLICATION

PERCOLATION TESTING

A _____

P _____

HOWARD COUNTY HEALTH DEPARTMENT
BUREAU OF ENVIRONMENTAL HEALTH
3525-H ELLICOTT MILLS DRIVE/ELLICOTT CITY, MARYLAND 21043
TELEPHONE: 313-2840

DISTRICT _____

DATE 3/9/98

TO: THE COUNTY HEALTH OFFICER
ELLICOTT CITY, MARYLAND

I HEREBY APPLY FOR THE NECESSARY TEST PRIOR TO APPLICATION FOR PERMIT TO CONSTRUCT (OR RECONSTRUCT) A SEWAGE DISPOSAL SYSTEM.

PROPERTY OWNER _____

ADDRESS _____ PHONE _____

AGENT OR PROSPECTIVE BUYER WINCHESTER HOMES INC. c/o Mr. KEITH KUBISTA

ADDRESS 6305 IVY LANE SUITE 800 PHONE (301) 489-1120
GREENBELT MD. 20770

PROPERTY LOCATION:

SUBDIVISION MOBBERLY PROPERTY LOT NO. 31 28

ROAD AND DESCRIPTION BURNT WOODS ROAD

TAX MAP 22 PARCEL # 141, 2, 234 & 530

SIZE OF LOT 1 AC. CLUSTER TYPE BLDG. S.F.D.
(SINGLE FAMILY DWELLING OR COMMERCIAL)

THE SYSTEM INSTALLED UNDER THIS APPLICATION IS ACCEPTABLE ONLY UNTIL PUBLIC FACILITIES BECOME AVAILABLE. I FULLY UNDERSTAND THE FEE CONNECTED WITH THE FILING OF THIS PERC TEST APPLICATION IS NON-REFUNDABLE UNDER ANY CIRCUMSTANCES. I ALSO AGREE TO COMPLY WITH ALL M.O.S.H.A. REQUIREMENTS IN TESTING THIS LOT.

Zecharia Y. Fisch
(SIGNATURE OF APPLICANT)

APPROVED BY _____ FOR _____ DATE _____

DISAPPROVED BY _____ FOR _____ DATE _____

HOLD PENDING FURTHER TESTS _____

REASONS FOR REJECTION OR HOLDING _____

PERCOLATION TEST PLAT/PRELIMINARY PLAT - TITLE OR I.D. # _____ DATE _____

SITE DEVELOPMENT PLAN/FINAL PLAT - TITLE OR I.D. # _____ DATE _____

THIS IS NOT A PERMIT

COUNTY #

SOIL PROFILE

0'


TOPSOIL	1
DARK BR LOAM	3
DARK GREY BROWN MILK LOAM	9
WATER	12

9613

BR LOAM	2-3
BR SL MICACEOUS COARSE CENTER OF HOLE/SWALE WHITE/GREEN MICACEOUS SIL DULL GR/ GY REDOX FEAR TOWARD BOTTOM	12
WATER	12

9602

BR HEAVY LOAM	2-3
DULL GY, BR BLACK SIL.	5
CAVING WET	9
WATER	9

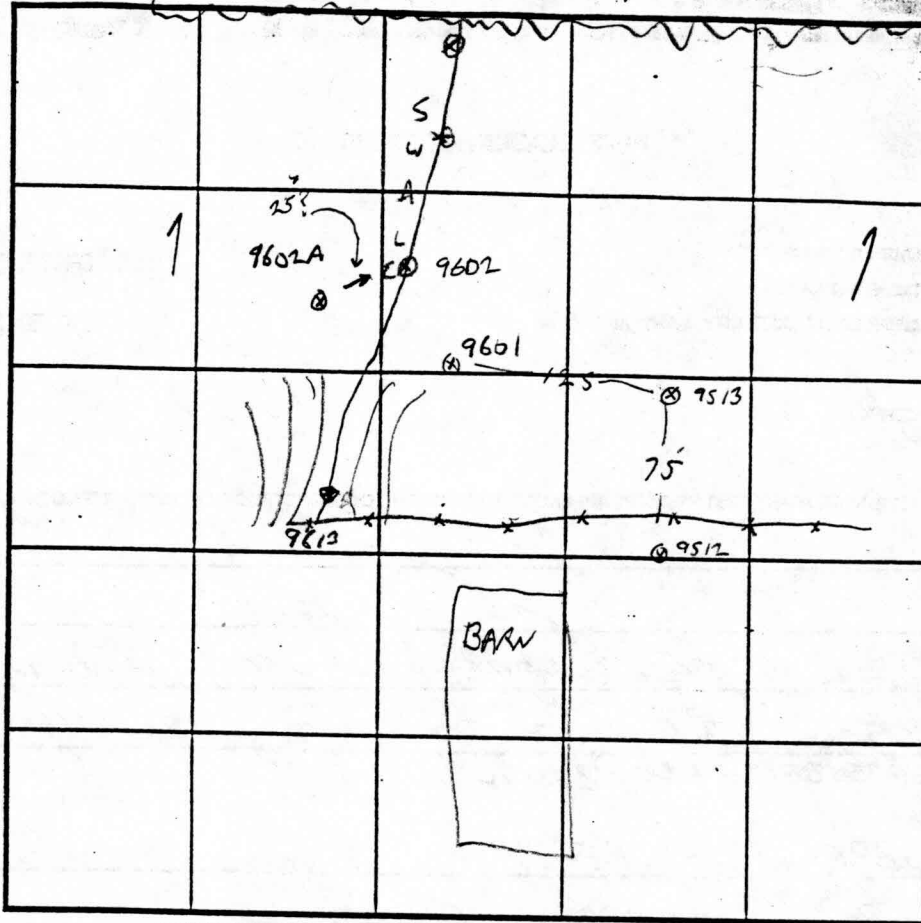

INDICATE NORTH - NAME ADJOINING ROADWAY AS BASE LINE.

SOIL PROFILE

0'

9601	1
Brown LOAM	2
TAN/BROWN SIL	13

LOT 31

DATE	TEST NO.	DEPTH	PRE-WET		TEST - 1" DROP		TIME
			START	STOP	START	STOP	
5/14/98	9601	2.5 / 13	11:03	11:05	→	11:08	3 MW
	9613	3.3 / 12	11:11	11:13	→	11:15	2 MW
	9602	1 9V H2O					FALL
	9602A	3	12:00	12:04	→	12:10	6 MW

REMARKS LOT 31 SEE LOT 32 FOR BALANCE OF HOLES, AVOID SWALE

TYPE OF SOIL

TESTED BY G. SAVAGE ALSO PRESENT

TRENCH DESIGN DATA: AVERAGE PERCOLATION TIME TRENCH WIDTH

INLET DEPTH MAXIMUM BOTTOM DEPTH SQ. FT./BEDROOM

APPLICATION

PERCOLATION TESTING

A _____

P _____

HOWARD COUNTY HEALTH DEPARTMENT
BUREAU OF ENVIRONMENTAL HEALTH
3525-H ELLICOTT MILLS DRIVE/ELLICOTT CITY, MARYLAND 21043
TELEPHONE: 313-2640

DISTRICT _____

DATE 3/9/98

TO: THE COUNTY HEALTH OFFICER
ELLICOTT CITY, MARYLAND

I HEREBY APPLY FOR THE NECESSARY TEST PRIOR TO APPLICATION FOR PERMIT TO CONSTRUCT (OR RECONSTRUCT) A SEWAGE DISPOSAL SYSTEM.

PROPERTY OWNER _____

ADDRESS _____ PHONE _____

AGENT OR PROSPECTIVE BUYER WINCHESTER HOMES INC. c/o Mr. KEITH KUBISTA

ADDRESS 6305 IVY LANE SUITE 800 PHONE (301) 489-1120
GREENBELT MD. 20770

PROPERTY LOCATION:

SUBDIVISION MOBBERLY PROPERTY LOT NO. 15 28

ROAD AND DESCRIPTION BURNT WOODS ROAD

TAX MAP 22 PARCEL # 141, 2, 234 & 530

SIZE OF LOT 1 AC. CLUSTER TYPE BLDG. S.F.D.
(SINGLE FAMILY DWELLING OR COMMERCIAL)

THE SYSTEM INSTALLED UNDER THIS APPLICATION IS ACCEPTABLE ONLY UNTIL PUBLIC FACILITIES BECOME AVAILABLE. I FULLY UNDERSTAND THE FEE CONNECTED WITH THE FILING OF THIS PERC TEST APPLICATION IS NON-REFUNDABLE UNDER ANY CIRCUMSTANCES. I ALSO AGREE TO COMPLY WITH ALL M.O.S.H.A. REQUIREMENTS IN TESTING THIS LOT. Zacharia Y. Fisch
(SIGNATURE OF APPLICANT)

APPROVED BY _____ FOR _____ DATE _____

DISAPPROVED BY _____ FOR _____ DATE _____

HOLD PENDING FURTHER TESTS _____

REASONS FOR REJECTION OR HOLDING _____

PERCOLATION TEST PLAT/PRELIMINARY PLAT - TITLE OR I.D. # _____ DATE _____

SITE DEVELOPMENT PLAN/FINAL PLAT - TITLE OR I.D. # _____ DATE _____

THIS IS NOT A PERMIT


COUNTY #

SOIL PROFILE

0' 8262
 red brown SilM
 3.0
 1qt beigh SilM micaceous
 5.0 40% Rx
 7.0 brn. grey SilM micaceous 30% shale
 12.0

SOIL PROFILE

0'

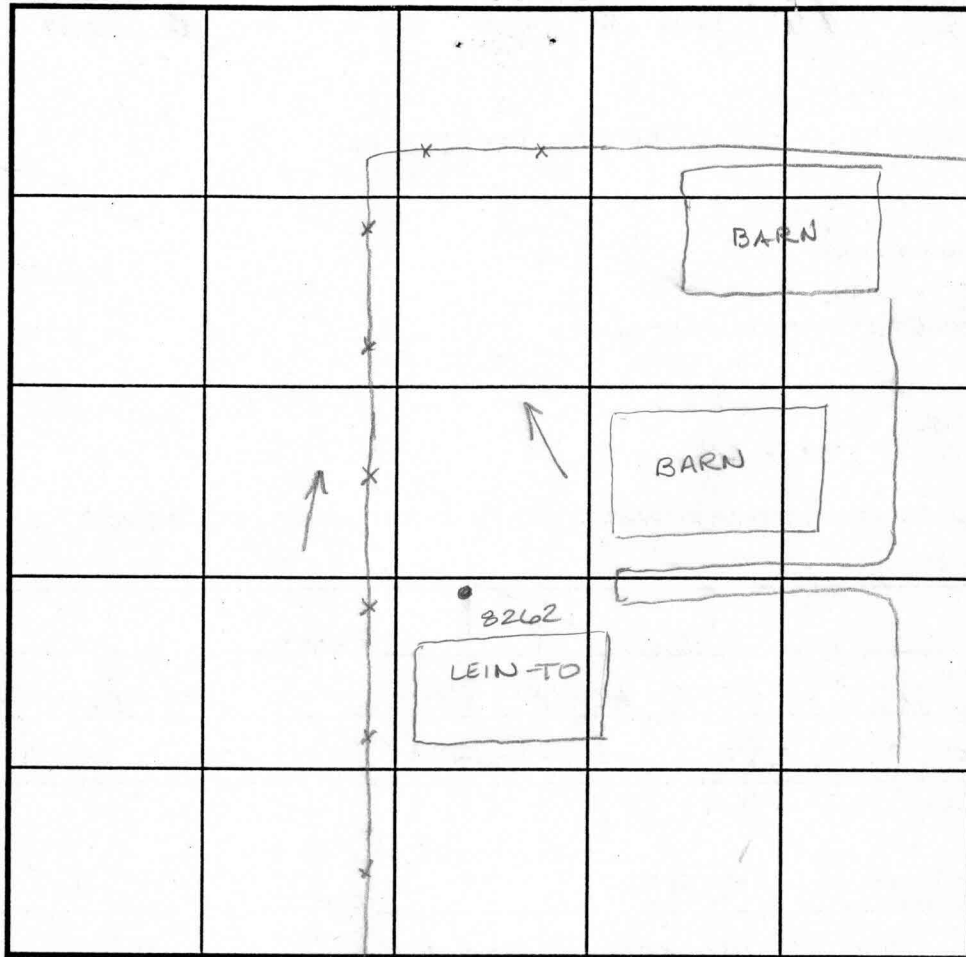

INDICATE NORTH - NAME ADJOINING ROADWAY AS BASE LINE.

DATE	TEST NO.	DEPTH	PRE-WET		TEST - 1" DROP		TIME
			START	STOP	START	STOP	
3-18-99	8262	4.5 V12.0	12:35	12:38	12:38	12:43	5min

REMARKS _____

TYPE OF SOIL _____

TESTED BY Amy McMillen ALSO PRESENT Mike Fitzgerald/Polt

TRENCH DESIGN DATA: AVERAGE PERCOLATION TIME _____ TRENCH WIDTH _____

INLET DEPTH _____ MAXIMUM BOTTOM DEPTH _____ SQ. FT/BEDROOM _____

LOT 6
WIGGLESWORTH PROPERTY
PLAT NO. 4014

F-00-71 THE PADDOCKS

EXISTING PUE
UTILITY


Lot 20 Owned By The Paddocks
owner's Association, Inc.

955.20'

N80°03'32"E 2055.32'

OPEN SPACE
LOT 20
1996 AC.±

PRIVATE WATER QUALITY
MANAGEMENT, DRAINAGE,
UTILITY & ACCESS EASEMENT

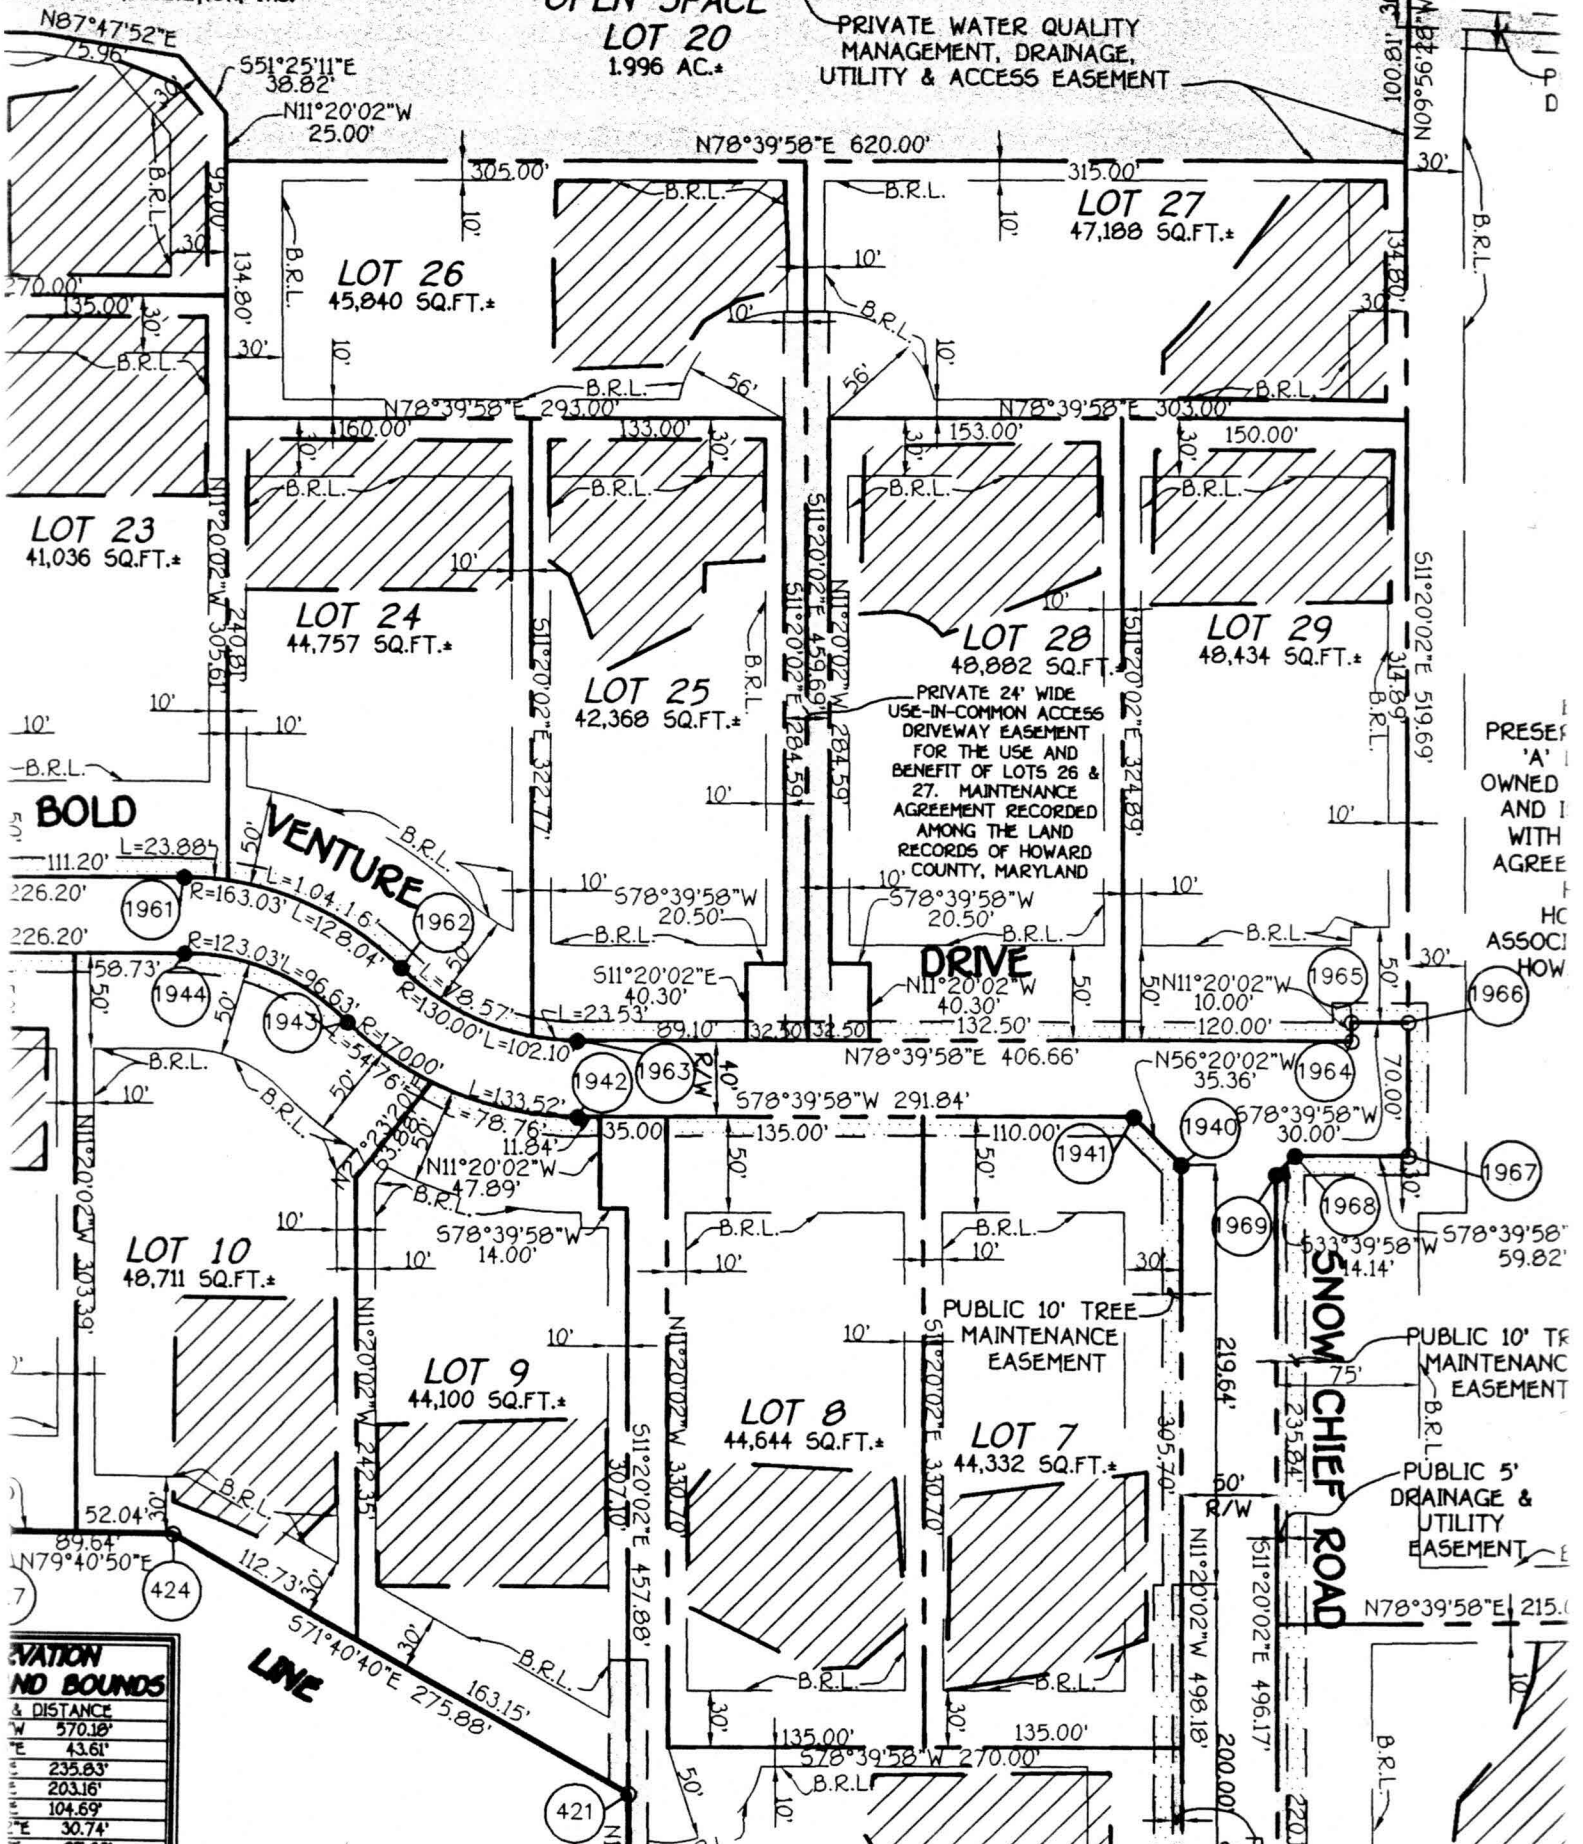

ELEVATION AND BOUNDS

BOUNDARY	DISTANCE
W	570.18'
E	43.61'
S	235.83'
N	203.16'
S	104.69'
E	30.74'
E	27.06'

PRESE
'A'
OWNED
AND I
WITH
AGREE
HC
ASSOCI
HOW

SNOW CHIEF ROAD

LINE

DRIVE

VENTURE

BOLD

LOT 27
47,188 SQ.FT.±

LOT 26
45,840 SQ.FT.±

LOT 23
41,036 SQ.FT.±

LOT 24
44,757 SQ.FT.±

LOT 25
42,368 SQ.FT.±

LOT 28
48,882 SQ.FT.±

LOT 29
48,434 SQ.FT.±

LOT 10
48,711 SQ.FT.±

LOT 9
44,100 SQ.FT.±

LOT 8
44,644 SQ.FT.±

LOT 7
44,332 SQ.FT.±

421

424

1941

1940

1964

1967

1944

1943

1962

1961

1942

1963

1965

1966

1969

1968

1964

1967

424

421

424

424


424

424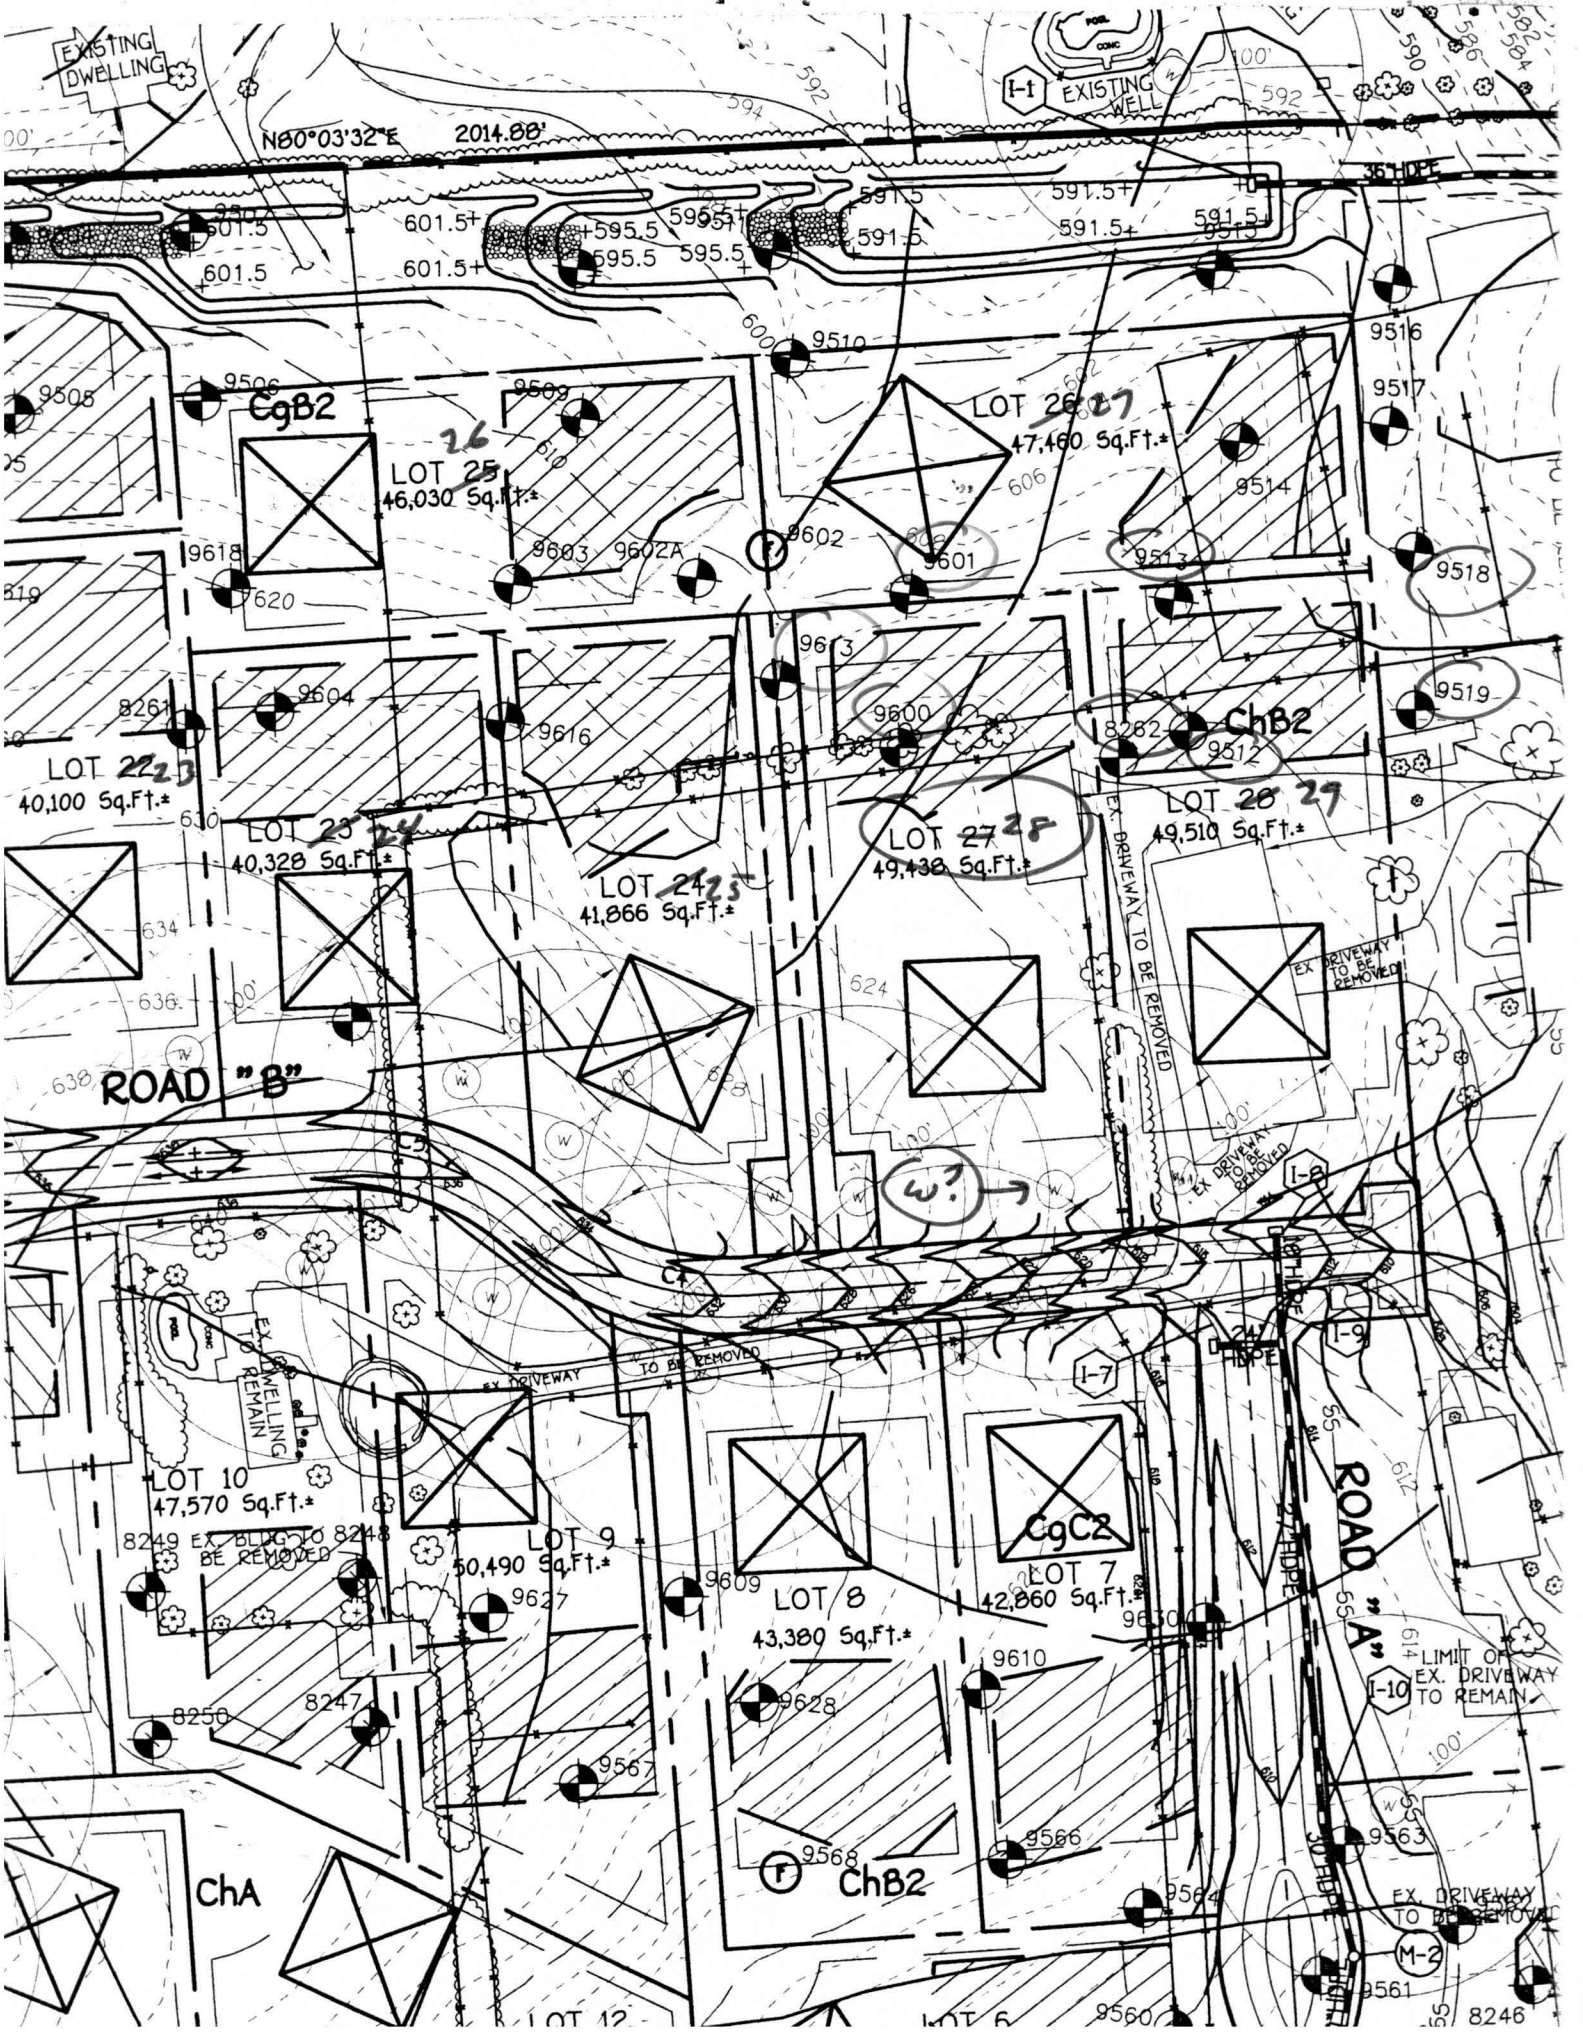

EXISTING DWELLING

EXISTING WELL

N80°03'32"E 2014.88'

ROAD "B"

ROAD "A"

LOT 10
47,570 Sq.Ft.*

LOT 9
50,490 Sq.Ft.*

LOT 8
43,380 Sq.Ft.*

LOT 7
42,860 Sq.Ft.*

ChA

ChB2

CgC2

CgB2

ChB2

LOT 25
46,030 Sq.Ft.*

LOT 26 27
47,460 Sq.Ft.*

LOT 23
40,328 Sq.Ft.*

LOT 27 28
49,438 Sq.Ft.*

LOT 28 29
49,510 Sq.Ft.*

LOT 24 25
41,866 Sq.Ft.*

LOT 12

LOT 6

M-2

LIMIT OF EX. DRIVEWAY TO REMAIN

LOT 5

LOT 4

LOT 3

LOT 2

LOT 1