

# APPLICATION

## PERCOLATION TESTING

A 59868  
P \_\_\_\_\_

HOWARD COUNTY HEALTH DEPARTMENT  
BUREAU OF ENVIRONMENTAL HEALTH  
3525-H ELLICOTT MILLS DRIVE/ELLICOTT CITY, MARYLAND 21043  
TELEPHONE: 313-2640

DISTRICT \_\_\_\_\_  
DATE 3/9/98

TO: THE COUNTY HEALTH OFFICER  
ELLICOTT CITY, MARYLAND

I HEREBY APPLY FOR THE NECESSARY TEST PRIOR TO APPLICATION FOR PERMIT TO CONSTRUCT (OR RECONSTRUCT) A SEWAGE DISPOSAL SYSTEM.

PROPERTY OWNER \_\_\_\_\_

ADDRESS \_\_\_\_\_ PHONE \_\_\_\_\_

AGENT OR PROSPECTIVE BUYER WINCHESTER HOMES INC. c/o Mr. KEITH KUBISTA

ADDRESS 6305 IVY LANE SUITE 800 PHONE (301) 489-1120  
GREENBELT MD. 20770

PROPERTY LOCATION:

SUBDIVISION MOBBERLY PROPERTY LOT NO. 98

ROAD AND DESCRIPTION BURNT WOODS ROAD

TAX MAP 22 PARCEL # 141, 2, 234 & 530

SIZE OF LOT 1 AC. CLUSTER TYPE BLDG. S.F.D.  
(SINGLE FAMILY DWELLING OR COMMERCIAL)

THE SYSTEM INSTALLED UNDER THIS APPLICATION IS ACCEPTABLE ONLY UNTIL PUBLIC FACILITIES BECOME AVAILABLE. I FULLY UNDERSTAND THE FEE CONNECTED WITH THE FILING OF THIS PERC TEST APPLICATION IS NON-REFUNDABLE UNDER ANY CIRCUMSTANCES. I ALSO AGREE TO COMPLY WITH ALL M.O.S.H.A. REQUIREMENTS IN TESTING THIS LOT. Zacharia Y. Fisch  
(SIGNATURE OF APPLICANT)

APPROVED BY \_\_\_\_\_ FOR \_\_\_\_\_ DATE \_\_\_\_\_

DISAPPROVED BY \_\_\_\_\_ FOR \_\_\_\_\_ DATE \_\_\_\_\_

HOLD PENDING FURTHER TESTS \_\_\_\_\_

REASONS FOR REJECTION OR HOLDING \_\_\_\_\_

PERCOLATION TEST PLAT/PRELIMINARY PLAT - TITLE OR I.D. # \_\_\_\_\_ DATE \_\_\_\_\_

SITE DEVELOPMENT PLAN/FINAL PLAT - TITLE OR I.D. # \_\_\_\_\_ DATE \_\_\_\_\_


# THIS IS NOT A PERMIT

1157808


COUNTY #

SOIL PROFILE


0'

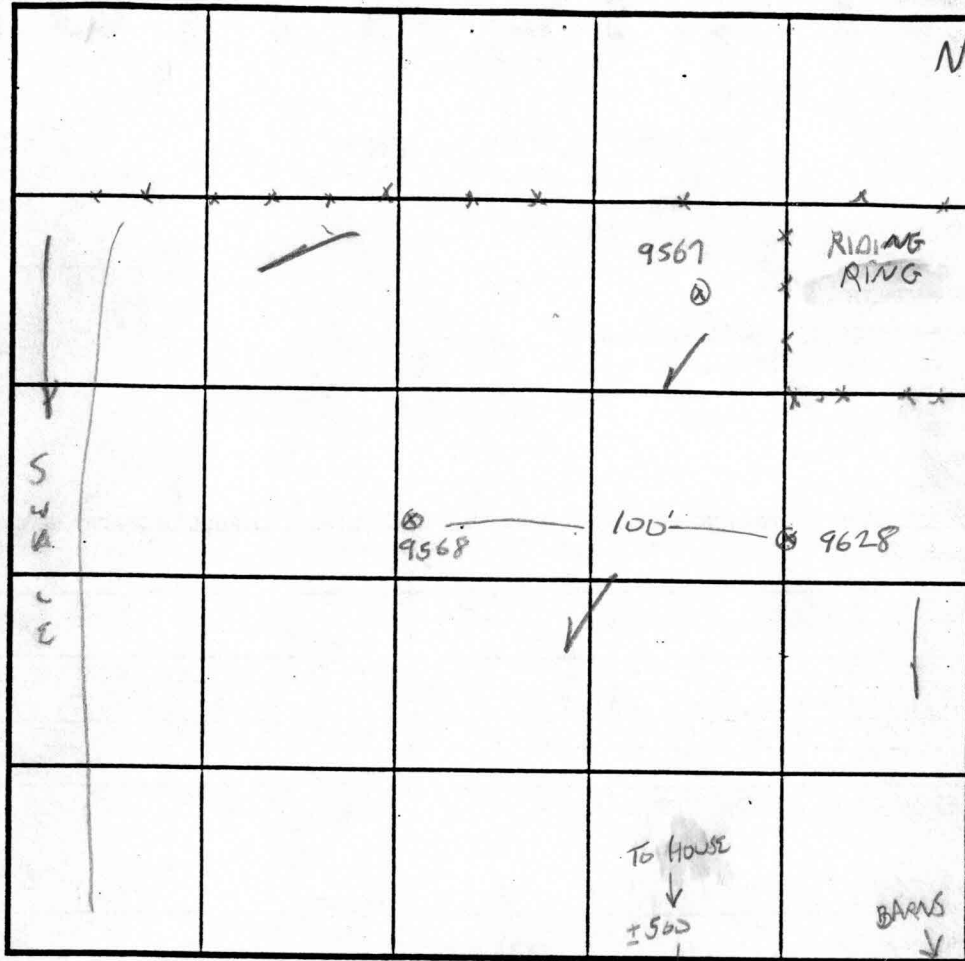

SOIL PROFILE 9568

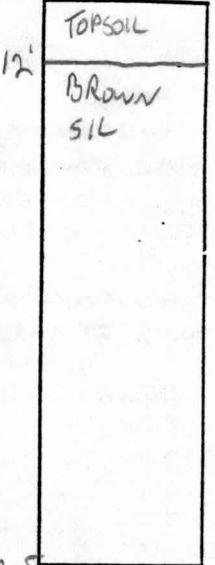

9628

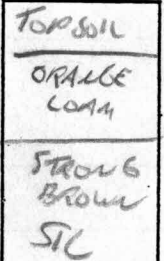

4.15

13

INDICATE NORTH - NAME ADJOINING ROADWAY AS BASE LINE.

DATE	TEST NO.	DEPTH	PRE-WET		TEST - 1" DROP		TIME
			START	STOP	START	STOP	
4-15-98	9568	4.5/12.5	3:12	3:32	1/4 INCH	SLOW	F
		7.5	3:18	10:51	3/4 INCH	SLOW	F
5/13/98	9628	4 / 13	11:11	11:12	→	11:15	3 MIN

SLOW PROFILE OK

REMARKS LOT 9, 68 UNACCEPTABLE CLAY DEPTH

TYPE OF SOIL \_\_\_\_\_

TESTED BY G. SAUCE ALSO PRESENT KELTH (Fyock)

TRENCH DESIGN DATA: AVERAGE PERCOLATION TIME \_\_\_\_\_ TRENCH WIDTH \_\_\_\_\_

INLET DEPTH \_\_\_\_\_ MAXIMUM BOTTOM DEPTH \_\_\_\_\_ SQ. FT./BEDROOM \_\_\_\_\_

# APPLICATION

PERCOLATION TESTING

A 59868

P \_\_\_\_\_

HOWARD COUNTY HEALTH DEPARTMENT  
BUREAU OF ENVIRONMENTAL HEALTH  
3525-H ELLICOTT MILLS DRIVE/ELLICOTT CITY, MARYLAND 21043  
TELEPHONE: 313-2640

DISTRICT \_\_\_\_\_

DATE 3/9/98

TO: THE COUNTY HEALTH OFFICER  
ELLICOTT CITY, MARYLAND

I HEREBY APPLY FOR THE NECESSARY TEST PRIOR TO APPLICATION FOR PERMIT TO CONSTRUCT (OR RECONSTRUCT) A SEWAGE DISPOSAL SYSTEM.

PROPERTY OWNER \_\_\_\_\_

ADDRESS \_\_\_\_\_ PHONE \_\_\_\_\_

AGENT OR PROSPECTIVE BUYER WINCHESTER HOMES INC. c/o Mr. KEITH KUBISTA

ADDRESS 6305 IVY LANE SUITE 800 PHONE (301) 489-1120  
GREENBELT MD. 20770

PROPERTY LOCATION:

SUBDIVISION MOBBERLY PROPERTY LOT NO. 87

ROAD AND DESCRIPTION BURNT WOODS ROAD

TAX MAP 22 PARCEL # 141, 2, 234 & 530

SIZE OF LOT 1 AC. CLUSTER TYPE BLDG. S.F.D.  
(SINGLE FAMILY DWELLING OR COMMERCIAL)

THE SYSTEM INSTALLED UNDER THIS APPLICATION IS ACCEPTABLE ONLY UNTIL PUBLIC FACILITIES BECOME AVAILABLE. I FULLY UNDERSTAND THE FEE CONNECTED WITH THE FILING OF THIS PERC TEST APPLICATION IS NON-REFUNDABLE UNDER ANY CIRCUMSTANCES. I ALSO AGREE TO COMPLY WITH ALL M.O.S.H.A. REQUIREMENTS IN TESTING THIS LOT. Zacharia Y. Fisch  
(SIGNATURE OF APPLICANT)

APPROVED BY \_\_\_\_\_ FOR \_\_\_\_\_ DATE \_\_\_\_\_

DISAPPROVED BY \_\_\_\_\_ FOR \_\_\_\_\_ DATE \_\_\_\_\_

HOLD PENDING FURTHER TESTS \_\_\_\_\_

REASONS FOR REJECTION OR HOLDING \_\_\_\_\_

PERCOLATION TEST PLAT/PRELIMINARY PLAT - TITLE OR I.D. # \_\_\_\_\_ DATE \_\_\_\_\_



SITE DEVELOPMENT PLAN/FINAL PLAT - TITLE OR I.D. # \_\_\_\_\_ DATE \_\_\_\_\_

# THIS IS NOT A PERMIT

A59868


COUNTY #

SOIL PROFILE

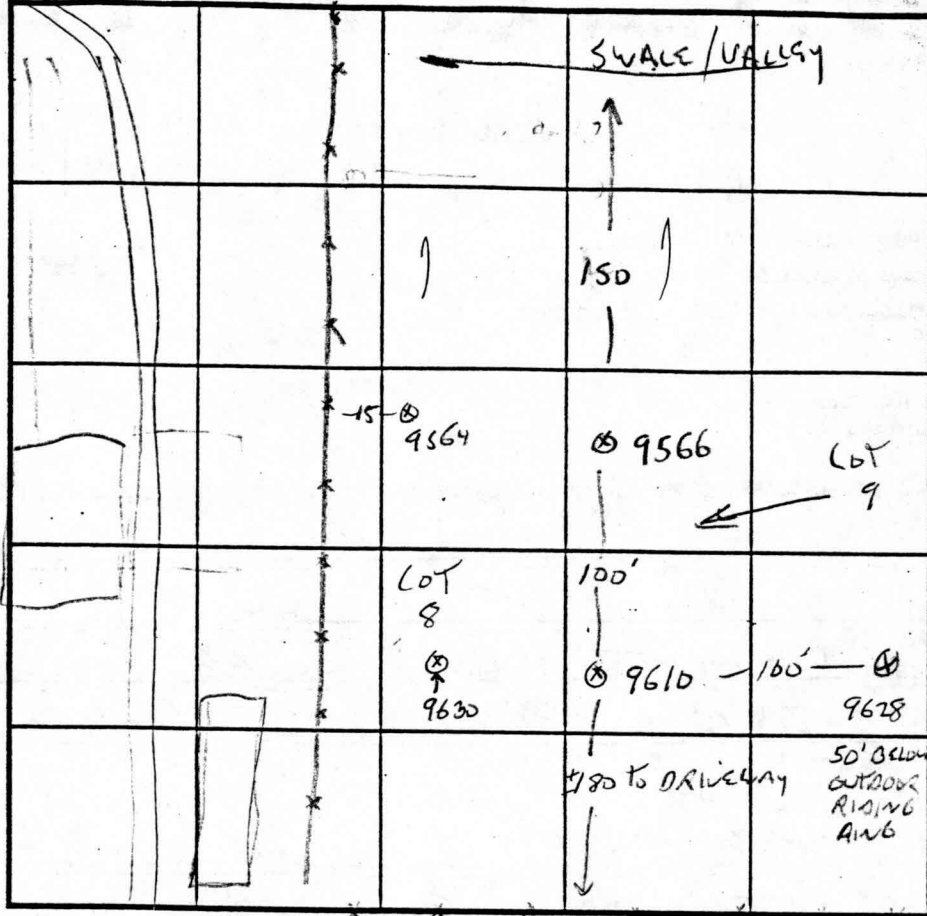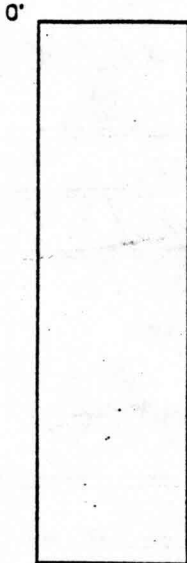


SOIL PROFILE


9566

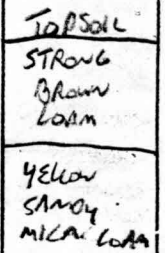

9610

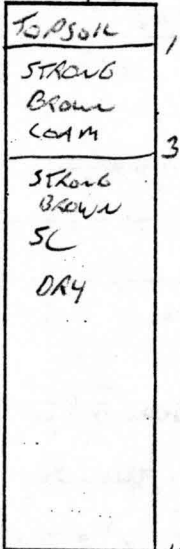

9630

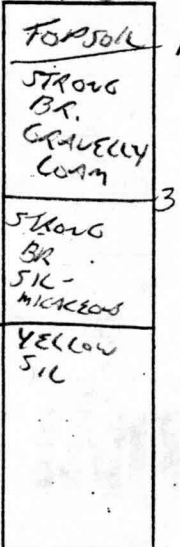

INDICATE NORTH - NAME ADJOINING ROADWAY AS BASE LINE

← TO PEEBLES RD; DRIVEWAY

DATE	TEST NO.	DEPTH	PRE-WET		TEST - 1" DROP		TIME
			START	STOP	START	STOP	
4/15/98	9566	5/12	11:34	11:37	→	11:44	7 MIN
5/13/98	9610	3.5/14	11:02	11:05	→	11:08	3 MIN
	9630	4.5/13	12:38	12:39	→	12:41	2 MIN

REMARKS LOT 8

TYPE OF SOIL


TESTED BY G SAUCE

ALSO PRESENT Fyock & CREW

TRENCH DESIGN DATA: AVERAGE PERCOLATION TIME TRENCH WIDTH

INLET DEPTH MAXIMUM BOTTOM DEPTH SQ. FT./BEDROOM

13

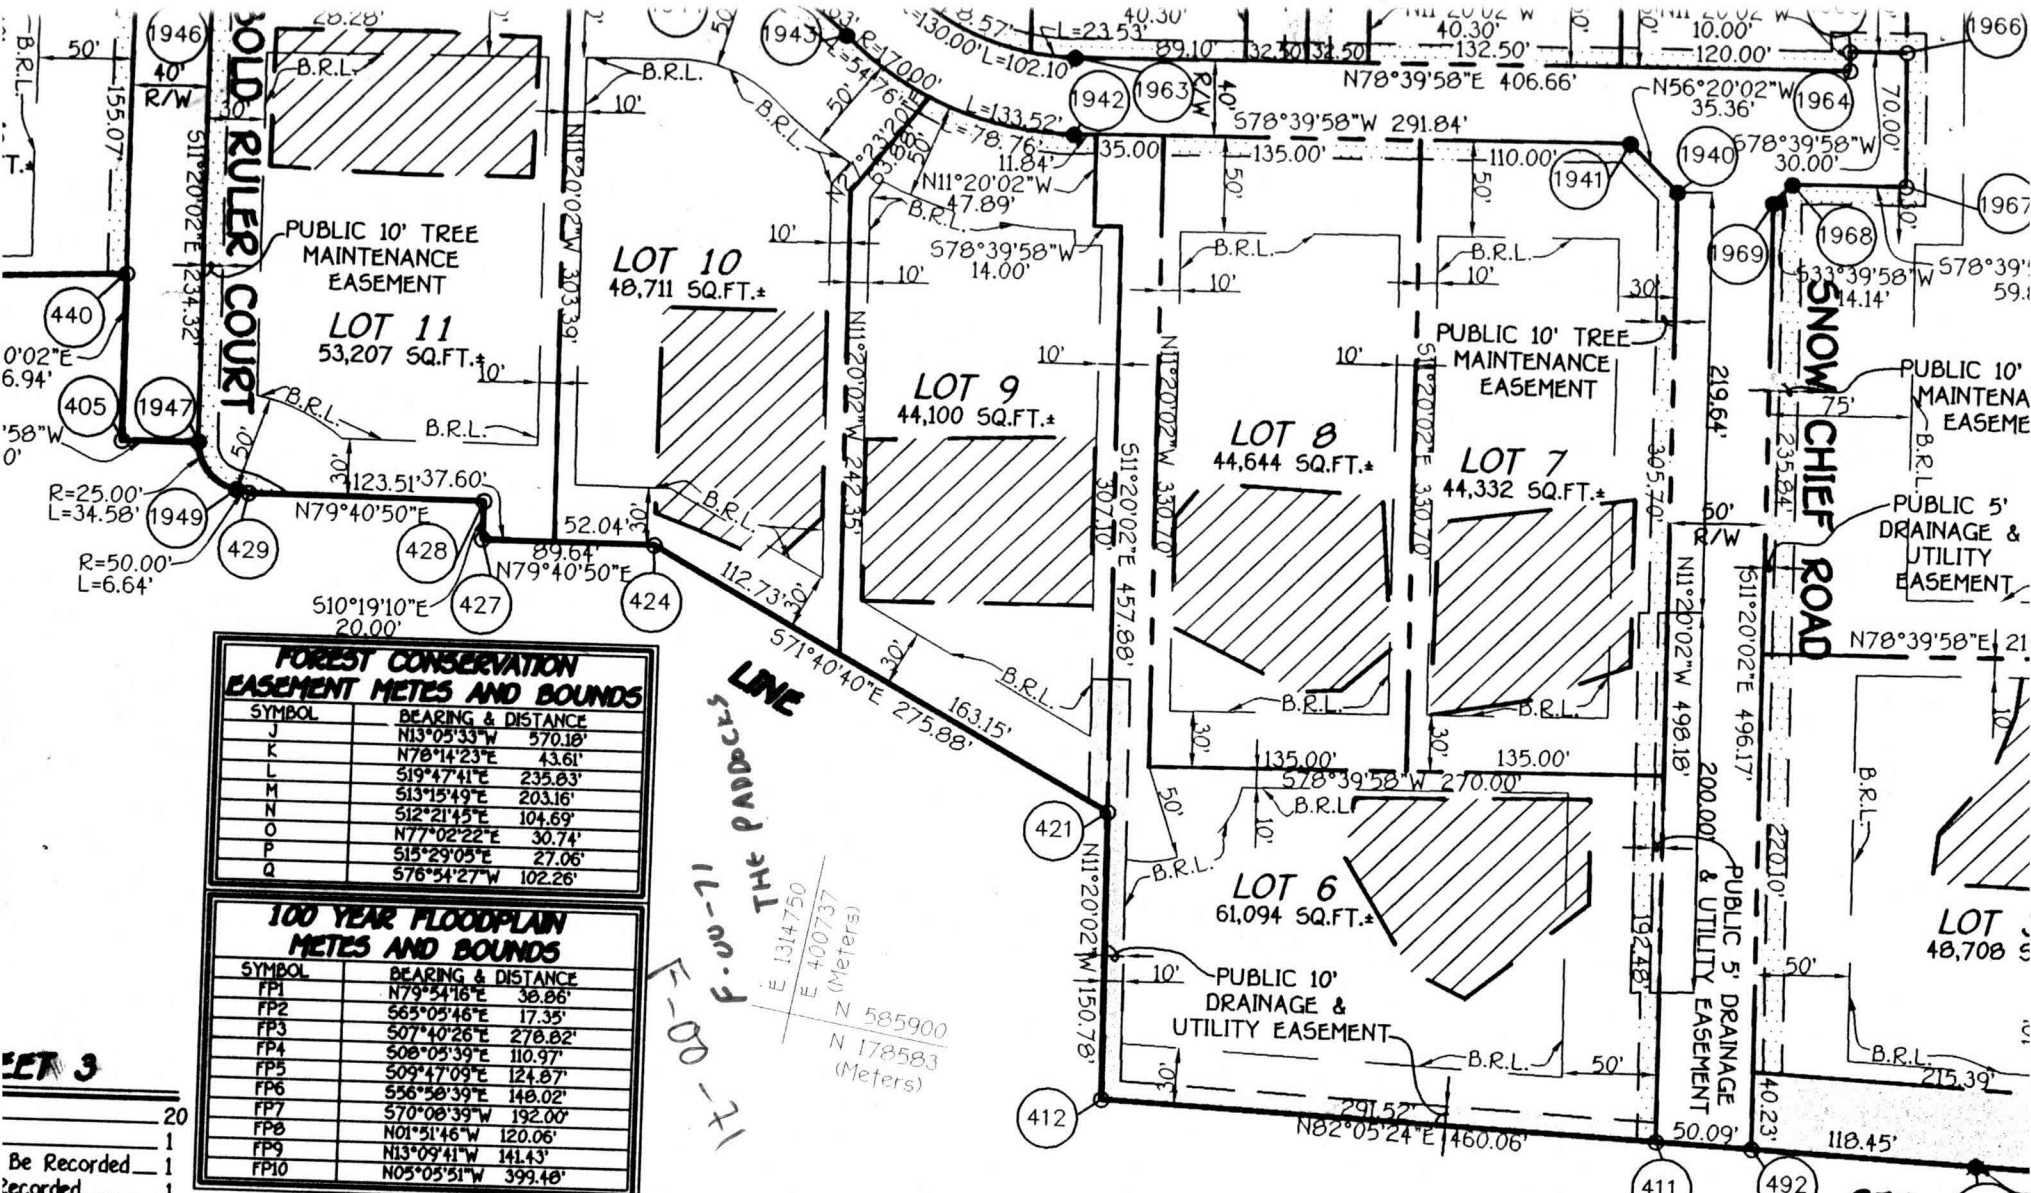

SET 3  
 20  
 1  
 Be Recorded 1  
 Recorded 1  
 23

- 21.711 Ac.±
- 1.996 Ac.±
- 3.126 Ac.±
- 16.967 Ac.
- 43.800 Ac.±
- 4.401 Ac.±
- 48.201 Ac.±

**Reservation Of Public Utility And Forest Conservation Easements**

\*Developer Reserves Unto Itself, Its Successors And Assigns, All Easements Shown On This Plan For Water, Sewer, Storm Drainage, Other Public Utilities And Forest Conservation (Designated As "Forest Conservation Area"), Located In, On, Over, And Through Lots 1 Through 33 And Parcels 'A' And 'B'. Any Conveyances Of The Aforesaid Lots Shall Be Subject To The Easements Herein Reserved, Whether Or Not Expressly Stated In The Deed(s) Conveying Said Lots(s). Developer Shall Execute And Deliver Deeds For The Easements Herein Reserved, With A Metes And Bounds Description Of The Forest Conservation Area. Upon Completion Of The Public Utilities And Their Acceptance By Howard County, With A Metes And Bounds Description Of The Forest Conservation Area, Upon Completion Of The Developer's Obligations Under The Forest Conservation Installation And Maintenance Agreement Executed By Developer And The County, And The Release Of Developer's Surety Posted With Said Agreement, The County Shall Accept The Easements And Record The Deed(s) Of Easement In The Land Records Of Howard County."

**OWNER'S CERTIFICATE**


Pulte Home Corporation, A Michigan Corporation, By John E. Bittner, President And Gretchen Moberley Owners Of The Property Shown And Described Hereon, Hereby Adopt This Plan Of Subdivision And In Consideration Of The Final Plat...

I Hereby Certif

PROJ  
 ANITA F  
 MARTHA L.  
 AND BEI  
 LIBER 65

ChD2

2'

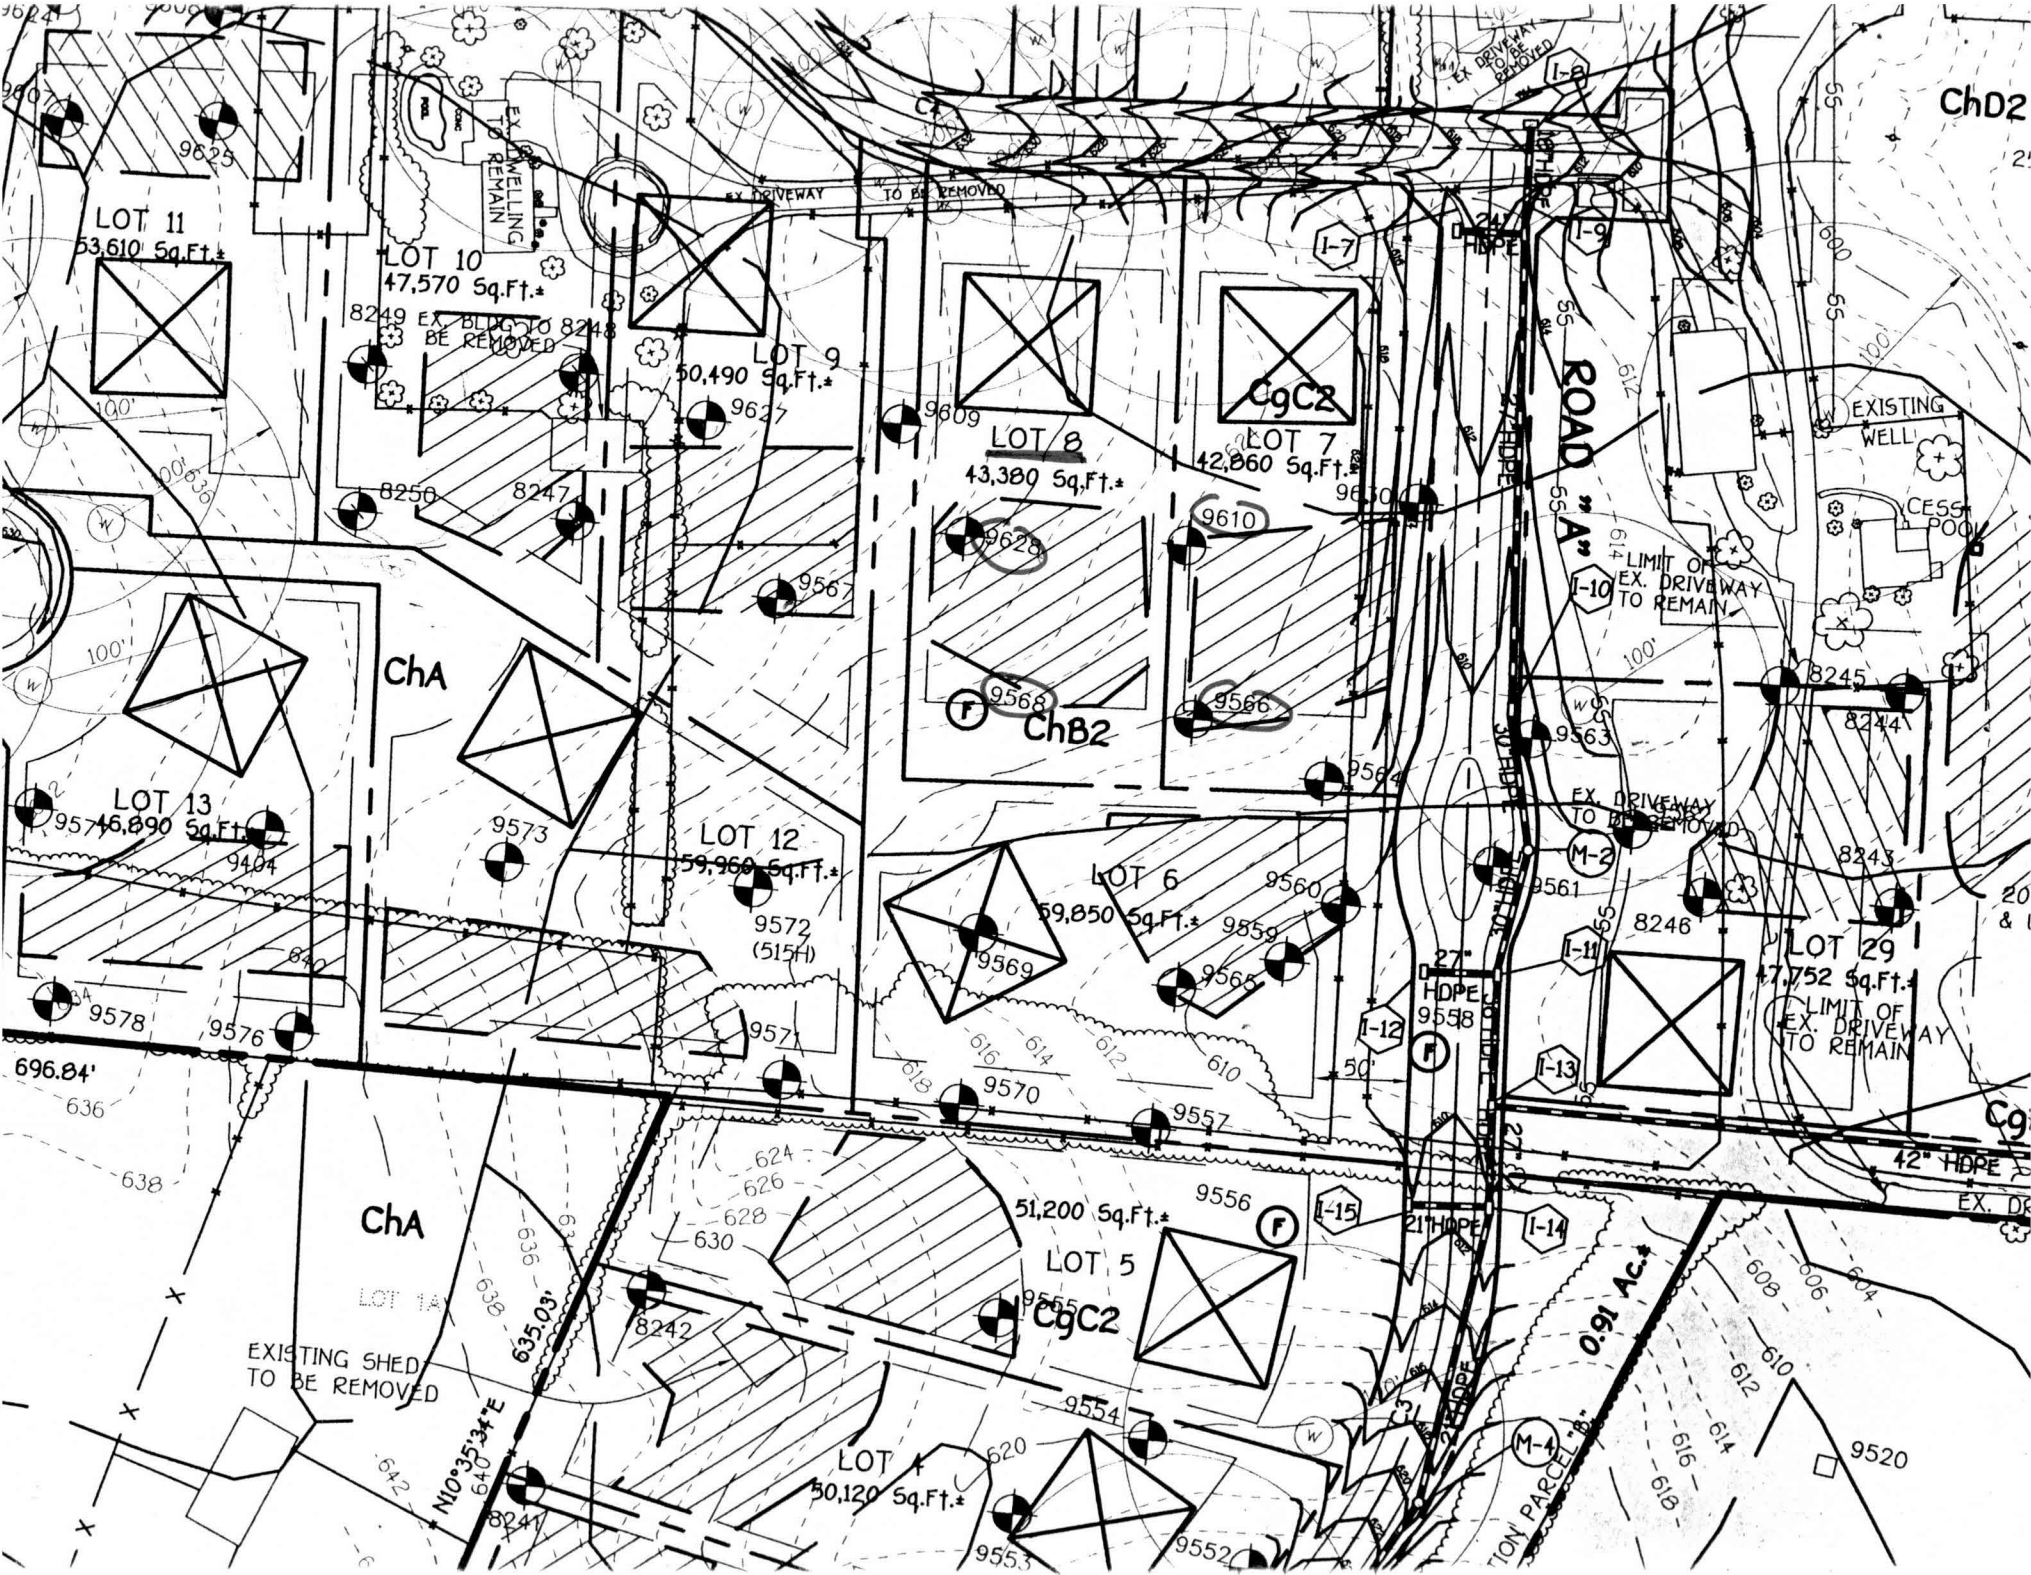

LOT 11  
53,610 Sq.Ft.\*

LOT 10  
47,570 Sq.Ft.\*

LOT 9  
50,490 Sq.Ft.\*

LOT 8  
43,380 Sq.Ft.\*

LOT 7  
42,860 Sq.Ft.\*

LOT 12  
59,960 Sq.Ft.\*

LOT 6  
59,850 Sq.Ft.\*

LOT 5  
51,200 Sq.Ft.\*

LOT 4  
50,120 Sq.Ft.\*

LOT 29  
7,752 Sq.Ft.\*

ChA

ChB2

ChA

CgC2

CgC2

Cg

ROAD "A"

0.91 Ac.\*

EXISTING SHED  
TO BE REMOVED

EXISTING WELL  
TO REMAIN

EX. BLDG. TO  
BE REMOVED

LIMIT OF  
EX. DRIVEWAY  
TO REMAIN

LIMIT OF  
EX. DRIVEWAY  
TO REMAIN

TON PARCEL

EXISTING  
WELL

CESS  
POOL

HOPE

EX. DRIVEWAY  
TO BE REMOVED

EX. DR

20  
& 1

9624

9607

9600

9583

9566

9549

9532

9515

9498

9481

9464

9447

9625

8249

8250

8247

9627

9809

9628

956

9568

9610

9566

9600

9564

9563

9563

9561

9561

8245

8244

8243

8246

8246

