

01/18/01
CO. PH
2/19/02

ISSUE DATE: 6/6/2001

PERMIT

P 515276

APPROVAL DATE: 7/6/01

A 59868

ON-SITE SEWAGE DISPOSAL SYSTEM HOWARD COUNTY HEALTH DEPARTMENT BUREAU OF ENVIRONMENTAL HEALTH

03-333132

INDEXED

Fogle's Septic Clean, Inc. IS PERMITTED TO INSTALL ALTER

ADDRESS: 580 Obrecht Road, Sykesville 21784 PHONE NUMBER: 410-795-5670

SUBDIVISION: The Paddocks LOT NUMBER: 8

ADDRESS: 13705 Bold Venture Drive PROPERTY OWNER: Pulte Home Corp.

**BUILDING PERMIT SIGNED
AND RETURNED**

SEPTIC TANK CAPACITY (GALLONS): 1250

PUMP CHAMBER CAPACITY (GALLONS): N/A

7-10-03 800142969-DECK

NUMBER OF BEDROOMS: 4

SQUARE FEET PER BEDROOM: 210

LINEAR FEET OF TRENCH REQUIRED: 280

| | |
|-----------|---|
| TRENCHES: | Trench to be 3.0 feet wide. Inlet 3.5 feet below original grade. Bottom maximum depth 5.5 feet below original grade. Effective area begins at 3.5 feet below original grade. 2.0 feet of stone below distribution pipe. |
| LOCATION: | Place the distribution box 165 feet down the left lot line and 40 feet off the left lot line. Run 4 trenches on contour within the designated sewage disposal area. |
| NOTES: | |

PLANS APPROVED: Mark Rifkin 4/12/01 OK (BB) DATE: 4-3-01

- NOTE: PERMIT VOID AFTER 2 YEARS
- NOTE: CONTRACTOR RESPONSIBLE FOR SCHEDULING A PRE-CONSTRUCTION INSPECTION FOR ALL INSTALLATIONS
- NOTE: WATERTIGHT SEPTIC TANKS REQUIRED
- NOTE: ALL PARTS OF SEPTIC SYSTEM SHALL BE 100 FEET FROM ANY WATER WELL
- NOTE: MANHOLE RISERS REQUIRED ON ALL SEPTIC TANKS AND PUMP CHAMBERS


**NEITHER THE HOWARD COUNTY COUNCIL NOR THE HEALTH DEPARTMENT IS
RESPONSIBLE FOR THE SUCCESSFUL OPERATION OF ANY SYSTEM
PERMITTEE RESPONSIBLE FOR OBTAINING FINAL APPROVAL ON THIS PERMIT
CALL 410-313-2640 FOR INSPECTION OF SEPTIC SYSTEM**

**BUILDING PERMIT SIGNED
AND RETURNED**

-1206 800157706 - FINISH BASEMENT

PS 515276

NOT TO SCALE

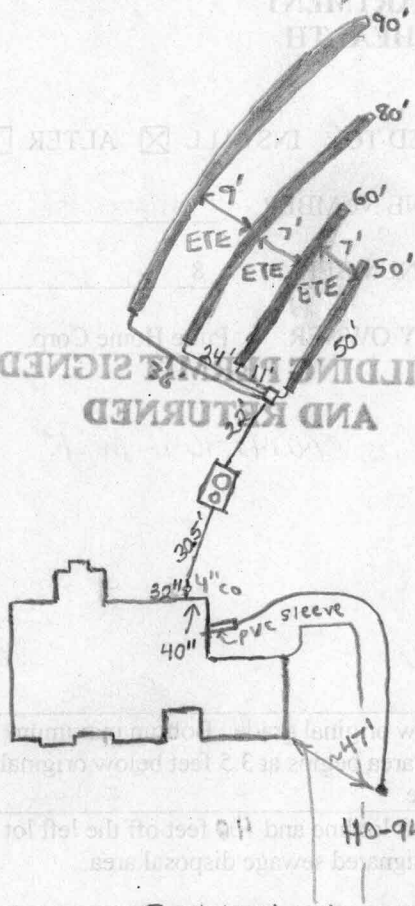

TRENCH DATA

TRENCH WIDTH 3'
 TRENCH INLET DEPTH 3.5'
 TRENCH BOTTOM DEPTH 5.5'
 DEPTH OF STONE 2'
 NUMBER OF TRENCHES 4
 TOTAL TRENCH LENGTH 280'
 ABSORBENT AREA 840ft²
 DISTRIBUTION BOX LEVEL
 BAFFLE IN DISTRIBUTION BOX

SEPTIC TANK DATA

SEPTIC TANK 1250 TS GALLONS
 MANHOLE RISER on center
 6 INCH INSPECTION PORT on front

PUMP CHAMBER DATA

PUMP CHAMBER GALLONS NA
 MANHOLE RISER NA
 ALARM NA
 PUMP PERFORMANCE TEST NA

Bold Venture Drive

PRE-CONSTRUCTION INSPECTION: 6/15/01 O.K. to install top trench 6" deeper, to try to

keep house connection 18" below grade. Builder to have plumber lower existing

INSPECTION COMMENTS: connection 6". (BB) 6/18/01 50 and 60 foot trenches done.

Need house connection. (BB) 6/19/01 - SYSTEM COMPLETE PENDING HOUSE CONN. (SRV)

7/6/01 House connection done. (BB)

INSPECTOR B. Baber DATE SYSTEM APPROVED 7/6/01