

APPLICATION

PERCOLATION TESTING

A _____

P _____

HOWARD COUNTY HEALTH DEPARTMENT
BUREAU OF ENVIRONMENTAL HEALTH
3525-H ELLICOTT MILLS DRIVE/ELLICOTT CITY, MARYLAND 21043
TELEPHONE: 313-2640

DISTRICT _____

DATE 3/9/98

TO: THE COUNTY HEALTH OFFICER
ELLICOTT CITY, MARYLAND

I HEREBY APPLY FOR THE NECESSARY TEST PRIOR TO APPLICATION FOR PERMIT TO CONSTRUCT (OR RECONSTRUCT) A SEWAGE DISPOSAL SYSTEM.

PROPERTY OWNER _____

ADDRESS _____ PHONE _____

AGENT OR PROSPECTIVE BUYER WINCHESTER HOMES INC. c/o Mr. KEITH KUBISTA

ADDRESS 6305 IVY LANE SUITE 800 PHONE (301) 489-1120
GREENBELT MD. 20770

PROPERTY LOCATION:

SUBDIVISION MOBBERLY PROPERTY LOT NO. 12¹¹

ROAD AND DESCRIPTION BURNT WOODS ROAD

TAX MAP 22 PARCEL # 141, 2, 234 & 530

SIZE OF LOT 1 AC. CLUSTER TYPE BLDG. S.F.D.
(SINGLE FAMILY DWELLING OR COMMERCIAL)

THE SYSTEM INSTALLED UNDER THIS APPLICATION IS ACCEPTABLE ONLY UNTIL PUBLIC FACILITIES BECOME AVAILABLE. I FULLY UNDERSTAND THE FEE CONNECTED WITH THE FILING OF THIS PERC TEST APPLICATION IS NON-REFUNDABLE UNDER ANY CIRCUMSTANCES. I ALSO AGREE TO COMPLY WITH ALL M.O.S.H.A. REQUIREMENTS IN TESTING THIS LOT. Zacharia Y. Fisch
(SIGNATURE OF APPLICANT)

APPROVED BY _____ FOR _____ DATE _____

DISAPPROVED BY _____ FOR _____ DATE _____

HOLD PENDING FURTHER TESTS _____

REASONS FOR REJECTION OR HOLDING _____

PERCOLATION TEST PLAT/PRELIMINARY PLAT - TITLE OR I.D. # _____ DATE _____

SITE DEVELOPMENT PLAN/FINAL PLAT - TITLE OR I.D. # _____ DATE _____

THIS IS NOT A PERMIT

COUNTY #


SOIL PROFILE

0'

Empty vertical box for soil profile data.

Empty vertical box for soil profile data.

Empty vertical box for soil profile data.

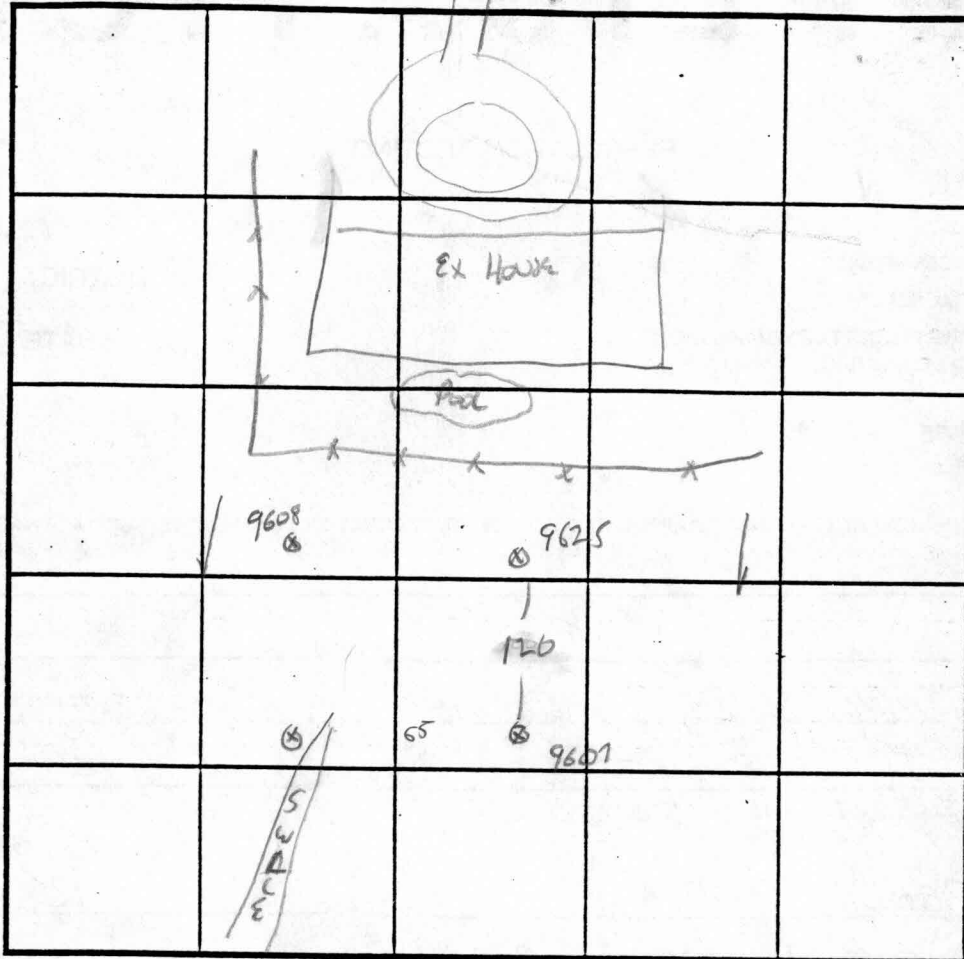

SOIL PROFILE

0'

9607

TOPSOIL

STRONG BR LOAM 18"

TANISH GRAY SIL

20% FIRM PARENT MATERIAL

SOME BLACK STAINING BELOW 7"

14

INDICATE NORTH - NAME ADJOINING ROADWAY AS BASE LINE.

12

DATE	TEST NO.	DEPTH	PRE-WET		TEST - 1" DROP		TIME
			START	STOP	START	STOP	
5/13/78	9607	4/14	2:56	2:58	→	3:03	5 MIN
	9624	4.5/13	3:05	3:07	→	3:12	5 MIN
	9625	4.5/14	11	OK	SEE LOG 4		OK
	9608	14V					OK

REMARKS _____


TYPE OF SOIL _____

TESTED BY G. SAVAGE ALSO PRESENT _____

TRENCH DESIGN DATA: AVERAGE PERCOLATION TIME _____ TRENCH WIDTH _____

INLET DEPTH _____ MAXIMUM BOTTOM DEPTH _____ SQ. FT./BEDROOM _____

FOR
BENEFIT
27.1
AGREEM
AMON
RECORD
COUN

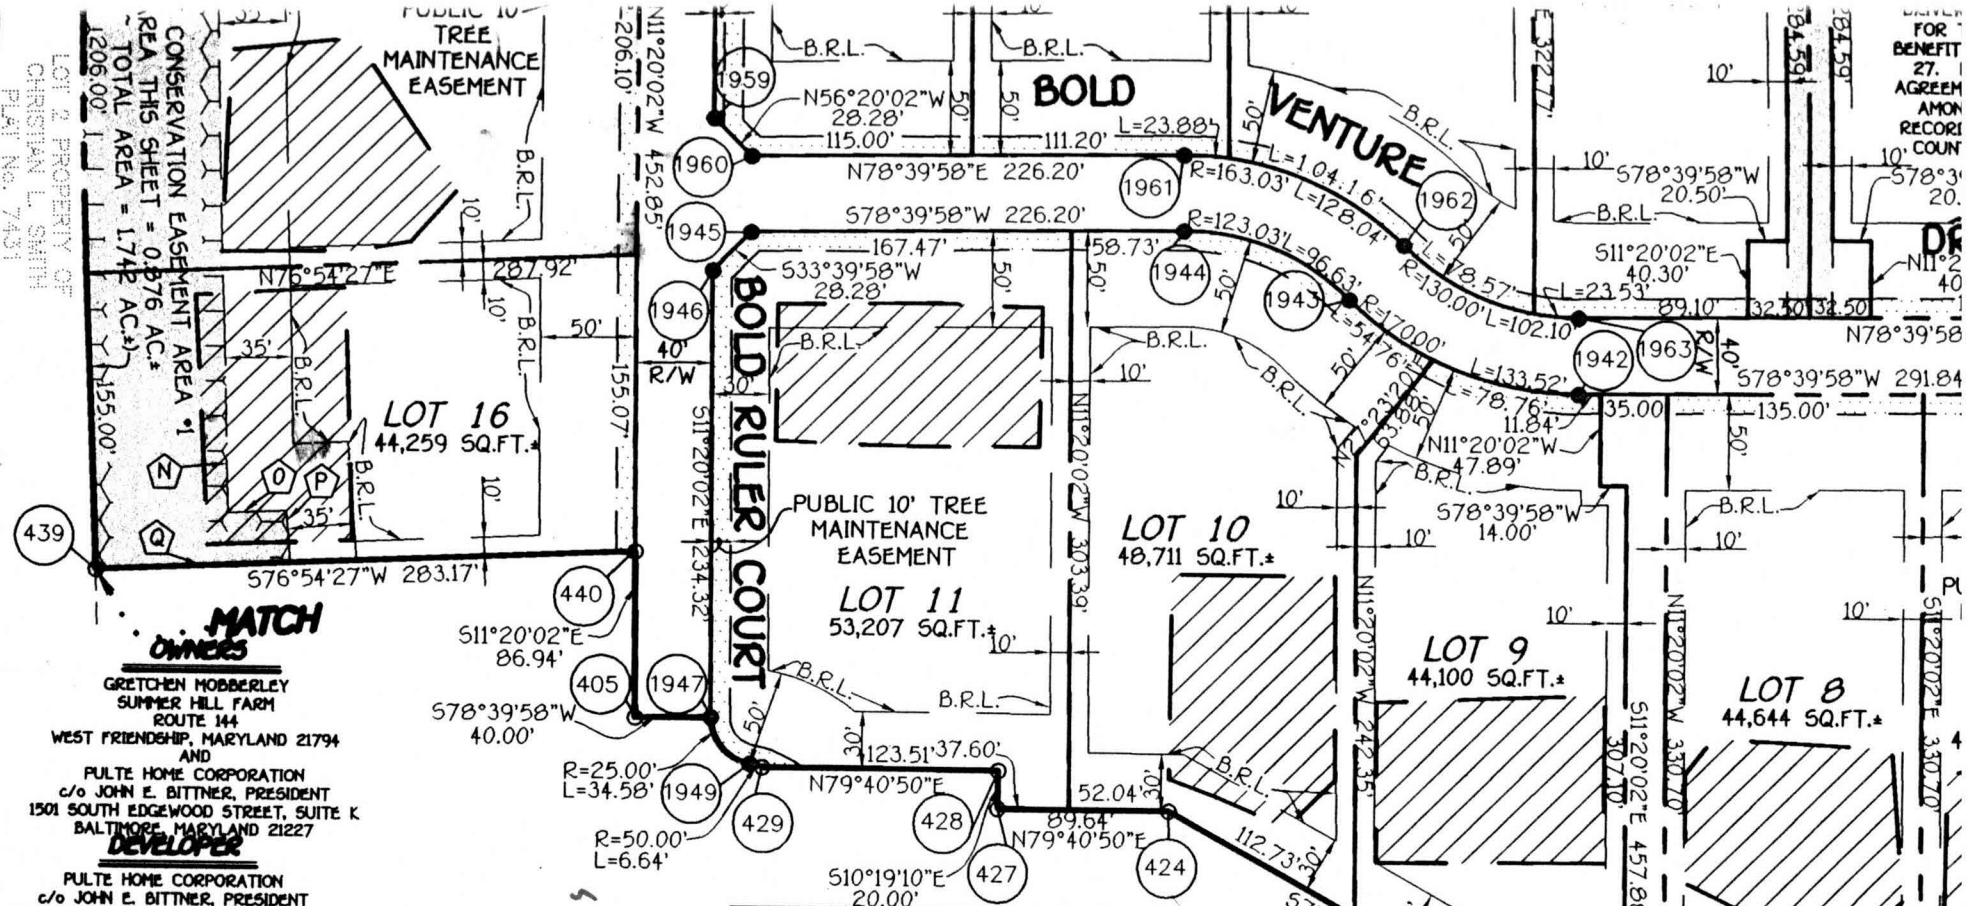

MATCH OWNERS

GRETCHEN MOBBERLEY
SUMMER HILL FARM
ROUTE 144
WEST FRIENDSHIP, MARYLAND 21794
AND
PULTE HOME CORPORATION
c/o JOHN E. BITTNER, PRESIDENT
1501 SOUTH EDGEWOOD STREET, SUITE K
BALTIMORE, MARYLAND 21227

DEVELOPER

PULTE HOME CORPORATION
c/o JOHN E. BITTNER, PRESIDENT
1501 SOUTH EDGEWOOD STREET, SUITE K
BALTIMORE, MARYLAND 21227

The Requirements §3-106, The Real Property Article, Annotated Code of Maryland, 1986 Replacement Volume, (As Supplemented As Far As They Relate To The Making Of This Plat And The Setting Of Markers Have Been Complied With

Terrell A. Fisher 4/27/2020
TERRELL A. FISHER, L.S. #10692 DATE
REGISTERED LAND SURVEYOR

Gretchen Mobberley 6/22/08
GRETCHEN MOBBERLEY DATE
(OWNER)

John E. Bittner 6/20/00
PULTE HOME CORPORATION DATE
BY: JOHN E. BITTNER, PRESIDENT
(OWNER)

FOREST CONSERVATION EASEMENT METES AND BOUNDS

SYMBOL	BEARING & DISTANCE
J	N13°05'33"W 570.18'
K	N78°14'23"E 43.61'
L	S19°47'41"E 235.83'
M	S13°15'49"E 203.16'
N	S12°21'45"E 104.69'
O	N77°02'22"E 30.74'
P	S15°29'05"E 27.06'
Q	S76°54'27"W 102.26'

100 YEAR FLOODPLAIN METES AND BOUNDS

SYMBOL	BEARING & DISTANCE
FP1	N79°54'16"E 36.86'
FP2	S65°05'46"E 17.35'
FP3	S07°40'26"E 278.82'
FP4	S08°05'39"E 110.97'
FP5	S09°47'09"E 124.87'
FP6	S56°58'39"E 148.02'
FP7	S70°08'39"W 192.00'
FP8	N01°51'46"W 120.06'
FP9	N13°09'41"W 141.43'
FP10	N05°05'51"W 399.48'

AREA TABULATION FOR SHEET 3

Total Number Of Buildable Lots To Be Recorded	20
Total Number Of Open Space Lots To Be Recorded	1
Total Number Of Non-Buildable Preservation Parcels To Be Recorded	1
Total Number Of Buildable Preservation Parcels To Be Recorded	1
Total Number Of Lots And Parcels To Be Recorded	23
Total Area Of Buildable Lots To Be Recorded	21.711 Ac.*
Total Area Of Open Space Lots To Be Recorded	1.996 Ac.*
Total Area Of Non-Buildable Parcels To Be Recorded	1.742 Ac.*

Reservation Of Public Utility And Forest Conservation Easement

*Developer Reserves Unto Itself, Its Successors And Assigns, All Easements Shown On This Plan For Water, Sewer Utilities And Forest Conservation (Designated As "Forest Conservation Area"). Located In, On, Over, And Through Lot And "B", Any Conveyances Of The Aforesaid Lots Shall Be Subject To The Easements Herein Reserved.