

APPLICATION

PERCOLATION TESTING

A _____

P _____

HOWARD COUNTY HEALTH DEPARTMENT
BUREAU OF ENVIRONMENTAL HEALTH
3525-H ELLICOTT MILLS DRIVE/ELLICOTT CITY, MARYLAND 21043
TELEPHONE: 313-2840

DISTRICT _____

DATE 3/9/98

TO: THE COUNTY HEALTH OFFICER
ELLICOTT CITY, MARYLAND

I HEREBY APPLY FOR THE NECESSARY TEST PRIOR TO APPLICATION FOR PERMIT TO CONSTRUCT (OR RECONSTRUCT) A SEWAGE DISPOSAL SYSTEM.

PROPERTY OWNER _____

ADDRESS _____ PHONE _____

AGENT OR PROSPECTIVE BUYER WINCHESTER HOMES INC. c/o Mr. KEITH KUBISTA

ADDRESS 6305 IVY LANE SUITE 800 PHONE (301) 489-1120
GREENBELT MD. 20770

PROPERTY LOCATION:

SUBDIVISION MOBBERLY PROPERTY LOT NO. 2124

ROAD AND DESCRIPTION BURNT WOODS ROAD

TAX MAP 22 PARCEL # 141, 2, 234 & 530

SIZE OF LOT 1 AC. CLUSTER TYPE BLDG. S.F.D.
(SINGLE FAMILY DWELLING OR COMMERCIAL)

THE SYSTEM INSTALLED UNDER THIS APPLICATION IS ACCEPTABLE ONLY UNTIL PUBLIC FACILITIES BECOME AVAILABLE. I FULLY UNDERSTAND THE FEE CONNECTED WITH THE FILING OF THIS PERC TEST APPLICATION IS NON-REFUNDABLE UNDER ANY CIRCUMSTANCES. I ALSO AGREE TO COMPLY WITH ALL M.O.S.H.A. REQUIREMENTS IN TESTING THIS LOT. Zacharia Y. Fisch
(SIGNATURE OF APPLICANT)

APPROVED BY _____ FOR _____ DATE _____

DISAPPROVED BY _____ FOR _____ DATE _____

HOLD PENDING FURTHER TESTS _____

REASONS FOR REJECTION OR HOLDING _____

PERCOLATION TEST PLAT/PRELIMINARY PLAT - TITLE OR I.D. # _____ DATE _____

SITE DEVELOPMENT PLAN/FINAL PLAT - TITLE OR I.D. # _____ DATE _____

THIS IS NOT A PERMIT


COUNTY #

SOIL PROFILE

0' [Empty box for soil profile]

[Empty box for soil profile]

[Empty box for soil profile]

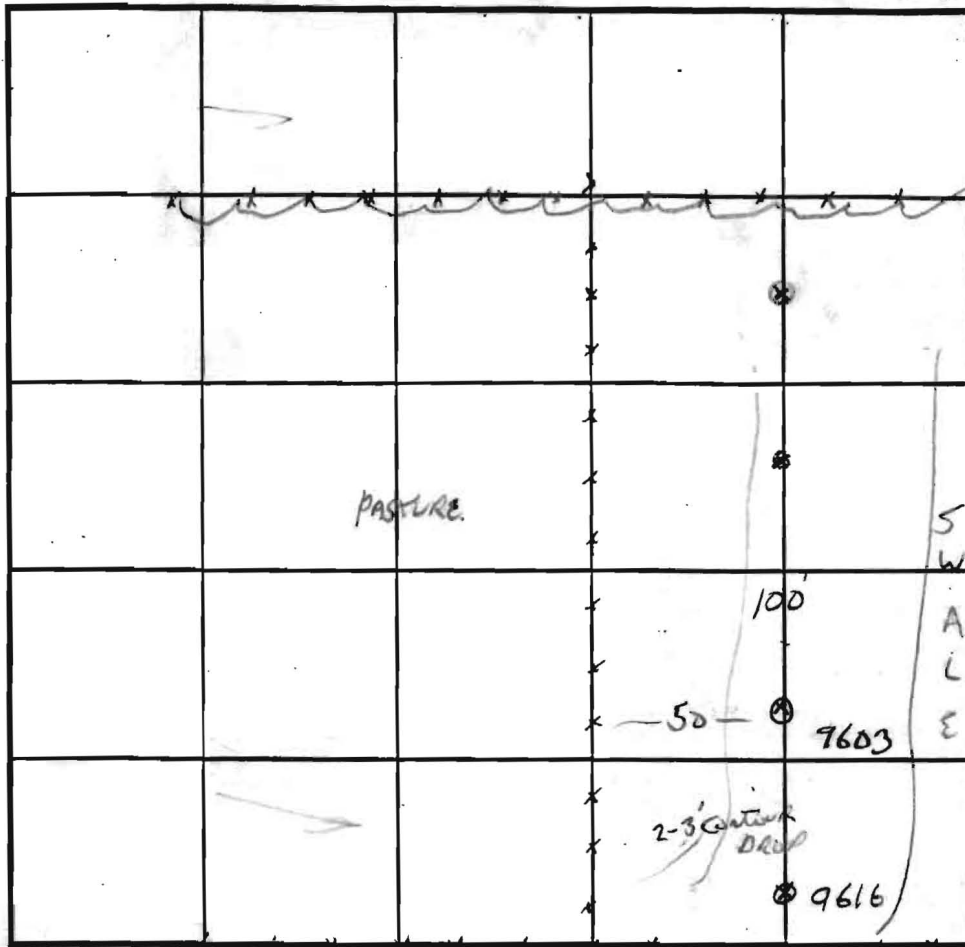

INDICATE NORTH - NAME ADJOINING ROADWAY AS BASE LINE.

SOIL PROFILE TYPICAL

9603

BROWN
LOAM

2.5
LIGHT BR
SL
MICACEOUS

20%
LOOSE
ROCK
Below 6'
VERY
DRY

12

COT 27

DATE	TEST NO.	DEPTH	PRE-WET		TEST - 1" DROP		TIME
			START	STOP	START	STOP	
5/14/99	9603	4/12	12:13	12:14	→	12:15 ⁴⁵	1:45 ok
	*9616	4.5/13	12:19	12:20	→	12:21	1:11W
	9604	3/14	1:29	1:31	→	1:34	3:11W
	9618	3/13V					ok

REMARKS HOUSE DEPTH TEST

TYPE OF SOIL _____

TESTED BY G. SAUVAGE ALSO PRESENT Fyock's crew

TRENCH DESIGN DATA: AVERAGE PERCOLATION TIME _____ TRENCH WIDTH _____

INLET DEPTH _____ MAXIMUM BOTTOM DEPTH _____ SQ. FT./BEDROOM _____

APPLICATION

PERCOLATION TESTING

A 59868

P _____

HOWARD COUNTY HEALTH DEPARTMENT
BUREAU OF ENVIRONMENTAL HEALTH
3525-H ELLICOTT MILLS DRIVE/ELLICOTT CITY, MARYLAND 21043
TELEPHONE: 313-2840

DISTRICT _____

DATE 3/9/98

TO: THE COUNTY HEALTH OFFICER
ELLICOTT CITY, MARYLAND

I HEREBY APPLY FOR THE NECESSARY TEST PRIOR TO APPLICATION FOR PERMIT TO CONSTRUCT (OR RECONSTRUCT) A SEWAGE DISPOSAL SYSTEM.

PROPERTY OWNER _____

ADDRESS _____ PHONE _____

AGENT OR PROSPECTIVE BUYER WINCHESTER HOMES INC. 5/6 MI. KEITH KUBISTA

ADDRESS 6305 IVY LANE SUITE 800 PHONE (301) 489-1120
GREENBELT MD. 20770

PROPERTY LOCATION:

SUBDIVISION MOBBERLY PROPERTY LOT NO. 1524

ROAD AND DESCRIPTION BURNT WOODS ROAD

TAX MAP 22 PARCEL # 141, 2, 234 & 530

SIZE OF LOT 1 AC. CLUSTER TYPE BLDG. S.F.D.
(SINGLE FAMILY DWELLING OR COMMERCIAL)

THE SYSTEM INSTALLED UNDER THIS APPLICATION IS ACCEPTABLE ONLY UNTIL PUBLIC FACILITIES BECOME AVAILABLE. I FULLY UNDERSTAND THE FEE CONNECTED WITH THE FILING OF THIS PERC TEST APPLICATION IS NON-REFUNDABLE UNDER ANY CIRCUMSTANCES. I ALSO AGREE TO COMPLY WITH ALL M.O.S.H.A. REQUIREMENTS IN TESTING THIS LOT.

Zacharia Y. Fisch
(SIGNATURE OF APPLICANT)

APPROVED BY _____ FOR _____ DATE _____

DISAPPROVED BY _____ FOR _____ DATE _____

HOLD PENDING FURTHER TESTS _____

REASONS FOR REJECTION OR HOLDING _____

PERCOLATION TEST PLAT/PRELIMINARY PLAT - TITLE OR I.D. # _____ DATE _____


SITE DEVELOPMENT PLAN/FINAL PLAT - TITLE OR I.D. # _____ DATE _____

THIS IS NOT A PERMIT

A59868
COUNTY#

SOIL PROFILE
8259
0' red brown silclm
3.0' lgt tan orange silclm <5% quartz R_x micaceous very powdery
12.0'

8260
bright orange red silclm
3.5' marble like orange & tan silclm 10% soft saprotic
10.0' lgt tan to grey silclm 20% R_x
11.0'

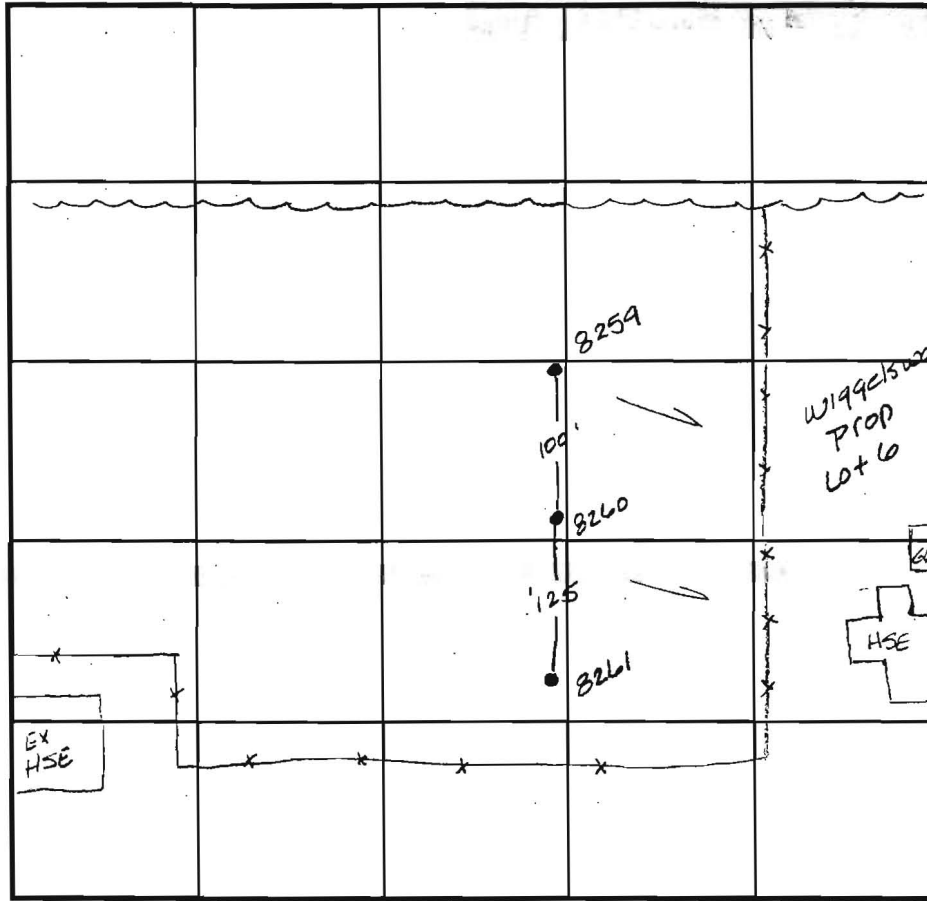


SOIL PROFILE
8261
0' like 8259 visual to 12.0'

INDICATE NORTH - NAME ADJOINING ROADWAY AS BASE LINE.

DATE	TEST NO.	DEPTH	PRE-WET		TEST - 1" DROP		TIME
			START	STOP	START	STOP	
3-18-99	8259	3.5' / 12.0'	12:58	1:03	1:03	1:10	7min
	8260	4.0' / 11.0'	1:06	1:08	1:08	1:12	4min
	8261	4.0' / 11.0'	1:14	1:16	1:16	1:18	2min

REMARKS No evidence of H₂O in any hole
 TYPE OF SOIL _____
 TESTED BY Amy McMillen ALSO PRESENT _____
 TRENCH DESIGN DATA: AVERAGE PERCOLATION TIME _____ TRENCH WIDTH _____
 INLET DEPTH _____ MAXIMUM BOTTOM DEPTH _____ SQ. FT./BEDROOM _____

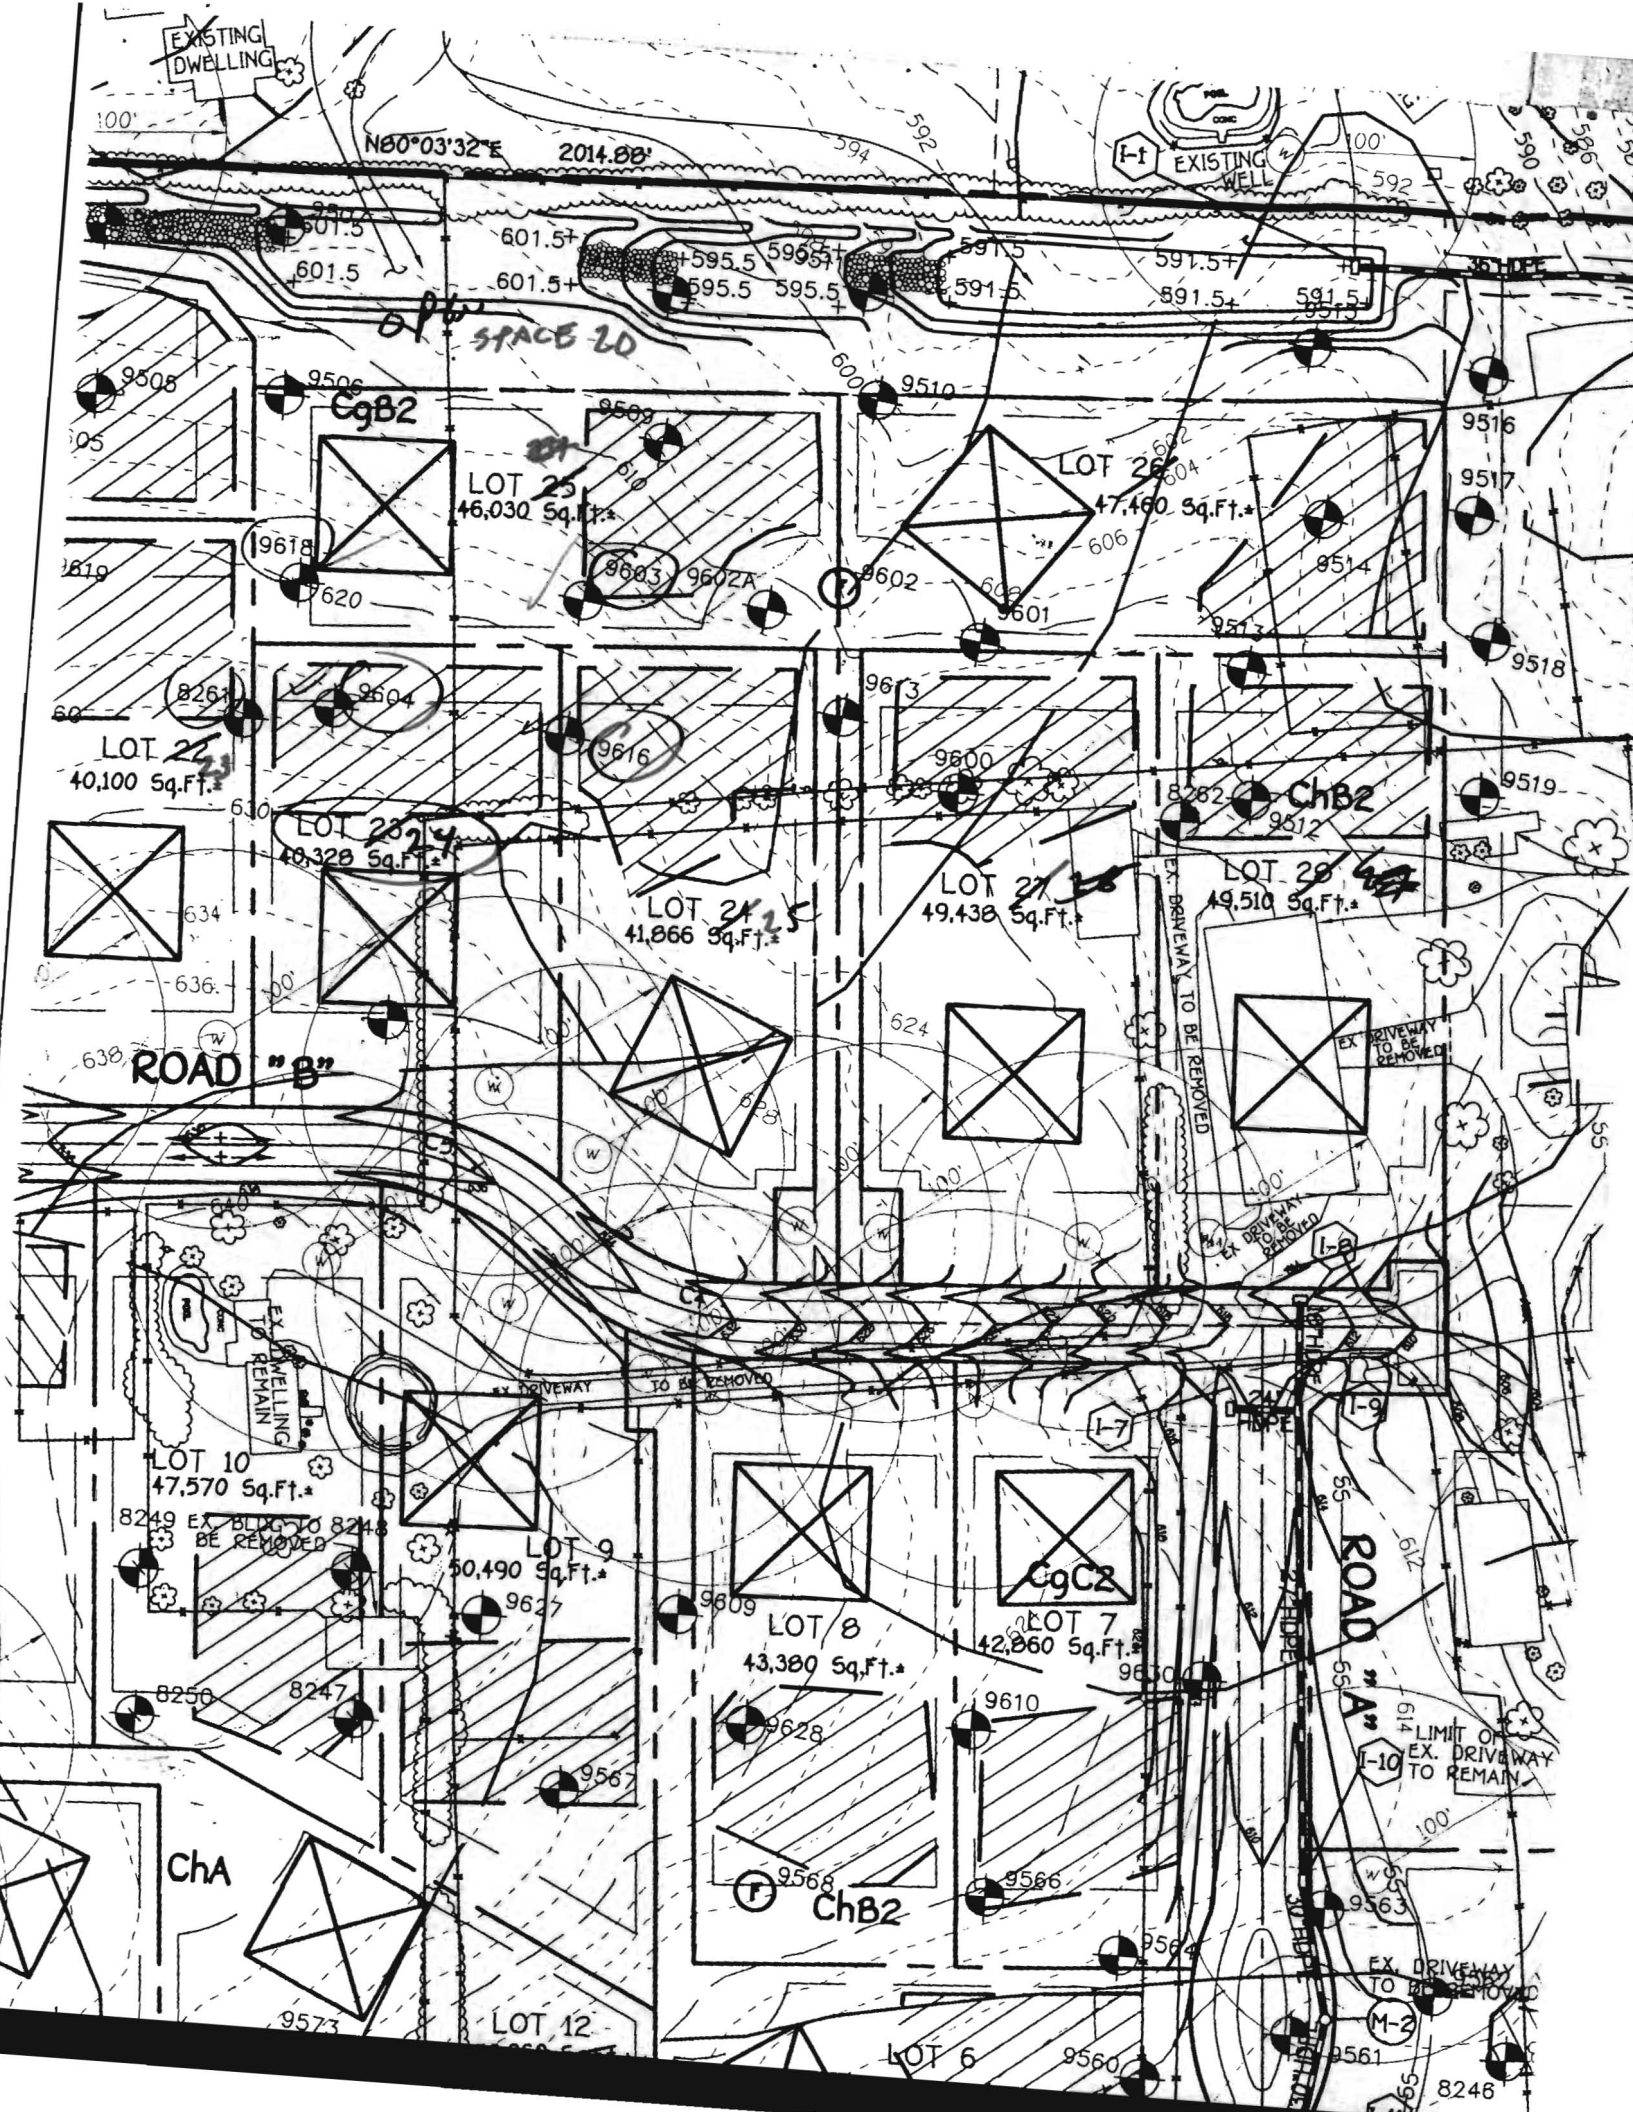

LOT 5
WIGGLESWORTH PROPERTY
PLAT No. 4014

F-00-71 THE PADDOCKS

N80°03'32"E 2055.32'


EXISTING PUE
UTILITY

Lot 20 Owned By The Paddocks
owner's Association, Inc.

955.20'

OPEN SPACE
LOT 20
1.996 AC.*

PRIVATE WATER QUALITY
MANAGEMENT, DRAINAGE,
UTILITY & ACCESS EASEMENT

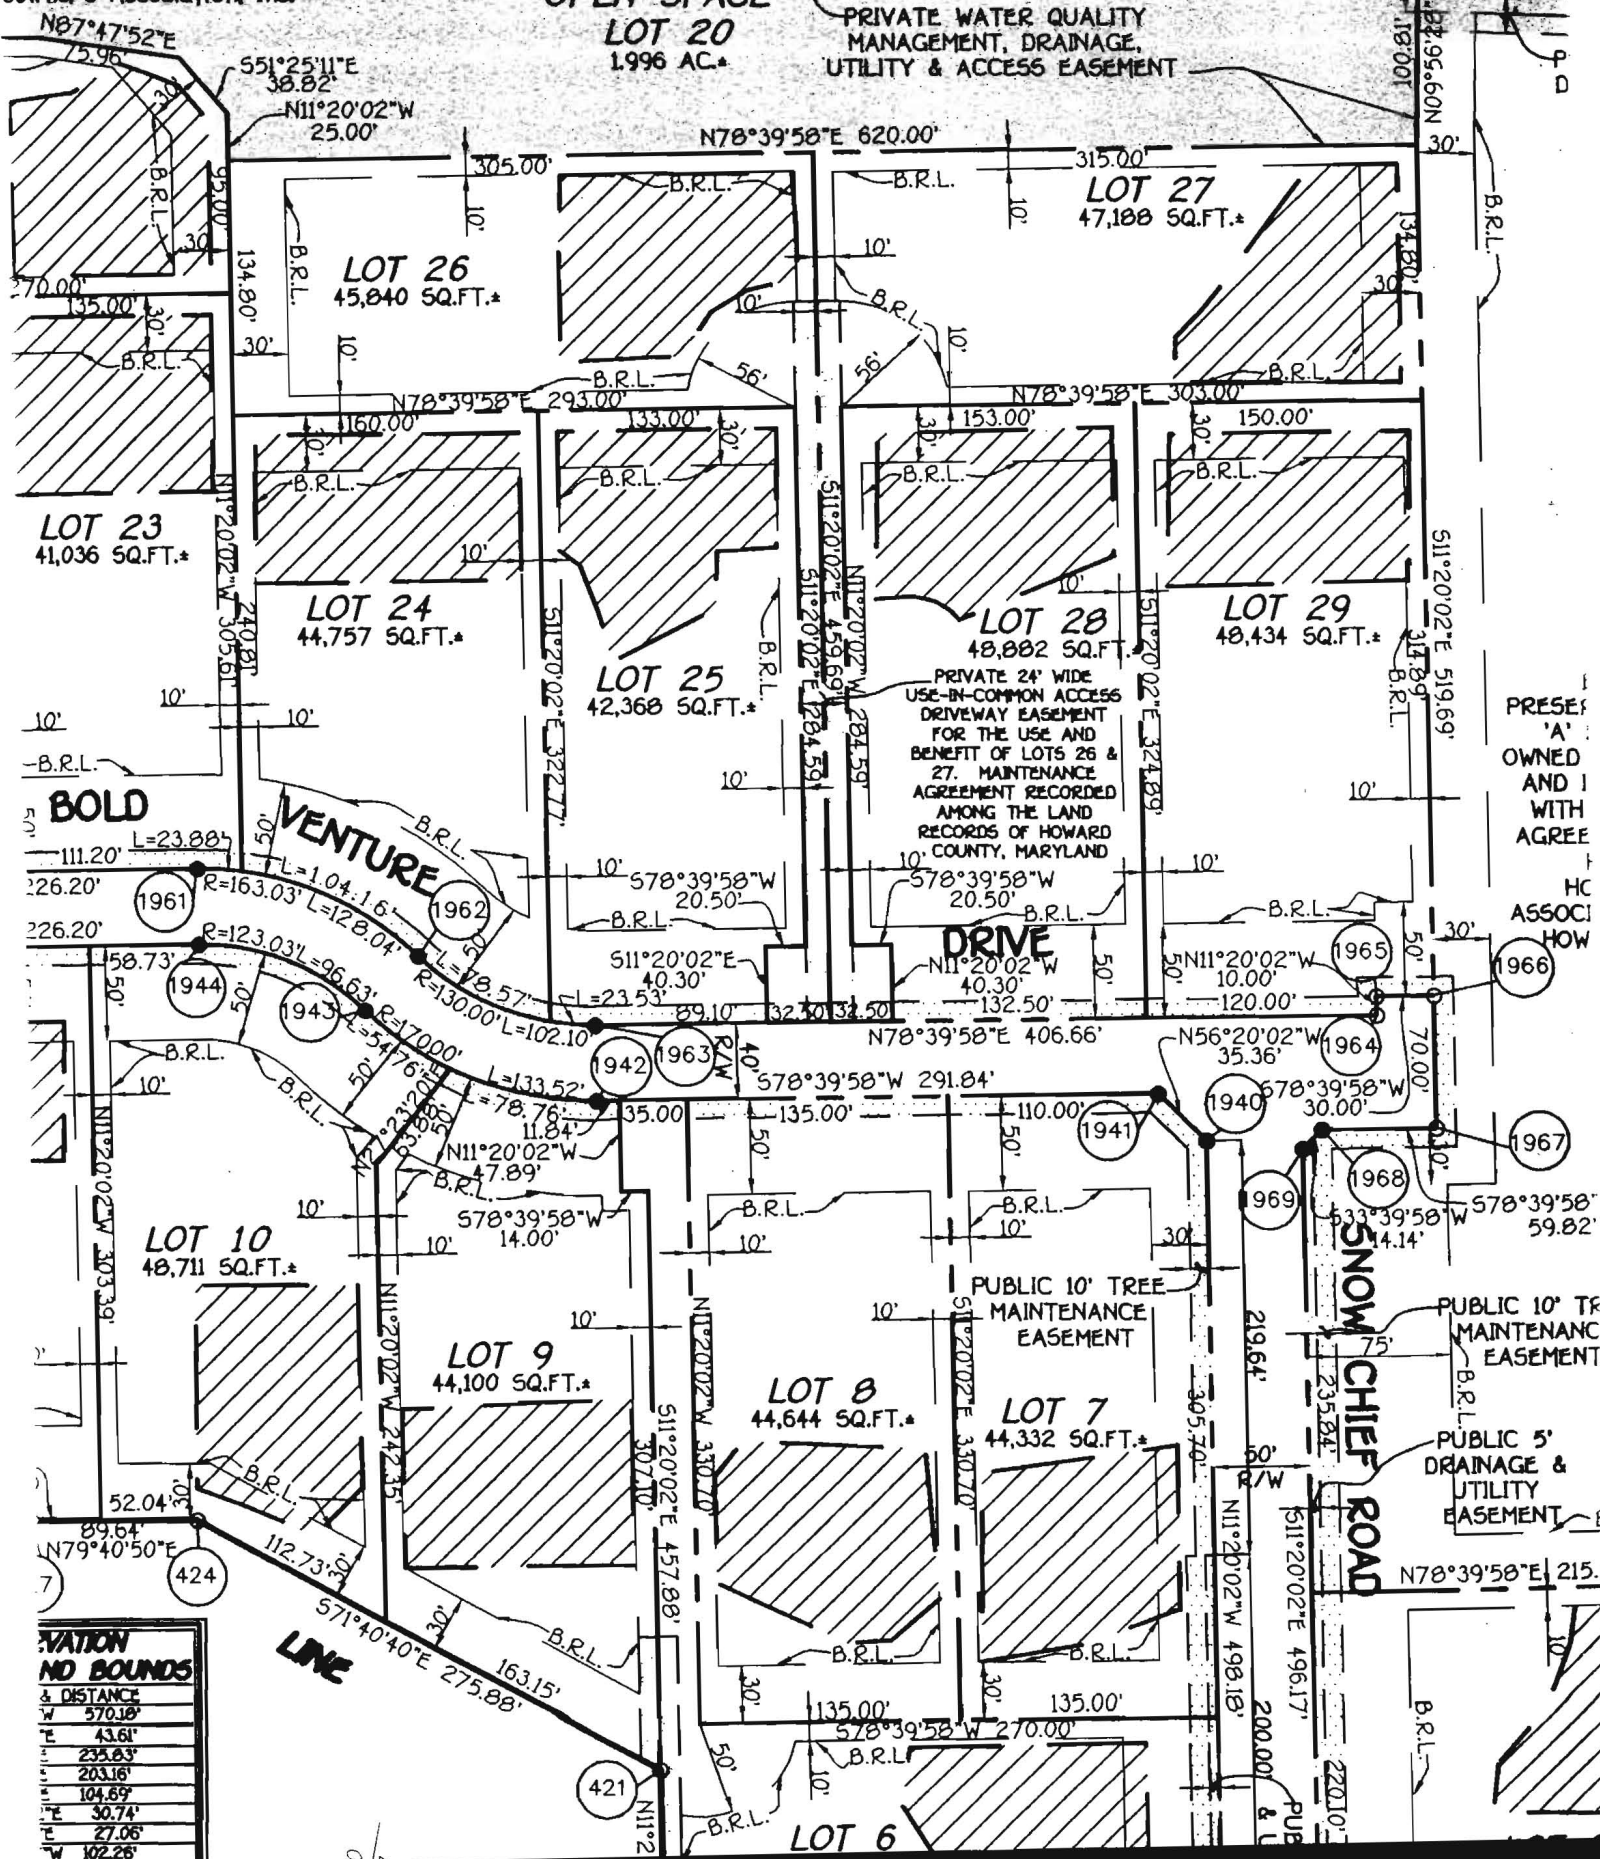

BOLD

VENTURE

DRIVE

SNOW CHIEF ROAD

LINE

VARIATION AND BOUNDS & DISTANCE	
N	570.18'
E	43.61'
S	235.83'
W	203.16'
N	104.69'
E	30.74'
S	27.06'
W	102.26'

PRESENT
OWNED
AND
WITH
AGREEMENT
HC
ASSOCIATION
HOW

PUBLIC 10' TREE
MAINTENANCE
EASEMENT

PUBLIC 10' TREE
MAINTENANCE
EASEMENT

PUBLIC 5'
DRAINAGE &
UTILITY
EASEMENT

LOT 6

LOT 7

LOT 8

LOT 9

LOT 10

LOT 25

LOT 24

LOT 23

LOT 29

LOT 28

LOT 27

LOT 26