

LAYOUT 10/7/03 10 Am INSP 4 _____
 INSP 2 10/14/03 12 INSP 5 _____
 INSP 3 10/21/03 330 INSP 6 _____
 ISSUE DATE: 9/17/03
 APPROVAL DATE: 10/21/03

P 519577
 A 515226

PERMIT
INDEXED
SANDMOUND SYSTEM
ON-SITE SEWAGE DISPOSAL SYSTEM
HOWARD COUNTY HEALTH DEPARTMENT
BUREAU OF ENVIRONMENTAL HEALTH

05-369010

Walter W. King, P & H Contractors IS PERMITTED TO INSTALL ALTER

ADDRESS: 5305 Kings Ct., Frederick Md 21703 PHONE NUMBER: 301-831-4070

SUBDIVISION: Braeburn LOT NUMBER: 27

ADDRESS: 10810 Braeburn Road PROPERTY OWNER: Mitchell D. Saula

SEPTIC TANK CAPACITY (GALLONS): 1250 OUTLET BAFFLE FILTER REQUIRED

PUMP CHAMBER CAPACITY (GALLONS): 1250 COMPARTMENTED TANK REQUIRED

NUMBER OF BEDROOMS: 4

LOCATION:	Install sand mound as shown on the plan.
NOTES:	Both sand mound sites are to be fenced prior to layout inspection.

PLANS APPROVED: John A. Boris DATE: 5/21/03



NOTES: PERMIT VOID AFTER 2 YEARS
 CONTRACTOR IS RESPONSIBLE FOR SCHEDULING A PRE-CONSTRUCTION INSPECTION FOR ALL INSTALLATIONS
 WATERTIGHT SEPTIC TANKS REQUIRED
 ALL PARTS OF SEPTIC SYSTEM SHALL BE 100 FEET FROM ANY WATER WELL UNLESS SPECIFICALLY AUTHORIZED
 MANHOLE RISERS REQUIRED ON ALL SEPTIC TANKS AND PUMP CHAMBERS UNLESS SPECIFICALLY AUTHORIZED
 CONTRACTOR RESPONSIBLE FOR COMPLIANCE WITH APPLICABLE REGULATIONS, GUIDELINES AND THE TERMS OF THIS PERMIT

**NEITHER THE HOWARD COUNTY COUNCIL NOR THE HEALTH DEPARTMENT IS
 RESPONSIBLE FOR THE SUCCESSFUL OPERATION OF ANY SYSTEM
 PERMITTEE RESPONSIBLE FOR OBTAINING FINAL APPROVAL ON THIS PERMIT
 ALL 410-313-2640 FOR INSPECTION OF SEPTIC SYSTEM**

**BUILDING PERMIT SIGNED
 AND RETURNED**

9/30/2003 B00144076 1000 GAL LG PROPANE TANK

NOT TO SCALE

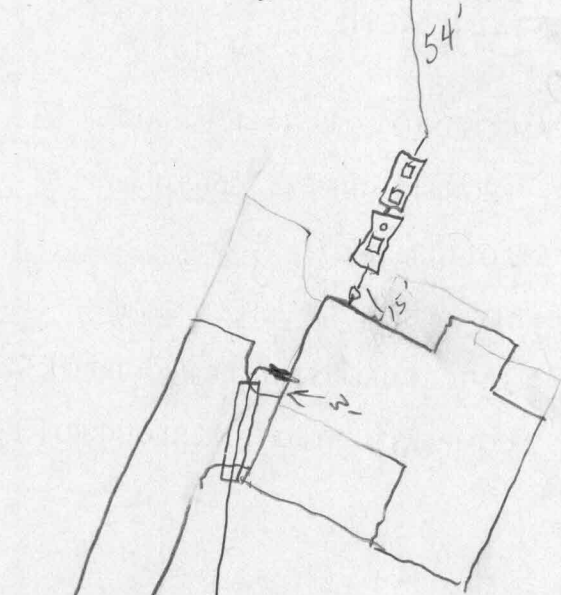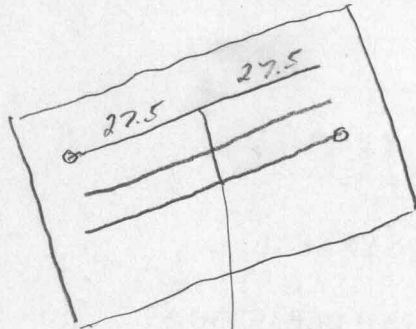

DOSING CHAMBER

Tank Level ✓
 Capacity 1250 Gal
 Seam Location Top
 Tank Lid Depth 2'
 Manhole Location F&B
 Water Tight Test ✓

FLOAT SETTINGS

Low Off 1 _____
 Low On 2 _____
 High On 3 _____
 Alarm 4 _____
 Dose Volume _____

SAND MOUND I

Bed Length 56
 Bed Width 8
 Bed Area 448 sq ft
 Mound Length 70.1
 Mound Width 36.2
 Mound Area 2537.62
 Basal Area _____ sq ft

SAND MOUND II

Bed Length _____
 Bed Width _____
 Bed Area _____ sq ft
 Mound Length _____
 Mound Width _____
 Mound Area _____
 Basal Area _____ sq ft

PRE-CONSTRUCTION 10/8/03 - Sand mound area staked, contour appears a little off, OK to start layout per BP. Add turn up on other side (50)

INSTALLATION 10/14/03 - Ground tilled, sand, gravel bed & laterals installed, OK to clay cap (56)
10/21/03 - Pump & Alarm test OK (50)

BUILDING PERMIT SIGNED
 AND RETURNED

FINAL INSPECTOR

DATE OF APPROVAL

10/21/03