

4-10 notes
on 10,000 \$.

APPLICATION

A 23862

Preliminary

SEWAGE DISPOSAL TESTING

P: _____

STATE OF MARYLAND - DEPARTMENT OF HEALTH AND MENTAL HYGIENE

HOWARD COUNTY HEALTH DEPARTMENT
ENVIRONMENTAL HEALTH SERVICES

DISTRICT Fourth

P. O. BOX 476, ELLICOTT CITY, MARYLAND 21043
TELEPHONE: 465-5000, EXT. 356

DATE Aug. 17, 1976

TO: THE COUNTY HEALTH OFFICER
ELLICOTT CITY, MARYLAND

I, HEREBY, APPLY FOR THE NECESSARY TEST IN ORDER TO CONSTRUCT (OR RECONSTRUCT) A SEWAGE DISPOSAL SYSTEM.

PROPERTY OWNER Brantly Associates
c/o H. F. Cole & Company, Inc.
ADDRESS 218 Teachers Building PHONE 730-0810
Columbia, Md. 21044

PROPERTY LOCATION:

SUBDIVISION Brantly LOT NO. 13
3356

ROAD AND DESCRIPTION Brantly Road

SIZE OF LOT 40,000 s.f. TYPE BLDG. 3 or 4 bedroom
NUMBER OF BEDROOMS

IF NOT SINGLE RESIDENCE DESCRIBE _____

THE SYSTEM INSTALLED UNDER THIS APPLICATION IS ACCEPTABLE ONLY UNTIL PUBLIC FACILITIES BECOME AVAILABLE.

BLDG. PERMIT, SIGNED
AND RETURNED 10/27/77
Serial No. 33776

SIGNATURE OF APPLICANT /s/ Hugh Cole

APPROVED BY *M. Mansfield* FOR *DW JT ranch* DATE *22 Aug 77*
(KIND OF SYSTEM)

REJECTED BY _____ FOR _____ DATE _____
(KIND OF SYSTEM)

HOLD PENDING FURTHER TESTS _____ DATE _____


REASONS FOR REJECTION OR HOLDING _____

THIS IS NOT A PERMIT

A23862

①
 0
 crs,
 sandy
 14

②
 0
 sandy
 silt
 14

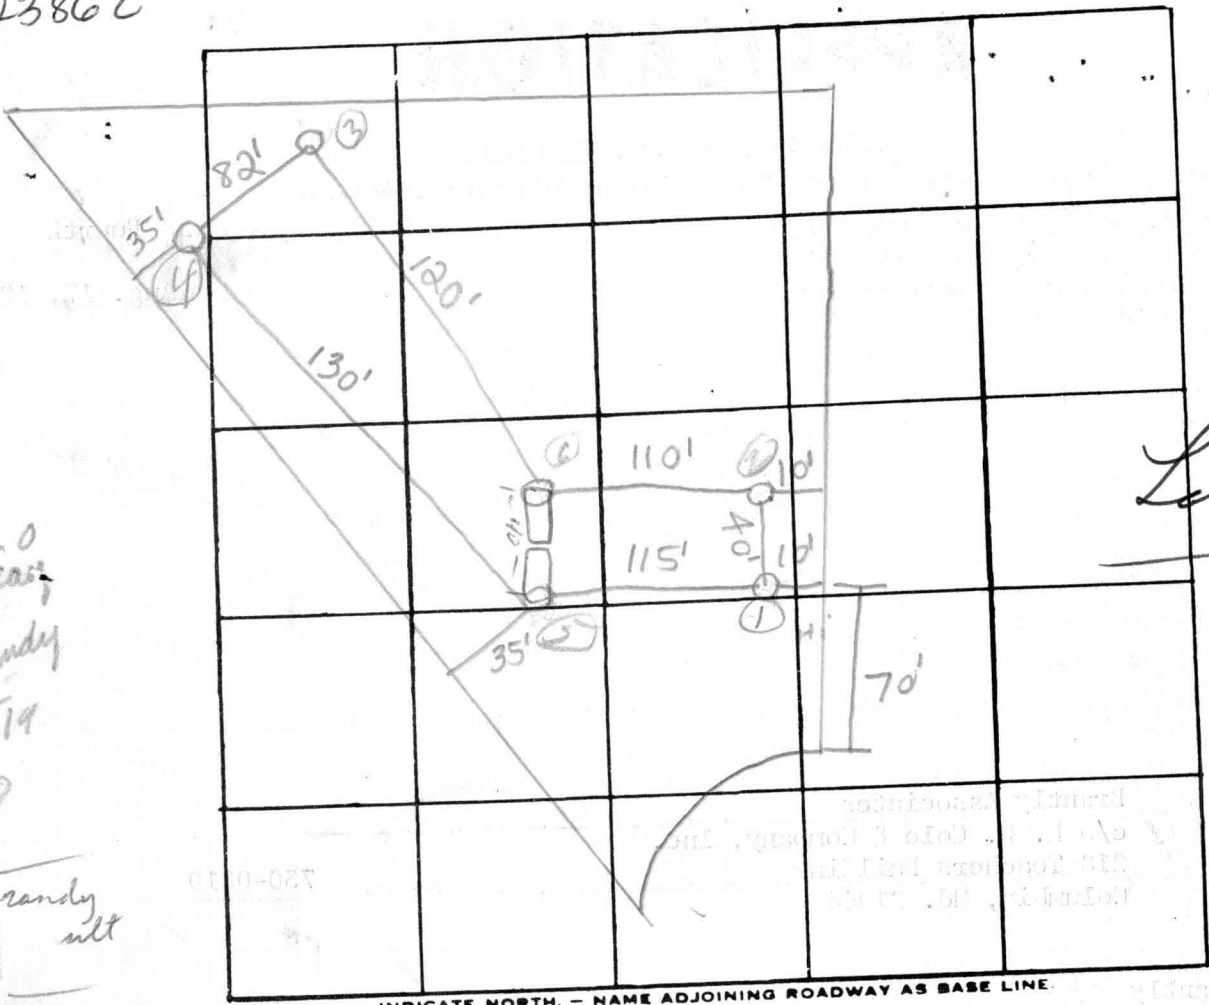

Lot 13

INDICATE NORTH. - NAME ADJOINING ROADWAY AS BASE LINE.

| DATE | TEST NO. | DEPTH | PRE-WET | | TEST - 1" DROP | | TIME |
|------|----------|--------|---------|--------|----------------|------|------|
| | | | START | STOP | START | STOP | |
| | 1s | 4 | 1450 | 1500 | 1500 | 1508 | 8 |
| | d | 14 | 1450 | 1459 | 1459 | 1509 | 10 |
| | 2 | visual | | 13 | | | |
| | 3s | 4 | 1505 | 1512 | 1512 | 1521 | 9 |
| | 3d | 14 | 1505 | 1512 | 1512 | 1524 | 12 |
| | 4s | 2 1/2 | 1511 | 1513 | 1513 | 1517 | 4 |
| | 4d | 14 | 1511 | 1520 | 1520 | 1540 | 20 |
| | 5s | 14 | | | | | |
| | d | | | | | | |
| | 6 | 14 | | visual | | | |

REMARKS _____

TYPE OF SOIL _____

TESTED BY

RB, RM

ALSO PRESENT:

Buttington
Crowe

