

3/31/78 after 12 noon  
4/3/78

7/31/78 P.C.O. C.B.D.

# PERMIT

SEWAGE DISPOSAL SYSTEM

MARYLAND STATE DEPARTMENT OF HEALTH\*

P 27712

A 23862

4/3/78 F.C.O. C.B.D.

HOWARD COUNTY

ELLICOTT CITY

DISTRICT 4th

DATE 3/23/78

**INDEXED**

Jim Brittingham

IS PERMITTED TO INSTALL  ALTER

ADDRESS \_\_\_\_\_ PHONE \_\_\_\_\_

SUBDIVISION Brantly ROAD Brantly Road LOT 13

PROPERTY OWNER Brantly Associated

ADDRESS \_\_\_\_\_

SPECIFICATIONS 4 bedrooms

SEPTIC TANK CAPACITY 1250 GALLONS

DRAIN FIELD \_\_\_\_\_ DEPTH \_\_\_\_\_ FEET, BOTTOM AREA \_\_\_\_\_ SQ. FT.

DEEP TRENCH \_\_\_\_\_ DEPTH \_\_\_\_\_ FEET, BOTTOM AREA \_\_\_\_\_ SQ. FT.

SEEPAGE PITS \_\_\_\_\_ ABSORBENT SIDE-WALL AREA 150 SQ. FT. per bedroom

INLET PIPE 4 FT. BELOW ORIGINAL GRADE. MAXIMUM DEPTH 10 FT. BELOW ORIGINAL GRADE

EFFECTIVE DEPTH AT \_\_\_\_\_ FT. BELOW ORIGINAL GRADE.

LOCATE DISPOSAL AREA 115 FT. FROM rear LOT LINE AND 35 FT. FROM right LOT LINE AS SEEN WHEN FACING LOT FROM the road

Begin the trench 5 ft. from the edge of the drywell and follow the contour of the land. The trench will be 2 ft. wide and 10 ft. deep, and contain 4 ft. of stone.

PLANS APPROVED BY R. Moorefield DATE 8/22/77

COVER NO WORK UNTIL INSPECTED AND APPROVED.

NEITHER THE HOWARD COUNTY COUNCIL NOR THE HEALTH DEPARTMENT IS RESPONSIBLE FOR THE SUCCESSFUL OPERATION OF ANY SYSTEM.

NOTE: IF TRENCH IS USED CALL FOR INSPECTION BEFORE PLACING GRAVEL IN TRENCH.

NOTE: NO DRY WELL SHALL EXCEED 15 FOOT IN DIAMETER.

NOTE: ALL PIPE FROM HOUSE TO DISPOSAL AREA MUST BE CAST IRON.


PERMIT VOID AFTER THREE YEARS.

NOTE: INSTALL STAND PIPE ON SEPTIC TANK AND DRY WELL. STAND PIPES MUST BE 6 INCHES IN DIAMETER. CAST IRON, CONCRETE OR TERRA COTTA ACCEPTED.

**\*INSTALLER IS RESPONSIBLE FOR OBTAINING FINAL APPROVAL ON THIS PERMIT.**

A 23862

M75800

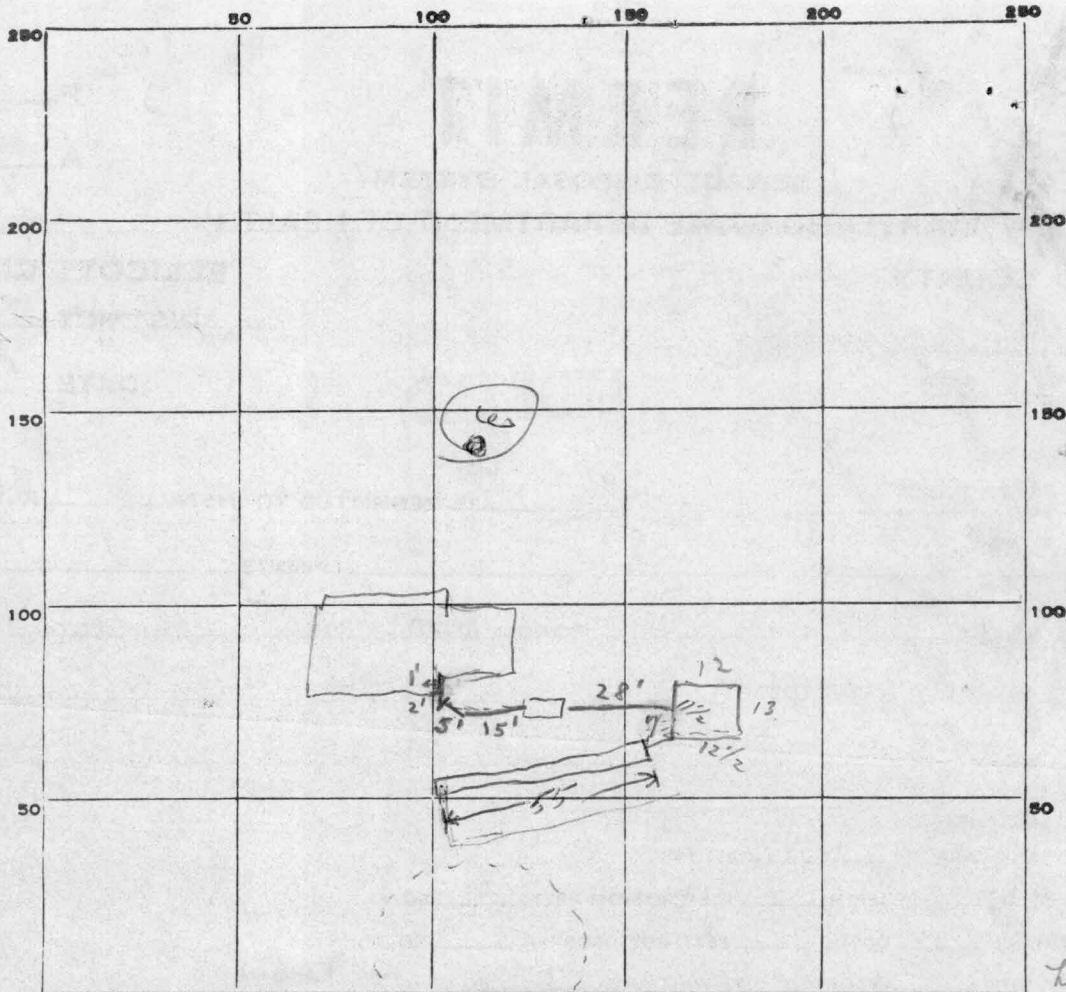

INDICATE NORTH. - NAME ADJOINING ROADWAY AS BASE LINE.

2X 13

PERMIT CARD \_\_\_\_\_ (Not seen) S.T. | P.W.  
 SEPTIC TANK, LEVEL ok ok 4/3/78  
 DISTRIBUTION BOX, LEVEL N/A P.M. 3/31/78

Trench  
 TILE FIELD, DEPTH 11 FT. TRENCH WIDTH 2 FT.  
 GRAVEL DEPTH 8 1/2' IN. TOTAL LENGTH 55 FT. ① 467.5'  
 NUMBER OF TRENCHES 1 TOTAL BOTTOM AREA \_\_\_\_\_  
 SEEPAGE PITS, INSIDE DIAMETER outside perimeter 49 FT. DEPTH BELOW INLET 7 FT. ② 343  
 ABSORBENT AREA 810 ± SQ. FT.

REMARKS 3/30/78 T.S.O. Trench OK to add stone P.M. 3/31/78 checked ok to cover  
for pipe + S.T. + pipe to drywell only Need to check drywell +  
trench. O.B.V.  
4/3/78 Gravel in + paper on to 2 1/2' of surface. C.B.V.

DATE SYSTEM APPROVED 4/3/78 aspx INSPECTOR C.B. Stricker