

**STATE OF MARYLAND
WATER-RESOURCES ADMINISTRATION
TAWES STATE OFFICE BLDG., ANNAPOLIS, MD. 21401
WELL COMPLETION REPORT**

THIS REPORT MUST BE SUBMITTED IN 30 DAYS AFTER WELL COMPLETION

FILL IN THIS FORM COMPLETELY

COUNTY NUMBER AA3862

SEQUENCE NO. (WRA USE ONLY) 8873

1 2 3 (SEQ. NO.) 6
(THIS NUMBER IS TO BE PUNCHED IN COLS. 3-6 ON ALL CARDS)

DATE RECEIVED (WRA USE ONLY)
8-13

DEPTH OF WELL
DATE WELL COMPLETED Oct 12 77
22 (TO NEAREST FOOT) 26
165

PERMIT NO. FROM "PERMIT TO DRILL WELL"
28 29 30 31 32 33 34 35 36 37
DRILLERS IDENTIFICATION NO. 238

OWNER Brownthly Associates FIRST NAME
LAST NAME
STREET OR RFD 218 Municipal Building POST OFFICE Washington

WELL LOG			
STATE THE KIND OF FORMATIONS PENETRATED, THEIR COLOR, DEPTH, THICKNESS AND IF WATER BEARING			
DESCRIPTION (USE ADDITIONAL SHEETS IF NECESSARY)	FEET		CHECK IF WATER BEARING
	FROM	TO	
<u>Brown Shale @ 40</u>			
<u>Gray granite 40-165</u>			

GROUTING RECORD

WELL HAS BEEN GROUTED (CIRCLE APPROPRIATE BOX) YES NO
44 44

TYPE OF GROUTING MATERIAL (CIRCLE BOX):
CEMENT BENTONITE CLAY
45 46 45 46

NO. OF BAGS 15 NO. OF POUNDS 1410

GALLONS OF WATER 90

DEPTH OF GROUT SEAL (TO NEAREST FOOT)
FROM 0 FT. TO 48 FT.
(ENTER 0 IF FROM SURFACE)

CASING RECORD

CASING TYPES
INSERT APPROPRIATE CODE BELOW
STEEL CONCRETE
PLASTIC OTHER

MAIN CASING TYPE ST NOMINAL DIAMETER TOP (MAIN) CASING (NEAREST INCH) 6 TOTAL DEPTH OF MAIN CASING (NEAREST FOOT) 50

OTHER CASING (IF USED)

EACH CASING	DIAMETER (INCH)		DEPTH (FEET)	
	FROM	TO	FROM	TO

SCREEN RECORD

SCREEN TYPE OR OPEN HOLE
INSERT APPROPRIATE CODE BELOW
STEEL BRASS OR BRONZE OPEN HOLE
PLASTIC OTHER

SCREEN

DEPTH (NEAREST WHOLE FOOT)
FROM 48 TO 165

EACH SCREEN	DIAMETER OF SCREEN (NEAREST INCH)	
	FROM	TO
1	<u>48</u>	<u>165</u>
2		
3		

SLOT SIZE 1. _____ 2. _____ 3. _____

DIAMETER OF SCREEN 56 (NEAREST INCH)
FROM _____ TO _____

GRAVEL PACK _____

IF WELL DRILLED WAS A FLOWING WELL CIRCLE BOX 68

WRA USE ONLY (NOT TO BE FILLED IN BY DRILLER)

TELESCOPE CASING LOG INDICATOR OTHER DATA AVAILABLE

PUMPING TEST

HOURS PUMPED (TO NEAREST HOUR) 2

PUMPING RATE (GALLONS PER MINUTE TO NEAREST GALLON) 10

METHOD USED TO MEASURE PUMPING RATE Well

WATER LEVEL: (DISTANCE FROM LAND SURFACE)
BEFORE PUMPING 45 (NEAREST FOOT)
WHEN PUMPING 5 (NEAREST FOOT)

TYPE OF PUMPED USED (CIRCLE APPROPRIATE BOX) (FOR PUMPING TEST)
A AIR P PISTON T TURBINE
27 27 27
C CENTRIFUGAL R ROTARY O OTHER (DESCRIBE BELOW)
27 27 27
J JET S SUBMERSIBLE
27 27


PUMP INSTALLED

TYPE OF PUMP (WRITE APPROPRIATE LETTER IN BOX - SEE ABOVE: A, C, J, P, R, S, T, O) 29

DRILLER WILL INSTALL PUMP (CIRCLE APPROPRIATE BOX) YES NO

CAPACITY:
GALLONS PER MINUTE (TO NEAREST GALLON) 31 35
PUMP HORSE POWER 37 41
PUMP COLUMN LENGTH (NEAREST FOOT) 43 47

CASING HEIGHT (CIRCLE APPROPRIATE BOX AND ENTER CASING HEIGHT)
 ABOVE } LAND SURFACE (NEAREST FOOT)
 BELOW } 2

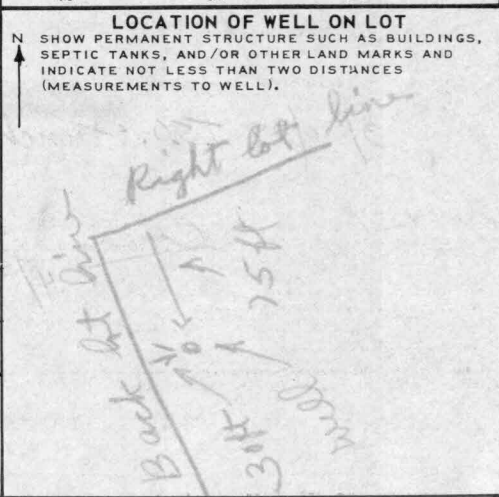

CIRCLE APPROPRIATE BOXES

A WELL WAS ABANDONED AND SEALED WHEN THIS WELL WAS COMPLETED

E ELECTRIC LOG OBTAINED

P TEST WELL CONVERTED TO PRODUCTION WELL

I HEREBY CERTIFY THAT I HAVE COMPLIED WITH ALL CONDITIONS STATED ON THE ABOVE-CAPTIONED "PERMIT TO DRILL WELL", AND THAT INFORMATION CONTAINED IN THIS REPORT IS TRUE, ACCURATE, AND COMPLETE TO THE BEST OF MY KNOWLEDGE, INFORMATION AND BELIEF.

DRILLERS NAME
(PLEASE PRINT) Joseph Mayan
SIGNATURE Joseph Mayan

