

Retest  
3/23/76  
9:30 A.M.  
off Brighton  
on 1st

# APPLICATION

A22870

SEWAGE DISPOSAL TESTING

P. \_\_\_\_\_

STATE OF MARYLAND - DEPARTMENT OF HEALTH AND MENTAL HYGIENE

HOWARD COUNTY HEALTH DEPARTMENT  
ENVIRONMENTAL HEALTH SERVICES  
P. O. BOX 476, ELLICOTT CITY, MARYLAND 21043  
TELEPHONE: 465-5000, EXT. 356

DISTRICT 5th  
DATE 2/26/76

*( See next page for connected specs. C.B.D. )  
( Hold til plat plan JDT-101  
is certified by designer or owner or contractor )*

TO: THE COUNTY HEALTH OFFICER  
ELLICOTT CITY, MARYLAND

I, HEREBY, APPLY FOR THE NECESSARY TEST IN ORDER TO CONSTRUCT (OR RECONSTRUCT) A SEWAGE DISPOSAL SYSTEM.

PROPERTY OWNER Aintree Estates, Inc. - Contract Purchaser - John D. Jesse

ADDRESS #6 Darnell Court, Olney, Md. PHONE 774-2497

PROPERTY LOCATION:

SUBDIVISION Aintree Estates LOT NO. 22, Sec. 2

ROAD AND DESCRIPTION 6279 Firethorn Road Lane

SIZE OF LOT 2.6 acres ± TYPE BLDG. 3 or 4 bedroom  
NUMBER OF BEDROOMS

IF NOT SINGLE RESIDENCE DESCRIBE \_\_\_\_\_

THE SYSTEM INSTALLED UNDER THIS APPLICATION IS ACCEPTABLE ONLY UNTIL PUBLIC FACILITIES BECOME AVAILABLE.

SIGNATURE OF APPLICANT: John D. Jesse

APPROVED BY \_\_\_\_\_ FOR \_\_\_\_\_ DATE \_\_\_\_\_  
(KIND OF SYSTEM)


REJECTED BY \_\_\_\_\_ FOR \_\_\_\_\_ DATE \_\_\_\_\_  
(KIND OF SYSTEM)

HOLD PENDING FURTHER TESTS \_\_\_\_\_ DATE \_\_\_\_\_

REASONS FOR REJECTION OR HOLDING 3/23/76 Hold for certified plans  
by owner on house plat!!  
C.B.S.

## THIS IS NOT A PERMIT

310

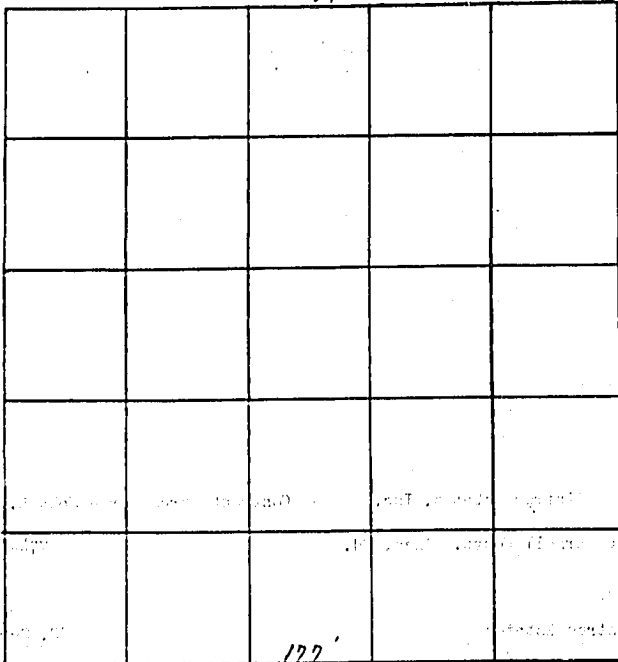

INDICATE NORTH - NAME ADJOINING ROADWAY AS BASE LINE.

*Fritcham Rd.*

DATE	TEST NO.	DEPTH	PRE-WET		TEST - 1" DROP		TIME
			START	STOP	START	STOP	
7/23/76	1	4' s	9:59	9:58	9:58	10:01	3m
	2	13 o	9:59	10:02	10:02	10:05	3m
	3	Kind of old test area					(344)
	4	X o	X	X	X	X	
	5	X s	X	X	X	X	
	6	X o	X	X	X	X	
	7	V. Good	X	X	X	X	

*See original test*

*S. Micaeous  
some sand  
stone  
Good soil of  
4'*

*John Jesse*

REMARKS Owner to certify hole location.  
 TYPE OF SOIL Micae - sand geol  
 TESTED BY C. R. A. ALSO PRESENT: J. F. ...

*on his building  
plot  
for system  
to be near*