

C i 1827 SEQUENCE NO. (WRA USE ONLY)
 1 2 3 (SEQ. NO.) 4
 (THIS NUMBER IS TO BE PUNCHED IN COLOR: 3-6 ON WELL CARDS)

STATE OF MARYLAND
 WATER RESOURCES ADMINISTRATION
 TAWES STATE OFFICE BLDG., ANNAPOLIS, MD. 21401
 WELL COMPLETION REPORT

THIS REPORT MUST BE SUBMITTED WITHIN 30 DAYS AFTER WELL COMPLETION
 FILL IN THIS FORM COMPLETELY
 COUNTY NUMBER

DATE RECEIVED (WRA USE ONLY) 12-16-79 DEPTH OF WELL 300
 DATE WELL COMPLETED 22 (TO NEAREST FOOT) 20
 PERMIT NO. FROM "PERMIT TO DRILL WELL" H-12-1-17
 28 29 30 31 32 33 34 35 36 37
 120
 DRILLERS IDENTIFICATION NO.

OWNER JESSE JARA LAST NAME
 STREET OR RFD C. DANIEL CT. POST OFFICE CLANEY, MD. FIRST NAME

WELL LOG

STATE THE KIND OF FORMATIONS PENETRATED, THEIR COLOR, DEPTH, THICKNESS AND IF WATER BEARING

DESCRIPTION (USE ADDITIONAL SHEETS IF NECESSARY)	FEET		CHECK IF WATER BEARING
	FROM	TO	
OVERBURDEN	0	7	
BROWN SLT	7	39	
GRAY ROCK	39	300	X

WELL # 1 (250' DRY)
 WELL # 2 (150' DRY)

WELL DESCRIPTION

GROUTING RECORD YES NO
 WELL HAS BEEN GROUTED (CIRCLE APPROPRIATE BOX) Y N
 TYPE OF GROUTING MATERIAL (CIRCLE BOX) 24 44
 CEMENT C M BENTONITE CLAY B C
 45 46 45 46
 NO. OF BAGS 4 NO. OF POUNDS 1700
 GALLONS OF WATER 54
 DEPTH OF GROUT SEAL (TO NEAREST FOOT)
 FROM 0 FT. TO 42 FT.
 (ENTER 0 IF FROM SURFACE) 68

CASING RECORD
 Casing Types: S T C O P L O T
 STEEL CONCRETE PLASTIC OTHER
 MAIN CASING TYPE S T NOMINAL DIAMETER TOP (MAIN) CASING (NEAREST INCH) 6 TOTAL DEPTH OF MAIN CASING (NEAREST FOOT) 42
 60 61 63 64 66 70

C 3

PUMPING TEST
 1 2 3 (SEQ. NO.) 6
 HOURS PUMPED (TO NEAREST HOUR) 3
 PUMPING RATE GALLONS PER MINUTE TO NEAREST GALLON 3
 11 18
 METHOD USED TO MEASURE PUMPING RATE AIR
 WATER LEVEL (DISTANCE FROM LAND SURFACE) BEFORE PUMPING 50 (NEAREST FOOT)
 17 20
 WHEN PUMPING 270 (NEAREST FOOT)
 22 28
 TYPE OF PUMPED USED (CIRCLE APPROPRIATE BOX) (FOR PUMPING TEST)
 A R P T C R O J S
 27 27 27 27 27 27 27 27
 AIR PISTON TURBINE CENTRIFUGAL ROTARY OTHER (DESCRIBE BELOW) JET SUBMERISBLE

OTHER CASING (IF USED) (CIRCLE APPROPRIATE BOX)
 DIAMETER (INCH) DEPTH (FEET) FROM TO
 SCREEN RECORD
 SCREEN TYPE OR OPEN HOLE S T B R H O P L O T
 INSERT APPROPRIATE CODE BELOW STEEL BRASS OPEN HOLE PLASTIC OTHER
 C 2
 1 2 3 (SEQ. NO.) 6
 DEPTH (NEAREST WHOLE FOOT) FROM 40 TO 300
 8 9 11 13 17 21
 23 24 26 30 32 36
 38 39 41 45 47 51
 SLOT SIZE 1, 2, 3

PUMP INSTALLED
 TYPE OF PUMP (WRITE APPROPRIATE LETTER IN BOX - SEE ABOVE: A, C, J, P, R, S, T, O)
 DRILLER WILL INSTALL PUMP (CIRCLE APPROPRIATE BOX) YES NO
 CAPACITY: GALLONS PER MINUTE (TO NEAREST GALLON) 31 30
 PUMP HORSE POWER 37 41
 PUMP COLUMN LENGTH (NEAREST FOOT) 43 47
 CASING HEIGHT (CIRCLE APPROPRIATE BOX AND ENTER CASING HEIGHT)
 + ABOVE LAND SURFACE 1 (NEAREST FOOT)
 - BELOW 49 50 51
 LOCATION OF WELL ON LOT
 SHOW PERMANENT STRUCTURE SUCH AS BUILDINGS, SEPTIC TANKS, AND/OR OTHER LAND MARKS AND INDICATE NOT LESS THAN TWO DISTANCES (MEASUREMENTS TO WELL).

CIRCLE-APPROPRIATE BOXES
 A WELL WAS ABANDONED, AND SEALED WHEN THIS WELL WAS COMPLETED.
 E ELECTRIC LOG OBTAINED
 P TEST WELL CONVERTED TO PRODUCTION WELL.
 I HEREBY CERTIFY THAT I HAVE COMPLIED WITH ALL CONDITIONS STATED ON THE ABOVE-CAPTIONED "PERMIT TO DRILL WELL" AND THAT INFORMATION CONTAINED IN THIS REPORT IS TRUE, ACCURATE, AND COMPLETE TO THE BEST OF MY KNOWLEDGE, INFORMATION AND BELIEF.
 DRILLERS NAME
 (PLEASE PRINT) GERRARD MARK SWINE FORD
 SIGNATURE

DIAMETER OF SCREEN 86 90 (NEAREST INCH) FROM TO
 GRAVEL PACK
 IF WELL DRILLED WAS A FLOWING WELL CIRCLE BOX 08 F
 WRA USE ONLY (NOT TO BE FILLED IN BY DRILLER) (E.R.O.S.)
 T W Q
 70 72 74 75 76
 TELESCOPE CASING LOG INDICATOR OTHER DATA AVAILABLE

PITLESS ADAPTER

MARYLAND DEPARTMENT OF THE ENVIRONMENT, WATER MANAGEMENT ADMINISTRATION
 2500 BROENING HIGHWAY, BALTIMORE, MARYLAND 21224, (410) 631-3784

 WATER WELL ABANDONMENT-SEALING REPORT FORM

SUBMIT COPIES OF COMPLETED FORM TO:

- * COUNTY ENVIRONMENT AGENCY (contact MDE, WMA if address needed)
- * WELL OWNER
- * MDE, WATER MANAGEMENT ADMINISTRATION, WELL PROGRAM

DATE WELL ABANDONED: 4-14-06 (month/day/year)

* PERMIT NUMBER OF ABANDONED WELL (if any) Ho - 73 - 1759

* PERMIT NUMBER OF REPLACEMENT WELL Ho - 95 - 0303

* PERSON ABANDONING WELL: Joseph L. Mayne


WELL DRILLERS LICENSE NUMBER: 024

CIRCLE: MWD/MSD/MGD

* OWNER'S NAME: Carl Herrmann

SITE LOCATION MAP

* WELL LOCATION:
 COUNTY: Howard
 NEAREST TOWN: Clarksville
 TAX MAP 34 BLOCK 13 PARCEL 264
 SUBDIVISION: Orchard Estates
 SECTION: 2 LOT: 22
 NEAREST ROAD: 6279 Firethorn Lane

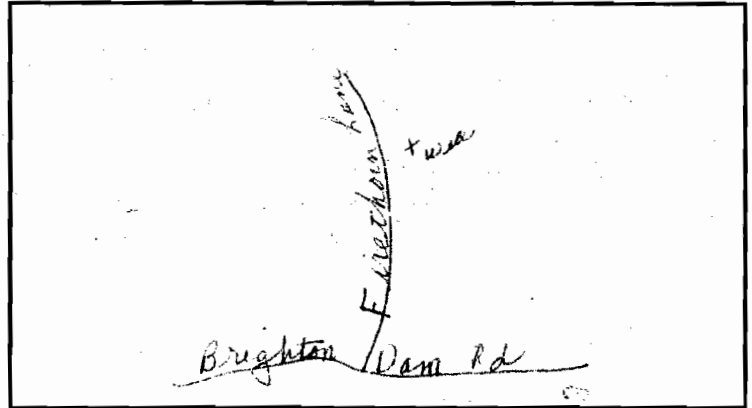

* TYPE OF WELL BEING ABANDONED:

DRILLED JETTED
 BORED/AUGERED HAND DUG
 OTHER (specify) _____

* USE CODE:

DOMESTIC MUNICIPAL/PUBLIC
 IRRIGATION INDUSTRIAL
 TEST/OBSERVATION GEOTHERMAL

* TYPE OF CASING:

STEEL PLASTIC
 CONCRETE OTHER (specify) _____

* SIZE OF CASING: 6 3/8 INCHES IN DIAMETER

* DEPTH OF WELL: 300 FEET DEEP

* WAS ANY CASING REMOVED? YES NO
 if yes, length removed, in feet: 2

* WAS CASING RIPPED OR PERFORATED? YES NO

LOG OF SEALING MATERIAL

MATERIAL	FEET	
	FROM	TO
Crushed limestone mixture	0	300
VOLUME OF MATERIAL USED		

SIGNATURE - MASTER WELL DRILLER OR SUPERVISING SANITARIAN Joseph L. Mayne LICENSE # MSD024 MWD/MSD/MGD CIRCLE ONE DATE 4-14-06
 DENV 828 JULY 1997 2) COUNTY ENVIRONMENTAL AGENCY