

ISSUE DATE: 6/21/2001

PERMIT

P 515300-A

APPROVAL DATE: 6/27/01

A 58095-B

ON-SITE SEWAGE DISPOSAL SYSTEM HOWARD COUNTY HEALTH DEPARTMENT BUREAU OF ENVIRONMENTAL HEALTH

INDEXED

Fogles Septic Clean, Inc IS PERMITTED TO INSTALL ALTER

ADDRESS: 580 Obrecht Rd, Sykesville, MD PHONE NUMBER: 410-795-5670

SUBDIVISION: Wellington West II LOT NUMBER: 3

ADDRESS: 15233 Bucks Run Drive PROPERTY OWNER: Pulte Homes

SEPTIC TANK CAPACITY (GALLONS): 1250

PUMP CHAMBER CAPACITY (GALLONS): N/A

NUMBER OF BEDROOMS: 4

SQUARE FEET PER BEDROOM: 180

LINEAR FEET OF TRENCH REQUIRED: 240

TRENCHES:	Trench to be 3.0 feet wide. Inlet 2.0 feet below original grade. Bottom maximum depth 4.0 feet below original grade. Effective area begins at 2.0 feet below original grade. 2.0 feet of stone below distribution pipe.
LOCATION:	Place the distribution box 100' down the right lot line and 30' off this same lot line. Run (3) trenches on contour to right side of lot.
NOTES:	

PLANS APPROVED: MER DATE: 5/9/01


- NOTE: PERMIT VOID AFTER 2 YEARS
- NOTE: CONTRACTOR RESPONSIBLE FOR SCHEDULING A PRE-CONSTRUCTION INSPECTION FOR ALL INSTALLATIONS
- NOTE: WATERTIGHT SEPTIC TANKS REQUIRED
- NOTE: ALL PARTS OF SEPTIC SYSTEM SHALL BE 100 FEET FROM ANY WATER WELL
- NOTE: MANHOLE RISERS REQUIRED ON ALL SEPTIC TANKS AND PUMP CHAMBERS

NEITHER THE HOWARD COUNTY COUNCIL NOR THE HEALTH DEPARTMENT IS RESPONSIBLE FOR THE SUCCESSFUL OPERATION OF ANY SYSTEM PERMITTEE RESPONSIBLE FOR OBTAINING FINAL APPROVAL ON THIS PERMIT CALL 410-313-2640 FOR INSPECTION OF SEPTIC SYSTEM

BUILDING PERMIT SIGNED AND RETURNED 7-3-02
1300 137 279-DECK

P 515300-A

NOT TO SCALE

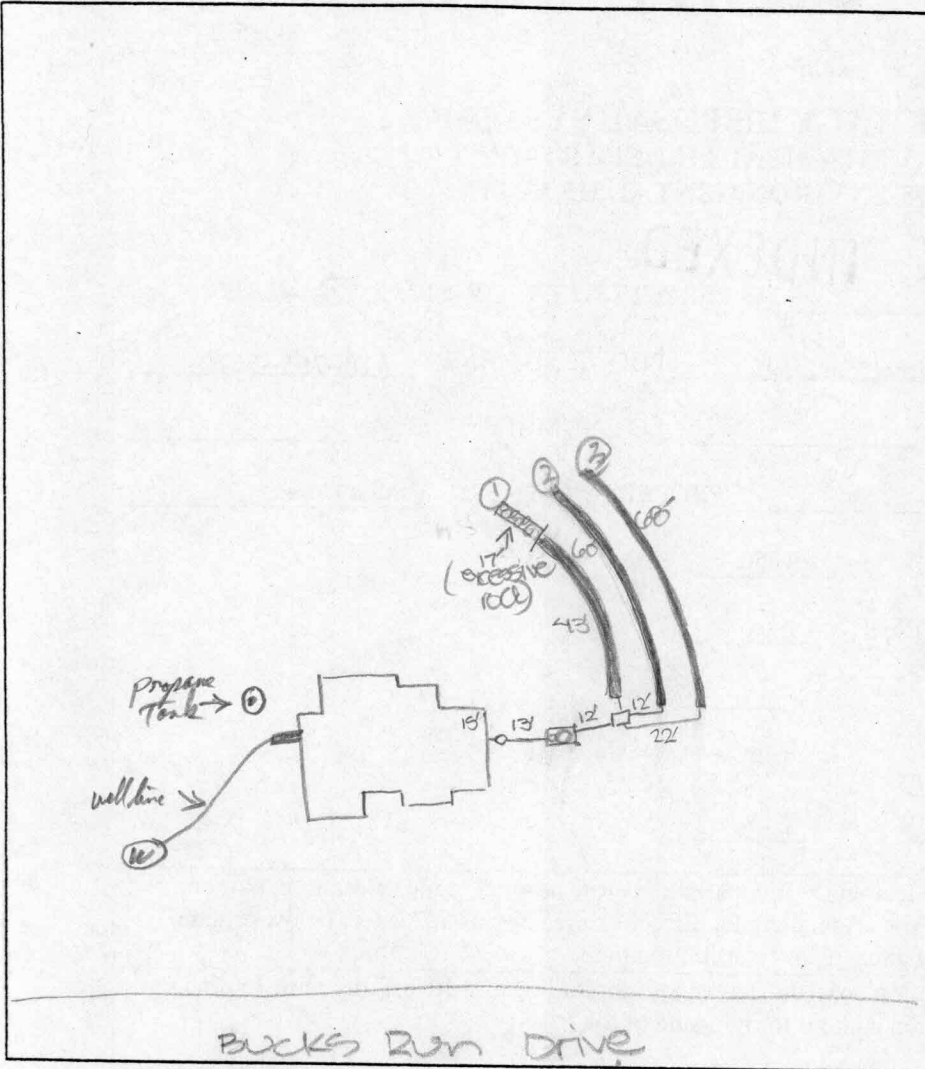

TRENCH DATA

TRENCH WIDTH $\frac{1}{2} | \frac{2,3}{2}$
 TRENCH INLET DEPTH 2
 TRENCH BOTTOM DEPTH $\frac{4}{1} | \frac{2,3}{7}$
 DEPTH OF STONE $\frac{1}{2} | \frac{2,3}{5}$
 NUMBER OF TRENCHES 3
 TOTAL TRENCH LENGTH 171
 ABSORBENT AREA 769
 DISTRIBUTION BOX LEVEL
 BAFFLE IN DISTRIBUTION BOX

SEPTIC TANK DATA

SEPTIC TANK 1250 TS GALLONS
 MANHOLE RISER
 6 INCH INSPECTION PORT

PUMP CHAMBER DATA

~~PUMP CHAMBER GALLONS _____
 MANHOLE RISER _____
 ALARM _____
 PUMP PERFORMANCE TEST _____~~

PRE-CONSTRUCTION INSPECTION: 6/25/01 OK TO START PER PLAN (MR)

INSPECTION COMMENTS: 6/26/01 first trench stopped @ 43' in length - excessive rock beyond. second and third trench specs were revised based on soil types to conserve remainder of SDA. DCC 6/26/01 P.M. OK to continue work. DCC 6/27/01 A.M. OK to cover work - need 6" c.o. and manhole. DCC 8-10-01 WPI OK - COVER KG/RP

6/27/01 P.M. FINAL INSP - OK to cover all septic work. DCC

INSPECTOR [Signature]

DATE SYSTEM APPROVED _____
 BUILDING PERMITS DIVISION
 AND RETURNED