

6/20/01
layout
103-113

6/21/01
Final
Anytime

Needs House Connection

ISSUE DATE: 6/13/2001

APPROVAL DATE: 6/21/01

P 515291-B

A 58095-G

PERMIT

INDEXED

**ON-SITE SEWAGE DISPOSAL SYSTEM
HOWARD COUNTY HEALTH DEPARTMENT
BUREAU OF ENVIRONMENTAL HEALTH**

04-362306

Fogles Septic Clean, Inc IS PERMITTED TO INSTALL ALTER

ADDRESS: 580 Obrecht Road, Sykesville, MD PHONE NUMBER: 410-795-5670

SUBDIVISION: Wellington West II LOT NUMBER: 8

ADDRESS: 15253 Bucks Run Drive PROPERTY OWNER: PRIBURG Pulte Home Corp.

SEPTIC TANK CAPACITY (GALLONS): 1250 (TOP SEAM)

PUMP CHAMBER CAPACITY (GALLONS): N/A

NUMBER OF BEDROOMS: 4

SQUARE FEET PER BEDROOM: 180

LINEAR FEET OF TRENCH REQUIRED: 240

TRENCHES:	Trench to be 3.0 feet wide. Inlet 2.0 feet below original grade. Bottom maximum depth 3.5 feet below original grade. Effective area begins at 2.0 feet below original grade. 1.5 feet of stone below distribution pipe.
LOCATION:	Begin trenches 65 feet off the left lot line and 110 feet off the rear lot line as seen when facing the lot from Bucks Run Drive. Run trenches on contour toward the rear lot line.
NOTES:	


PLANS APPROVED: Amy Mc Millen OK SRU 4/12/01 DATE: 4-6-01

- NOTE: PERMIT VOID AFTER 2 YEARS
- NOTE: CONTRACTOR RESPONSIBLE FOR SCHEDULING A PRE-CONSTRUCTION INSPECTION FOR ALL INSTALLATIONS
- NOTE: WATERTIGHT SEPTIC TANKS REQUIRED
- NOTE: ALL PARTS OF SEPTIC SYSTEM SHALL BE 100 FEET FROM ANY WATER WELL
- NOTE: MANHOLE RISERS REQUIRED ON ALL SEPTIC TANKS AND PUMP CHAMBERS

NEITHER THE HOWARD COUNTY COUNCIL NOR THE HEALTH DEPARTMENT IS RESPONSIBLE FOR THE SUCCESSFUL OPERATION OF ANY SYSTEM PERMITTEE RESPONSIBLE FOR OBTAINING FINAL APPROVAL ON THIS PERMIT CALL 410-313-2640 FOR INSPECTION OF SEPTIC SYSTEM

BLANK PERMITS SIGNED
AND RETURNED 2-27-02
800 134587
391x21 DECK

P 515291-B

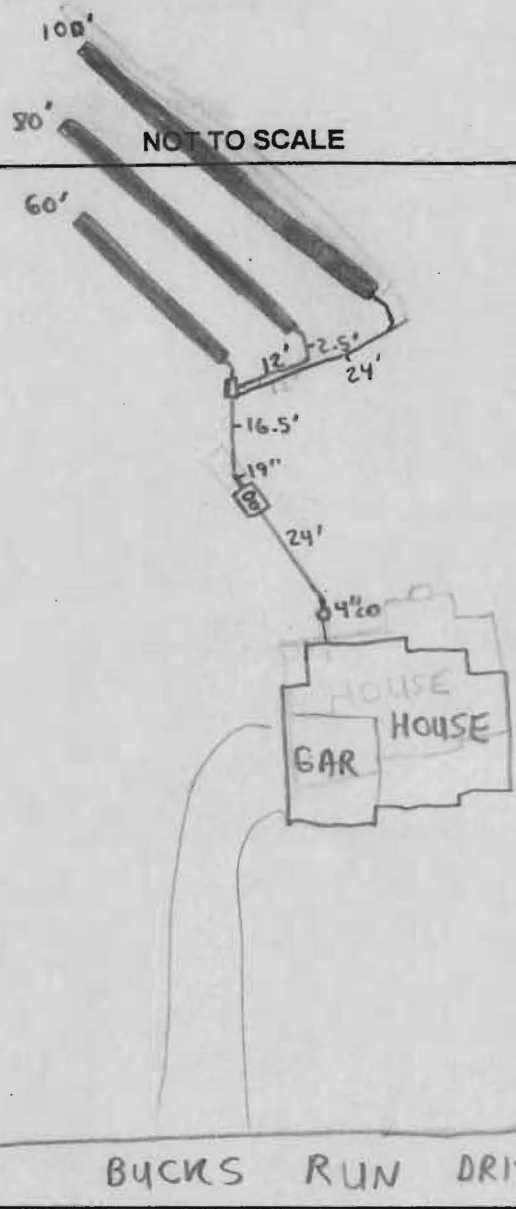

NOT TO SCALE

TRENCH DATA	
TRENCH WIDTH	3'
TRENCH INLET DEPTH	2'
TRENCH BOTTOM DEPTH	3.5'
DEPTH OF STONE	1.5'
NUMBER OF TRENCHES	3
TOTAL TRENCH LENGTH	240
ABSORBENT AREA	720 ft ²
DISTRIBUTION BOX LEVEL	<input checked="" type="checkbox"/>
BAFFLE IN DISTRIBUTION BOX	<input checked="" type="checkbox"/>

SEPTIC TANK DATA	
SEPTIC TANK	1250 GALLONS
BAFFLES IN MANHOLE RISER	on center
6 INCH INSPECTION PORT	<input checked="" type="checkbox"/>
PUMP CHAMBER DATA	
PUMP CHAMBER GALLONS	NA
MANHOLE RISER	NA
ALARM	NA
PUMP PERFORMANCE TEST	NA

PRE-CONSTRUCTION INSPECTION: 6/20/01 - OK TO PROCEED PER PLAN - (SRK)

INSPECTION COMMENTS: 6/20/01 - OK TO CONTINUE WORK - (SRK)

House connection not made yet. 6/21/01 PJP

6/27/01 house connection verified. (SRK)

INSPECTOR Tom K. Clark DATE SYSTEM APPROVED 6/27/01