

4.15' Lateral  
and 10,000 ft

*Preliminary*

# APPLICATION

22005

SEWAGE DISPOSAL TESTING  
STATE OF MARYLAND - DEPARTMENT OF HEALTH AND MENTAL HYGIENE  
HOWARD COUNTY HEALTH DEPARTMENT  
ENVIRONMENTAL HEALTH SERVICES  
P. O. BOX 476, ELLICOTT CITY, MARYLAND 21043  
TELEPHONE: 465-5000, EXT. 356

P \_\_\_\_\_  
DISTRICT Fifth  
DATE August 12, 1975

TO: THE COUNTY HEALTH OFFICER  
ELLICOTT CITY, MARYLAND

I, HEREBY, APPLY FOR THE NECESSARY TEST IN ORDER TO CONSTRUCT (OR RECONSTRUCT) A SEWAGE DISPOSAL SYSTEM.

PROPERTY OWNER Henry Dryfoos III

ADDRESS 4330-42nd St, N.W., Washington, D.C. PHONE 202-363-3167

PROPERTY LOCATION:

SUBDIVISION Flamewood Section #2 LOT NO. 1

ROAD AND DESCRIPTION 0.6 mile west of intersection of Johns Hopkins Road and Sanner Road along Johns Hopkins Road

SIZE OF LOT 40,126 square feet TYPE BLDG. 3-4  
NUMBER OF BEDROOMS

IF NOT SINGLE RESIDENCE DESCRIBE \_\_\_\_\_

THE SYSTEM INSTALLED UNDER THIS APPLICATION IS ACCEPTABLE ONLY UNTIL PUBLIC FACILITIES BECOME AVAILABLE.

SIGNATURE OF APPLICANT Henry Dryfoos III

APPROVED BY Frank Skinner FOR Drywell trench DATE 11/5/76  
(KIND OF SYSTEM)

REJECTED BY \_\_\_\_\_ FOR \_\_\_\_\_ DATE \_\_\_\_\_  
(KIND OF SYSTEM)


HOLD PENDING FURTHER TESTS \_\_\_\_\_ DATE \_\_\_\_\_

REASONS FOR REJECTION OR HOLDING \_\_\_\_\_

140  
9  
60

101  
85  
505  
808  
5585

## THIS IS NOT A PERMIT

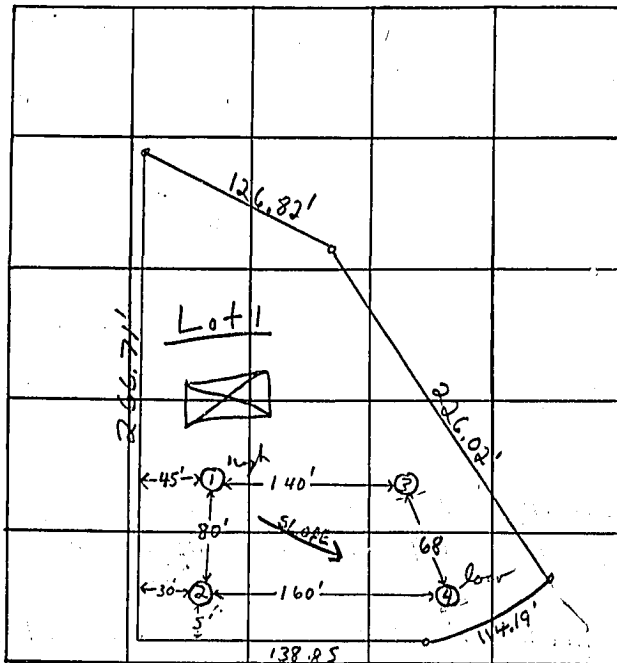

INDICATE NORTH. - NAME ADJOINING ROADWAY AS BASE LINE.

DATE	TEST NO.	DEPTH	PRE-WET		TEST - 1" DROP		TIME
			START	STOP	START	STOP	
9/2/75	1A high	3 1/2'	12:23	pulled plug 12:55	12:55	12:25	4 min
	2	11 1/2'	U1 end	close to 5' end			
	3	3'	12:38	12:39	12:39	12:40	1 min
	3A	12 1/2'	12:38	12:40	12:40	12:43	3 min
	4 low	3 1/2'	12:41	12:42	12:42	12:43	1 min
	4A	12 3/4'	12:41	12:45	12:45	12:52	7 min
9/16/75	15	7'	1:44	1:50	1:50	2:00	10

5 min avg  
over 5 ft.

REMARKS \_\_\_\_\_

TYPE OF SOIL sandy, micaceous brown below top 3-5' clayey sand

TESTED BY F.S. ALSO PRESENT: D. Parlette et al.