

SEPTIC SYSTEM MUST BE
INSTALLED FIRST BEFORE
BUILDING PERMIT SIGNED.

OK TO SIGN BLDG PERMIT 8/11/77

PERMIT

26277
A 22005

SEWAGE DISPOSAL SYSTEM

MARYLAND STATE DEPARTMENT OF HEALTH

HOWARD COUNTY

ELLICOTT CITY

DISTRICT 5th

DATE 6/29/77

*8/3/77 Partial
1.00 T.M.
8/4/77
Account from 11/22/77- app'd G.S.*

INDEXED

Jack Fyock, Jr. IS PERMITTED TO INSTALL ALTER

ADDRESS 13775 Trindolphia Rd. PHONE 988-9270

A SEWAGE DISPOSAL SYSTEM LOCATED AT _____

SUBDIVISION Flamewood Section #2 ROAD Sammor Rd. Johns Hopkins Rd. & LOT 1

PROPERTY OWNER Henry Dryfoos III

ADDRESS 4330 - 42nd St., N.W., Washington, D. C. 202-363-3167

SPECIFICATIONS 4 bedrooms

DRAIN FIELD _____ DEPTH _____ FEET, BOTTOM AREA _____ SQ. FT.

SEEPAGE PITS _____ ABSORBENT SIDE-WALL AREA _____ SQ. FT.

SEPTIC TANK CAPACITY 1250 GALLONS

BLDG. PERMIT SIGNED
AND RETURNED 8/5/77
Serial No. 32208

FOR GARBAGE GRINDER, INCREASE DISPOSAL AREA 22% & TANK CAPACITY 50%.

OTHER DRY WELL AND TRENCH: Dry well 140 square foot absorbent sidewall area per bedroom. Inlet to be 4 1/2 feet and maximum depth of 11 1/2 ft. Locate dry well 85 feet from the left side line and 80 feet from the front lot line as seen when facing the property from Flamewood Dr. Trench to be 38 feet long with 266 square feet absorbent sidewall area. Inlet to be 4 1/2 feet and maximum depth of 11 1/2 feet. Start the trench after a 5 foot earth buffer with the dry well and run it on level ground, towards the right side line the necessary distance.

NOTE: CALL FOR INSPECTION OF TRENCH BEFORE PLACING STONE IN TRENCH.

NOTE: ALL PIPE FROM HOUSE TO DISPOSAL AREA MUST BE CAST IRON. PERMIT VOID AFTER THREE YEARS.

PLANS APPROVED BY Frank Skinner DATE 11/5/76

NOTE: ANSTALL STAND PIPES ON SEPTIC TANK AND DRY WELL. STAND PIPES MUST BE 6 INCHES


FILL SEPTIC TANK AND DISTRIBUTION BOX WITH WATER BEFORE CALLING FOR AN INSPECTION. COVER NO WORK UNTIL INSPECTED AND APPROVED.

IN DIAMETER. CAST IRON, CONCRETE OR TERRA COTTA ACCEPTEDD

NEITHER THE HOWARD COUNTY COMMISSIONERS NOR THE HEALTH DEPARTMENT IS RESPONSIBLE FOR THE SUCCESSFUL OPERATION OF ANY SYSTEM.

*dry well trench 100' long - depth & location same as above
follow contours of ground
* two inspections*

22005

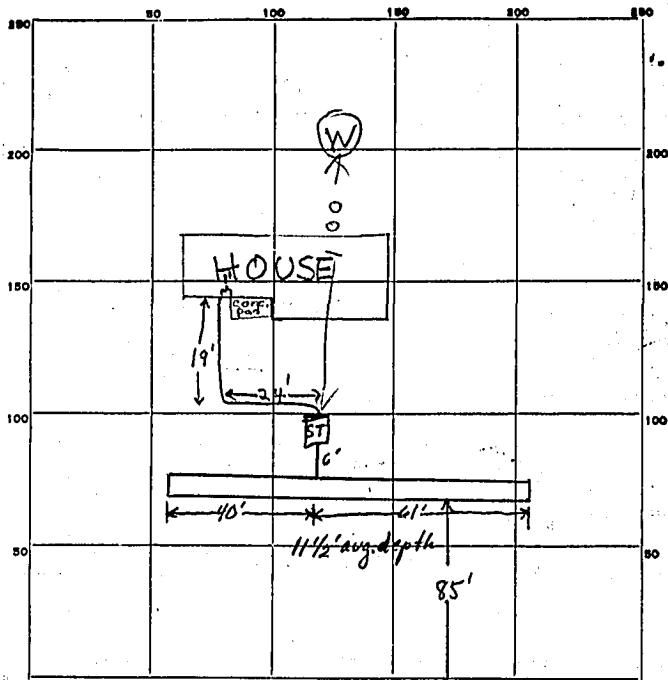

INDICATE NORTH. - NAME ADJOINING ROADWAY'S BASE LINE.
Flamewood Drive

PERMIT CARD NO

SEPTIC TANK, LEVEL 1250 CLEANOUTS ST-OK

DISTRIBUTION BOX, LEVEL _____

DITCH
 TRENCH FIELD, DEPTH 1 1/2 FT. TRENCH WIDTH 2 FT.

GRAVEL DEPTH 8 1/2 ft TOTAL LENGTH 101 FT.
 NUMBER OF TRENCHES 1 TOTAL BOTTOM AREA 958
ONE SIDE

SEEPAGE PITS, INSIDE DIAMETER _____ FT. DEPTH BELOW INLET _____ FT.

ABSORBENT AREA _____ SQ. FT.

REMARKS ok to add stone, 8/3/77 TSD 8/4/77 560 SQ FT
REQUIRED FOR 4 BR. OR TO COVER TANK
& DITCH BIT

DATE SYSTEM APPROVED 11/22/77 INSPECTOR J. Skinner