

2/17/97  
2:00.

# APPLICATION

PERCOLATION TESTING

A 59256

P \_\_\_\_\_

HOWARD COUNTY HEALTH DEPARTMENT  
BUREAU OF ENVIRONMENTAL HEALTH  
3525-H ELLICOTT MILLS DRIVE/ELLICOTT CITY, MARYLAND 21043  
TELEPHONE: 313-2640

DISTRICT \_\_\_\_\_

DATE 12.10.97

TO: THE COUNTY HEALTH OFFICER  
ELLICOTT CITY, MARYLAND

12/8/97  
Preview OK - existing  
house on prop to be  
demolished - zoning gave  
OK to build while constructing  
EK soils - may  
need wet season  
ALM

I HEREBY APPLY FOR THE NECESSARY TEST PRIOR TO APPLICATION FOR PERMIT TO CONSTRUCT (OR RECONSTRUCT) A SEWAGE DISPOSAL SYSTEM.

PROPERTY OWNER Dorsey Prop

ADDRESS \_\_\_\_\_ PHONE \_\_\_\_\_

AGENT OR PROSPECTIVE BUYER Beverly L. Dorsey

ADDRESS 14846 Bushy Park Road PHONE (410) 442-9718  
Woodbine, MD 21797

PROPERTY LOCATION:

SUBDIVISION N/A LOT NO. N/A

ROAD AND DESCRIPTION 14816 Bushy Park Rd

TAX MAP 8 PARCEL # 215

SIZE OF LOT \_\_\_\_\_ TYPE BLDG. SFD  
(SINGLE FAMILY DWELLING OR COMMERCIAL)

THE SYSTEM INSTALLED UNDER THIS APPLICATION IS ACCEPTABLE ONLY UNTIL PUBLIC FACILITIES BECOME AVAILABLE. I FULLY UNDERSTAND THE FEE CONNECTED WITH THE FILING OF THIS PERC TEST APPLICATION IS NON-REFUNDABLE UNDER ANY CIRCUMSTANCES. I ALSO AGREE TO COMPLY WITH ALL M.O.S.H.A. REQUIREMENTS IN TESTING THIS LOT.

Beverly L. Dorsey  
(SIGNATURE OF APPLICANT)

APPROVED BY \_\_\_\_\_ FOR \_\_\_\_\_ DATE \_\_\_\_\_

DISAPPROVED BY \_\_\_\_\_ FOR \_\_\_\_\_ DATE \_\_\_\_\_

HOLD PENDING FURTHER TESTS \_\_\_\_\_

REASONS FOR REJECTION OR HOLDING \_\_\_\_\_

PERCOLATION TEST PLAT/PRELIMINARY PLAT - TITLE OR I.D. # \_\_\_\_\_ DATE \_\_\_\_\_

SITE DEVELOPMENT PLAN/FINAL PLAT - TITLE OR I.D. # \_\_\_\_\_ DATE \_\_\_\_\_

# THIS IS NOT A PERMIT



## HOWARD COUNTY HEALTH DEPARTMENT

Joyce M. Boyd, M.D., County Health Officer

December 9, 1997

Beverly L. Dorsey  
14846 Bushy Park Road  
Woodbine, Maryland 21797

RE: Percolation Test Date  
14816 Bushy Park Road  
Tax Map: 8 Parcel: 215

Dear Ms. Dorsey:

A percolation test date for the above reference property has been tentatively reserved for 10:00 a.m., Wednesday, December 17, 1997. To avoid cancellation of this test date, please submit test fees in the amount of \$225.

You will be responsible for having a contractor on-site to excavate test holes at the corners of proposed percolation area.

In the event of uncertain weather (i.e. precipitation or extremes of temperature), please contact this office prior to 9:00 a.m. to determine whether percolation testing can be performed on the above reserved date. If it is not feasible to perform the test, a new test date will be assigned.

Percolation test results can be expected within approximately 2 to 3 weeks.

Please call this office between 8:00 a.m. and 5:00 p.m., Monday through Friday, to confirm your acceptance of this percolation test date.

Thank you for your cooperation in this matter.

Very truly yours,

*Amy Mc Millen*

Amy Mc Millen, R.S.  
Water & Sewerage Program


am  
cc:file

PAID 12/10/97  
Perc cancelled  
12/17/97 - Bank wouldn't  
approve a loan  
for replacement  
of house  
AM

This plat is not intended for use in establishing property lines.

I hereby certify that I have examined the current Flood Insurance Rate Map (FIRM Map No: 240044 008B ) for the subject property and it does not lie in an area identified by The Secretary of Housing and Urban Development as having special flood or mud slide hazards.

*C. Brooke Miller*  
C. Brooke Miller, R.P.L.S. # 135

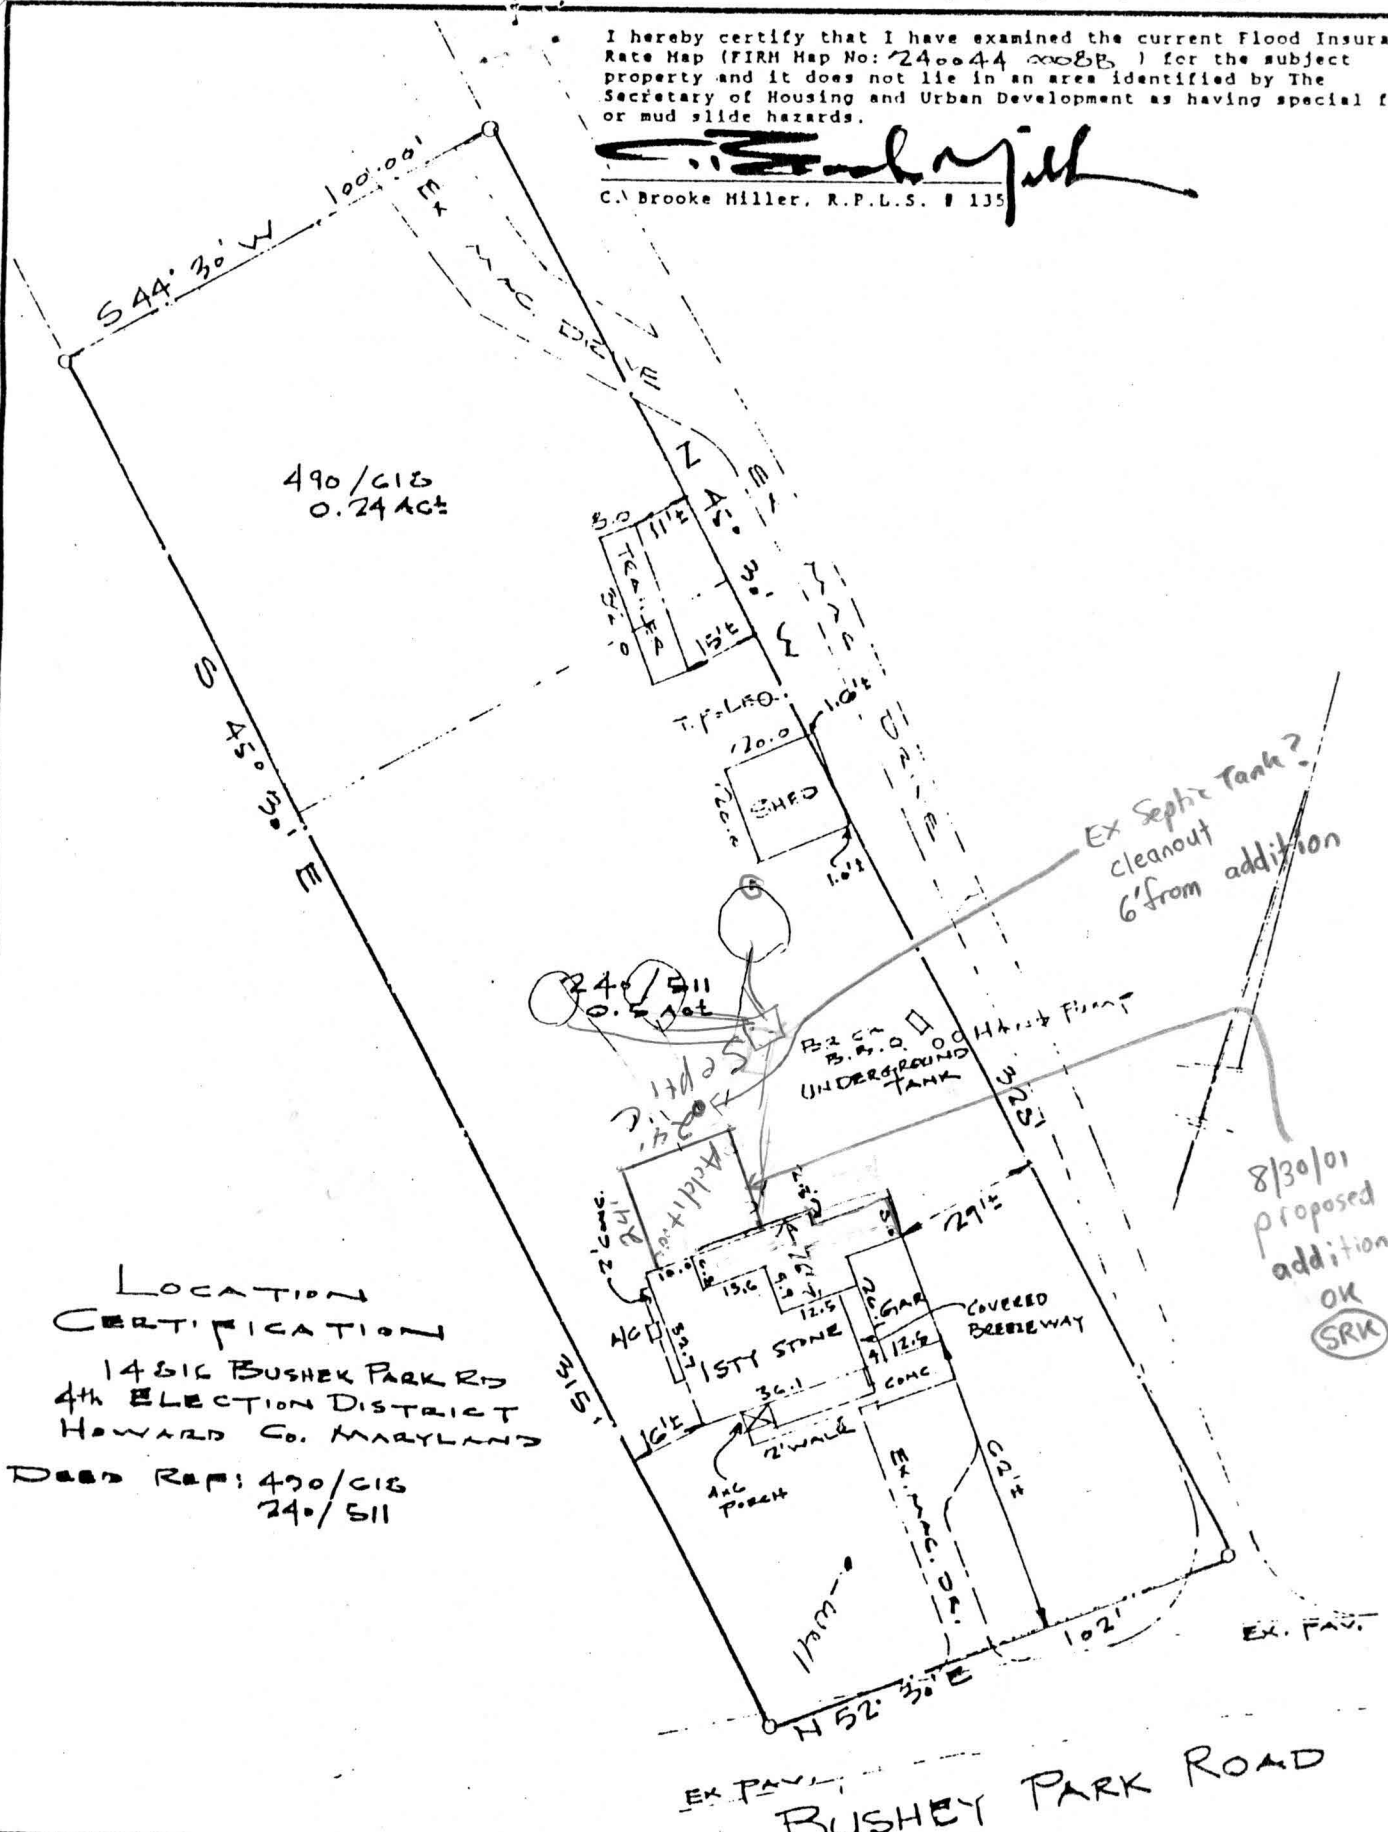

**LOCATION CERTIFICATION**  
 14516 BUSHEY PARK RD  
 4th ELECTION DISTRICT  
 HOWARD CO. MARYLAND  
 DEED REF: 490/612  
 240/511

**SMITH MILLER ASSOCIATES, INC.**

Registered Land Surveyors  
13054 Tarragon Road  
Reisterstown, Maryland 21136  
(301) 833-5905

August 25, 1989

Scale: 1"=40'




I HEREBY CERTIFY THAT I HAVE LOCATED THE IMPROVEMENTS BY A TRANSIT - TAPE SURVEY AND THAT UNLESS OTHERWISE SHOWN THERE ARE NO ENCROACHMENTS EITHER WAY ACROSS LOT LINES AND NO VIOLATIONS OF ANY SET BACK RESTRICTIONS.

*C. Brooke Miller*  
C. BROOKE MILLER  
PROPERTY LINE SURVEYOR #135

This plat is not intended for use in establishing property lines.

I hereby certify that I have examined the current Flood In-  
Rate Map (FIRM Map No: 240044 008B ) for the subject  
property and it does not lie in an area identified by The  
Secretary of Housing and Urban Development as having speci-  
or mud slide hazards.

*C. Brooke Miller*  
C. Brooke Miller, R.P.L.S. # 135

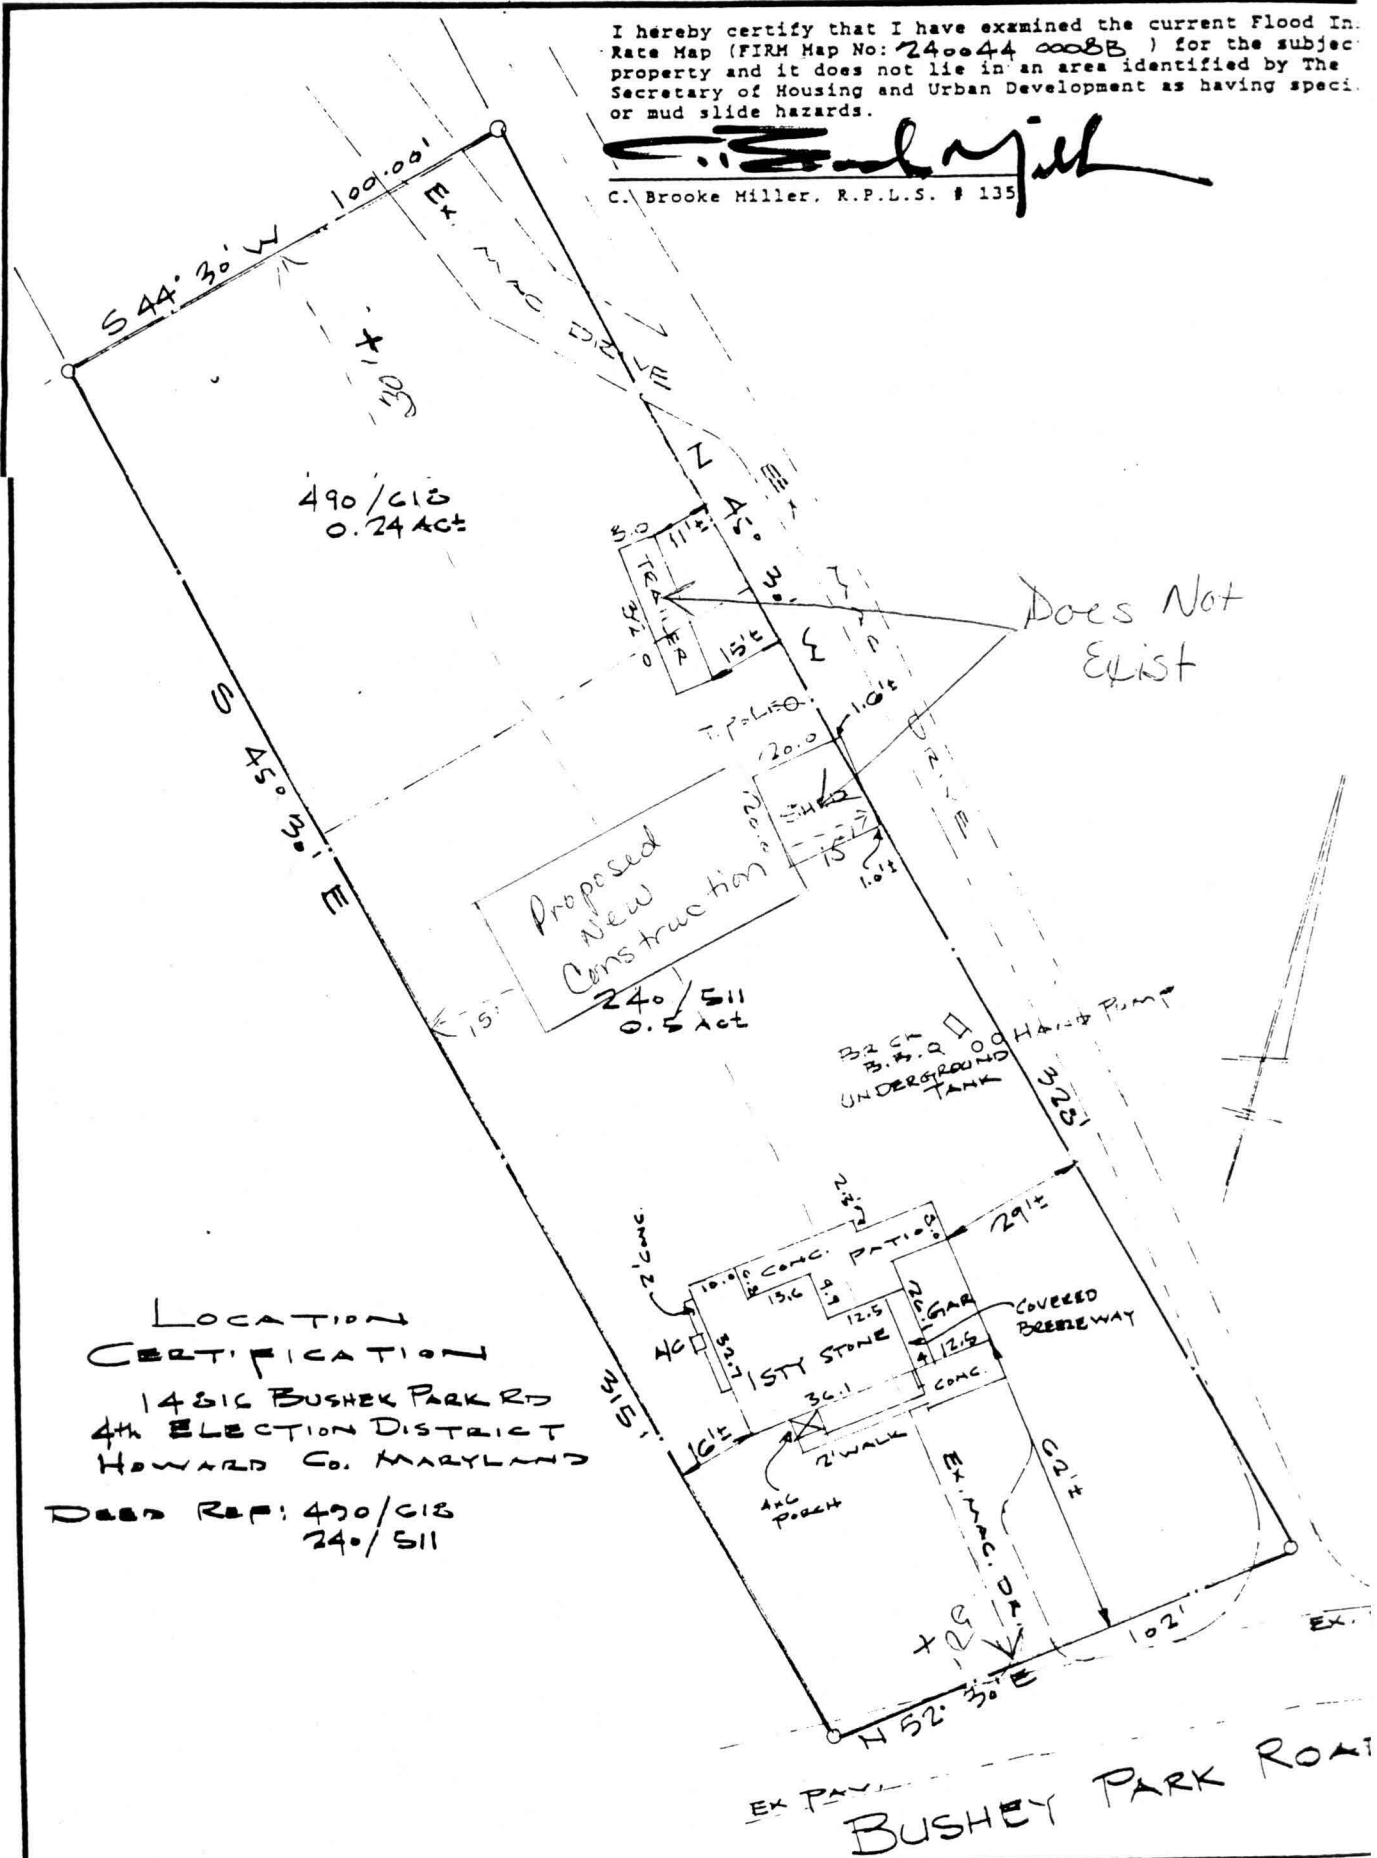

LOCATION  
CERTIFICATION

14516 BUSHEY PARK RD  
4th ELECTION DISTRICT  
HOWARD CO. MARYLAND

DEED REF: 490/613  
240/511



Existing house to be demolished - not imminent -  
for owners son - and replaced by a handicap accesable  
modular home. - Owner living w/ mother - next door -  
until modular can be built.

A McMillen