

APPLICATION

A 03111

SEWAGE DISPOSAL TESTING

P _____

MARYLAND STATE DEPARTMENT OF HEALTH

HOWARD COUNTY

750 Gallon Tank

ELLICOTT CITY

Dry Well - 300 sq ft sidewall area below the inlet

DISTRICT 4

DATE 10/25/60

Builder - Nationwide Homes - La. 6-7555

Place the dry well about 110 ft to 130 ft from Bushy Park Road and about 30 ft to 50 ft from the barbed wire fence on the sideline.

TO: THE COUNTY HEALTH OFFICER
ELLICOTT CITY, MARYLAND

I, HEREBY, APPLY FOR THE NECESSARY TESTS IN ORDER TO CONSTRUCT (OR RECONSTRUCT) A SEWAGE DISPOSAL SYSTEM.

PROPERTY OWNER Dukes, Pearly

ADDRESS West Friendship PHONE Glenwood 267 W 1

PROPERTY LOCATION:

SUBDIVISION _____ LOT NO. _____

ROAD AND DESCRIPTION Bushy Park Road - approx. 100 ft. to right of Cementery Rd.

OCCUPANT _____ PHONE _____

PERSON TO CONSTRUCT SYSTEM _____

ADDRESS _____ PHONE _____

SIZE OF LOT 3 acres TYPE BLDG. 3
NUMBER OF BEDROOMS

IF NOT SINGLE RESIDENCE DESCRIBE _____

SIGNATURE OF APPLICANT Nationwide Home Inc. by Wm. Shackelford.


APPROVED BY Raymond Hodges FOR Dry Well DATE 12/7/60
(KIND OF SYSTEM)

REJECTED BY _____ FOR _____ DATE _____
(KIND OF SYSTEM)

HOLD PENDING FURTHER TESTS 10-27-60 DATE _____

REASONS FOR REJECTION OR HOLDING 10-27-60 Holes not dug in Holes 1 and 2 on 11-3-60
didn't pass JH.

THIS IS NOT A PERMIT

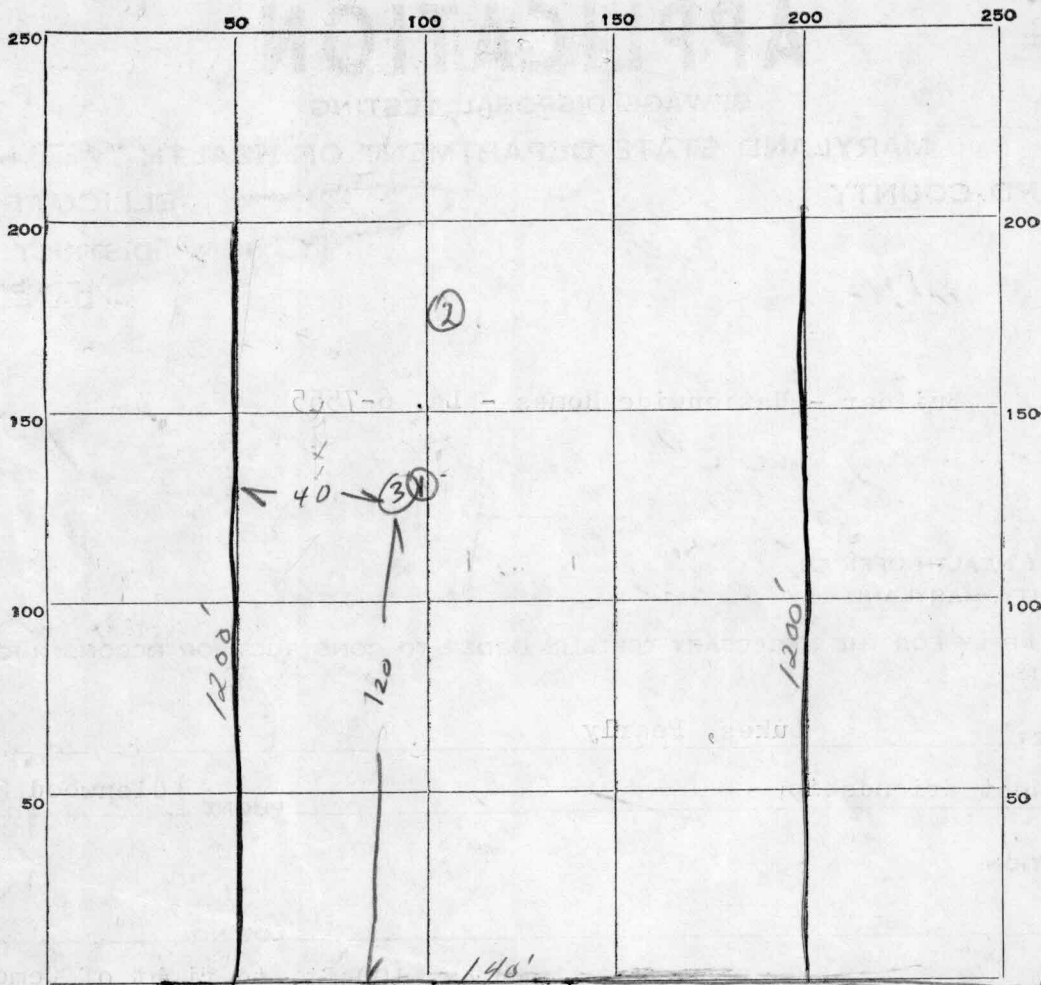

INDICATE NORTH. - NAME ADJOINING ROADWAY AS BASE LINE.

BUSHY PARK ROAD

TO RT #144

DATE	TEST NO.	DEPTH	PRE-WET		TEST - 1" DROP		TIME
			START	STOP	START	STOP	
11-3-60	1	3 FT	12:57	Slow Perc			
1	2	1	1:12	No Perc			
12/7/60	3	9	12 29	1234	1234	1240	6 min

SOIL AUGER FINDING

TESTED BY

J. Hennigan 12/7/60 Raymond Hodges

REMARKS

11-3-60

12/7/60 W. C. Shuckford

LOT NO.